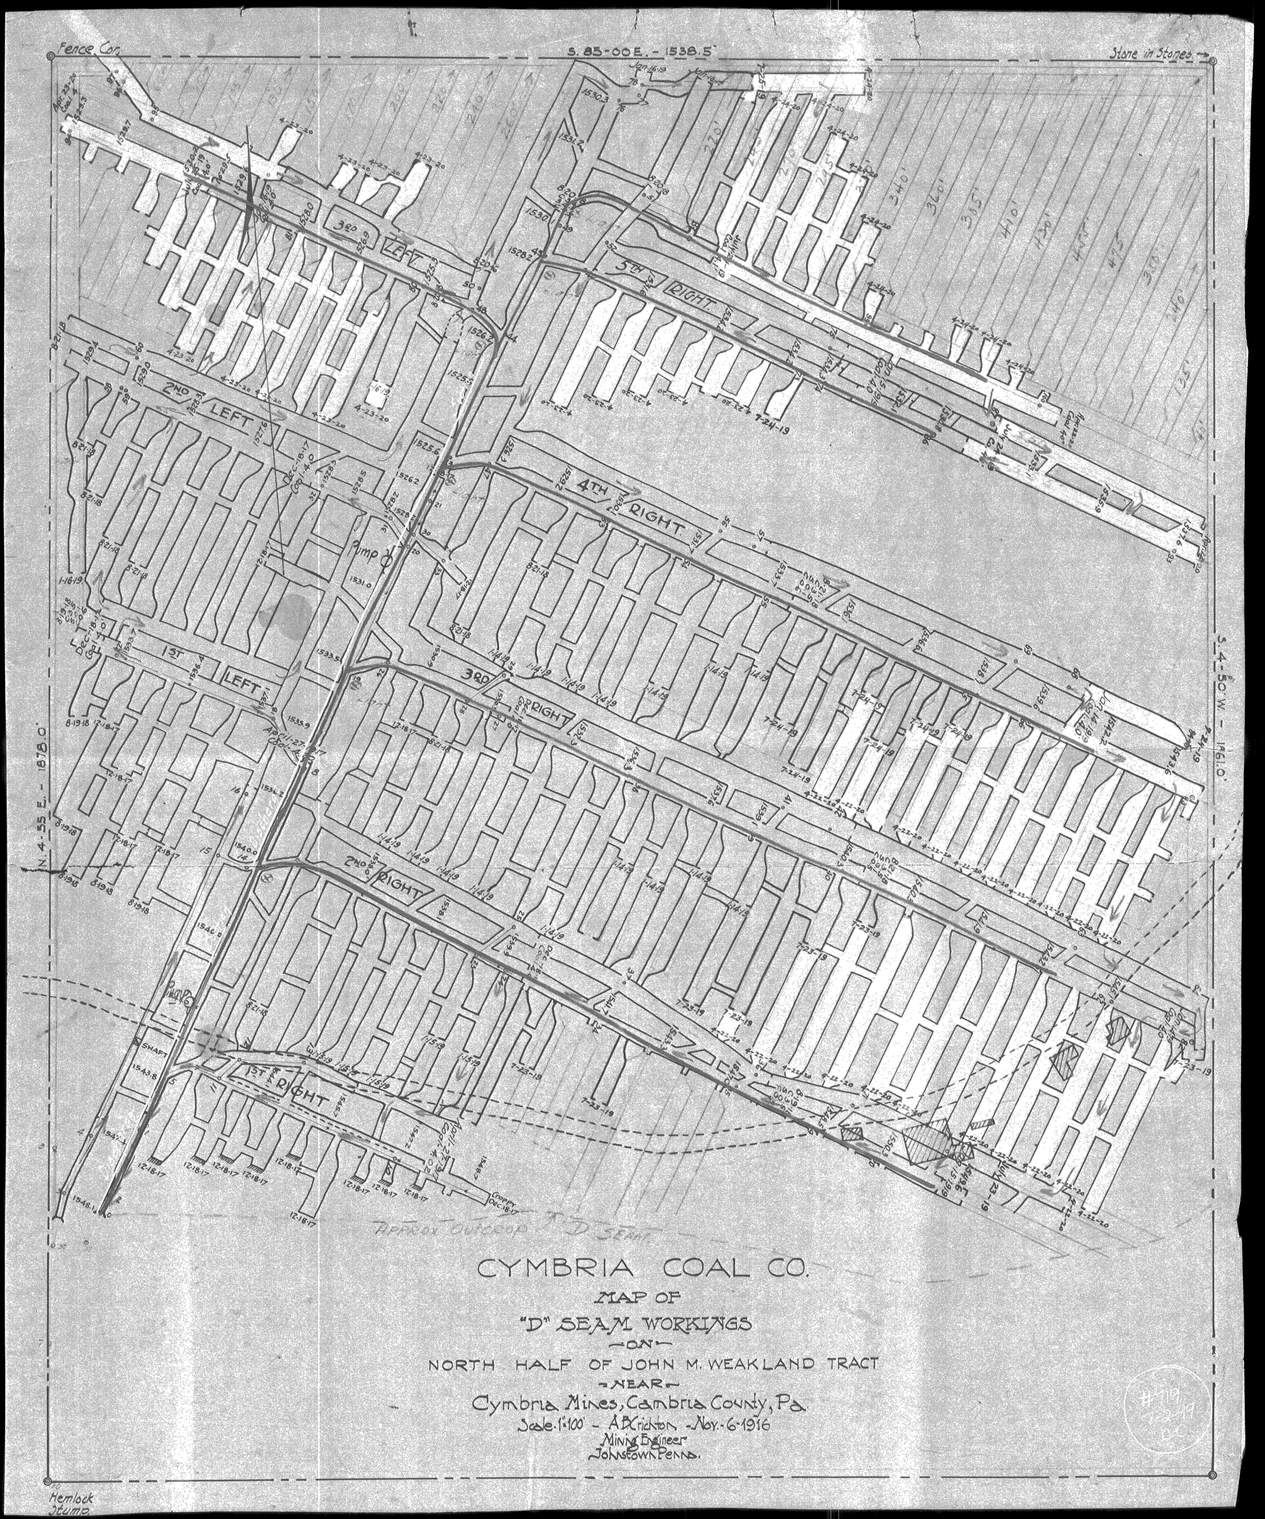

CYMBRIA COAL CO.

MAP OF

"D" SEAM WORKINGS

—ON—

NORTH HALF OF JOHN M. WEAKLAND TRACT

—NEAR—

Cymbria Mines, Cambria County, Pa.

Scale 1"=100' - A.B. Crichton - Nov.-6-1916

Mining Engineer

Johnstown Penna.

#719
7-2-99
D.C.