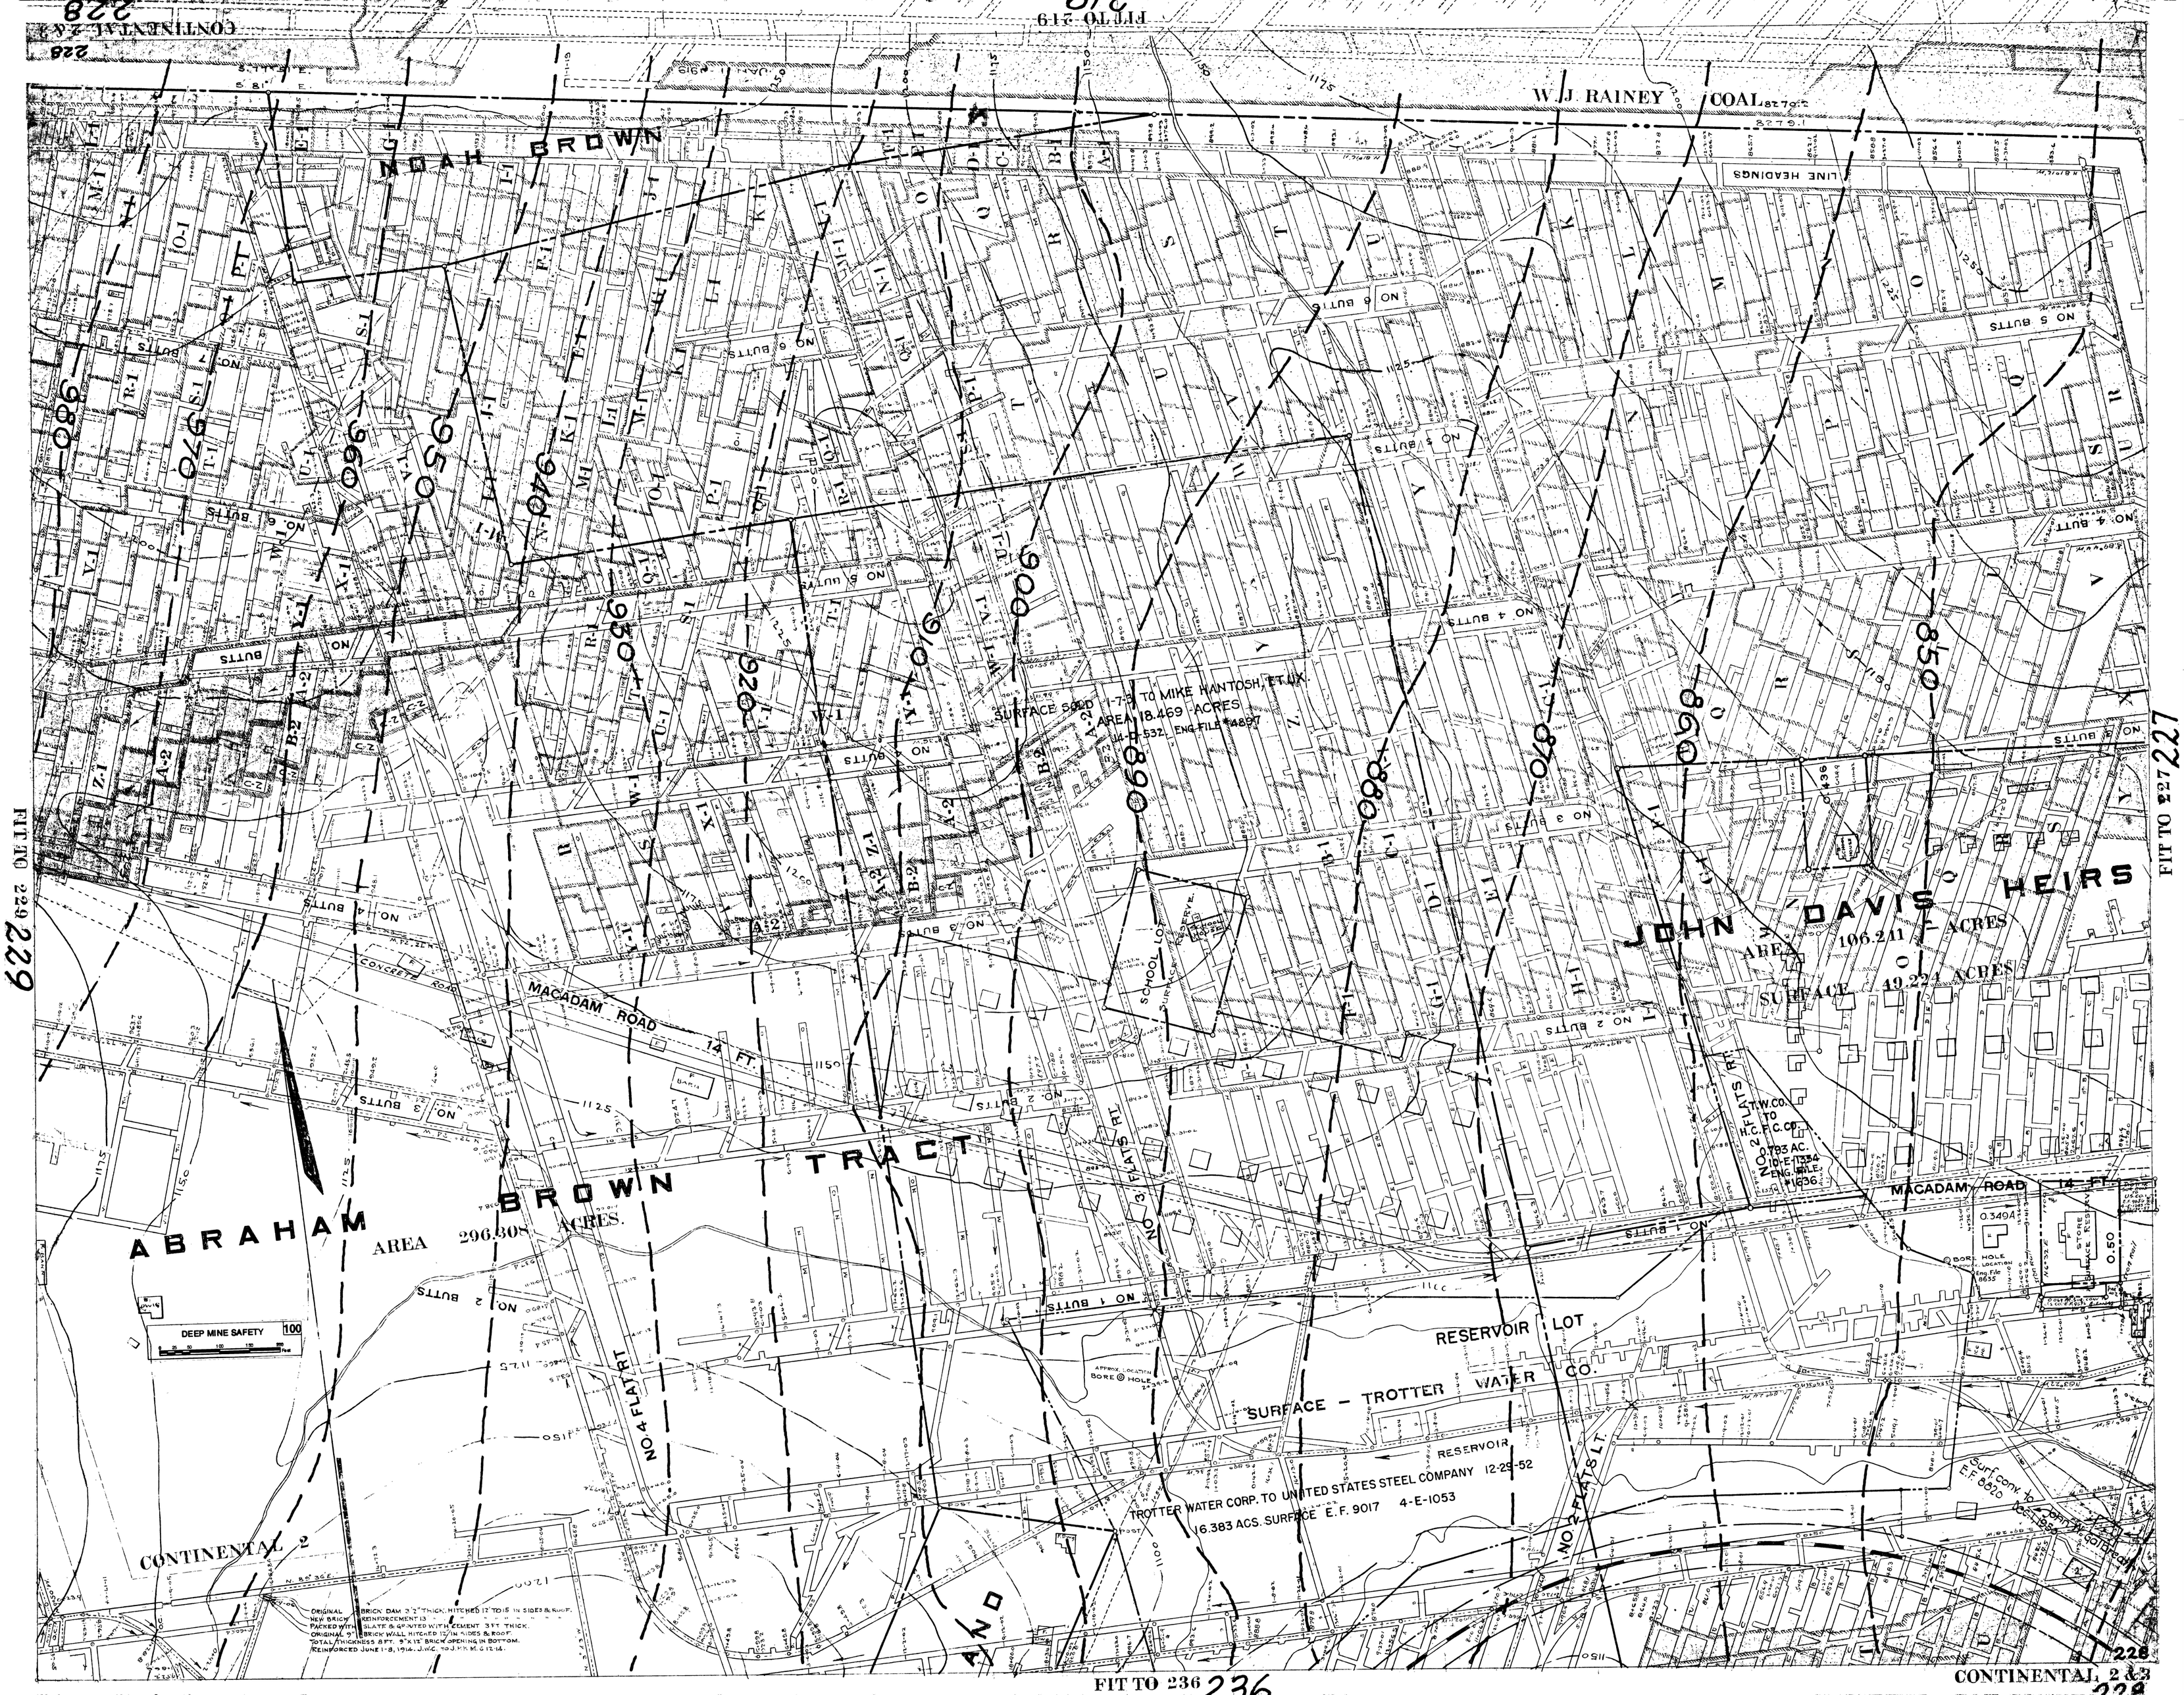

CONTINENTAL 2 & 3
228
FIT TO 219
W. J. RAINEY COAL
NOAH BROWN
LINE HEADINGS
NO 6 BUTTS
NO 5 BUTTS
NO 4 BUTTS
NO 3 BUTTS
NO 2 BUTTS
NO 1 BUTTS
980
970
960
950
940
930
920
910
900
890
880
870
860
850
SURFACE SOLD 1-7-3 TO MIKE HANTOSH, ET UX.
AREA 18.469 ACRES
14-D-532, ENG FILE #4897
JOHN DAVIS HEIRS
AREA 106.241 ACRES
SURFACE 49.224 ACRES
MACADAM ROAD 14 FT.
CONCRETE ROAD
SCHOOL LOT
NO 3 FLATS RT.
NO 2 FLATS RT.
T.W.CO. TO H.C.F.C.CO.
0.793 AC.
10-E-1334
ENG. FILE #1636
MACADAM ROAD 14 FT.
ABRAHAM BROWN TRACT
AREA 296.308 ACRES.
DEEP MINE SAFETY 100
NO 4 FLAT RT
RESERVOIR LOT
SURFACE - TROTTER WATER CO.
RESERVOIR
TROTTER WATER CORP. TO UNITED STATES STEEL COMPANY 12-29-52
16.383 ACS. SURFACE E.F. 9017 4-E-1053
NO 2 FLATS LT.
CONTINENTAL 2
ORIGINAL BRICK DAM 3'2" THICK, HITCHED 12" TO 15" IN SIDES & ROOF.
NEW BRICK REINFORCEMENT 13"
PACKED WITH SLATE & GROUTED WITH CEMENT 3 FT THICK.
ORIGINAL 9" BRICK WALL HITCHED 12" IN SIDES & ROOF.
TOTAL THICKNESS 8 FT. 9"X12" BRICK OPENING IN BOTTOM.
REINFORCED JUNE 1-8, 1914. J.W.C. TO J.H.K.M.G. 12-14.
FIT TO 229
229
FIT TO 227
227
FIT TO 236
236
CONTINENTAL 2 & 3
228