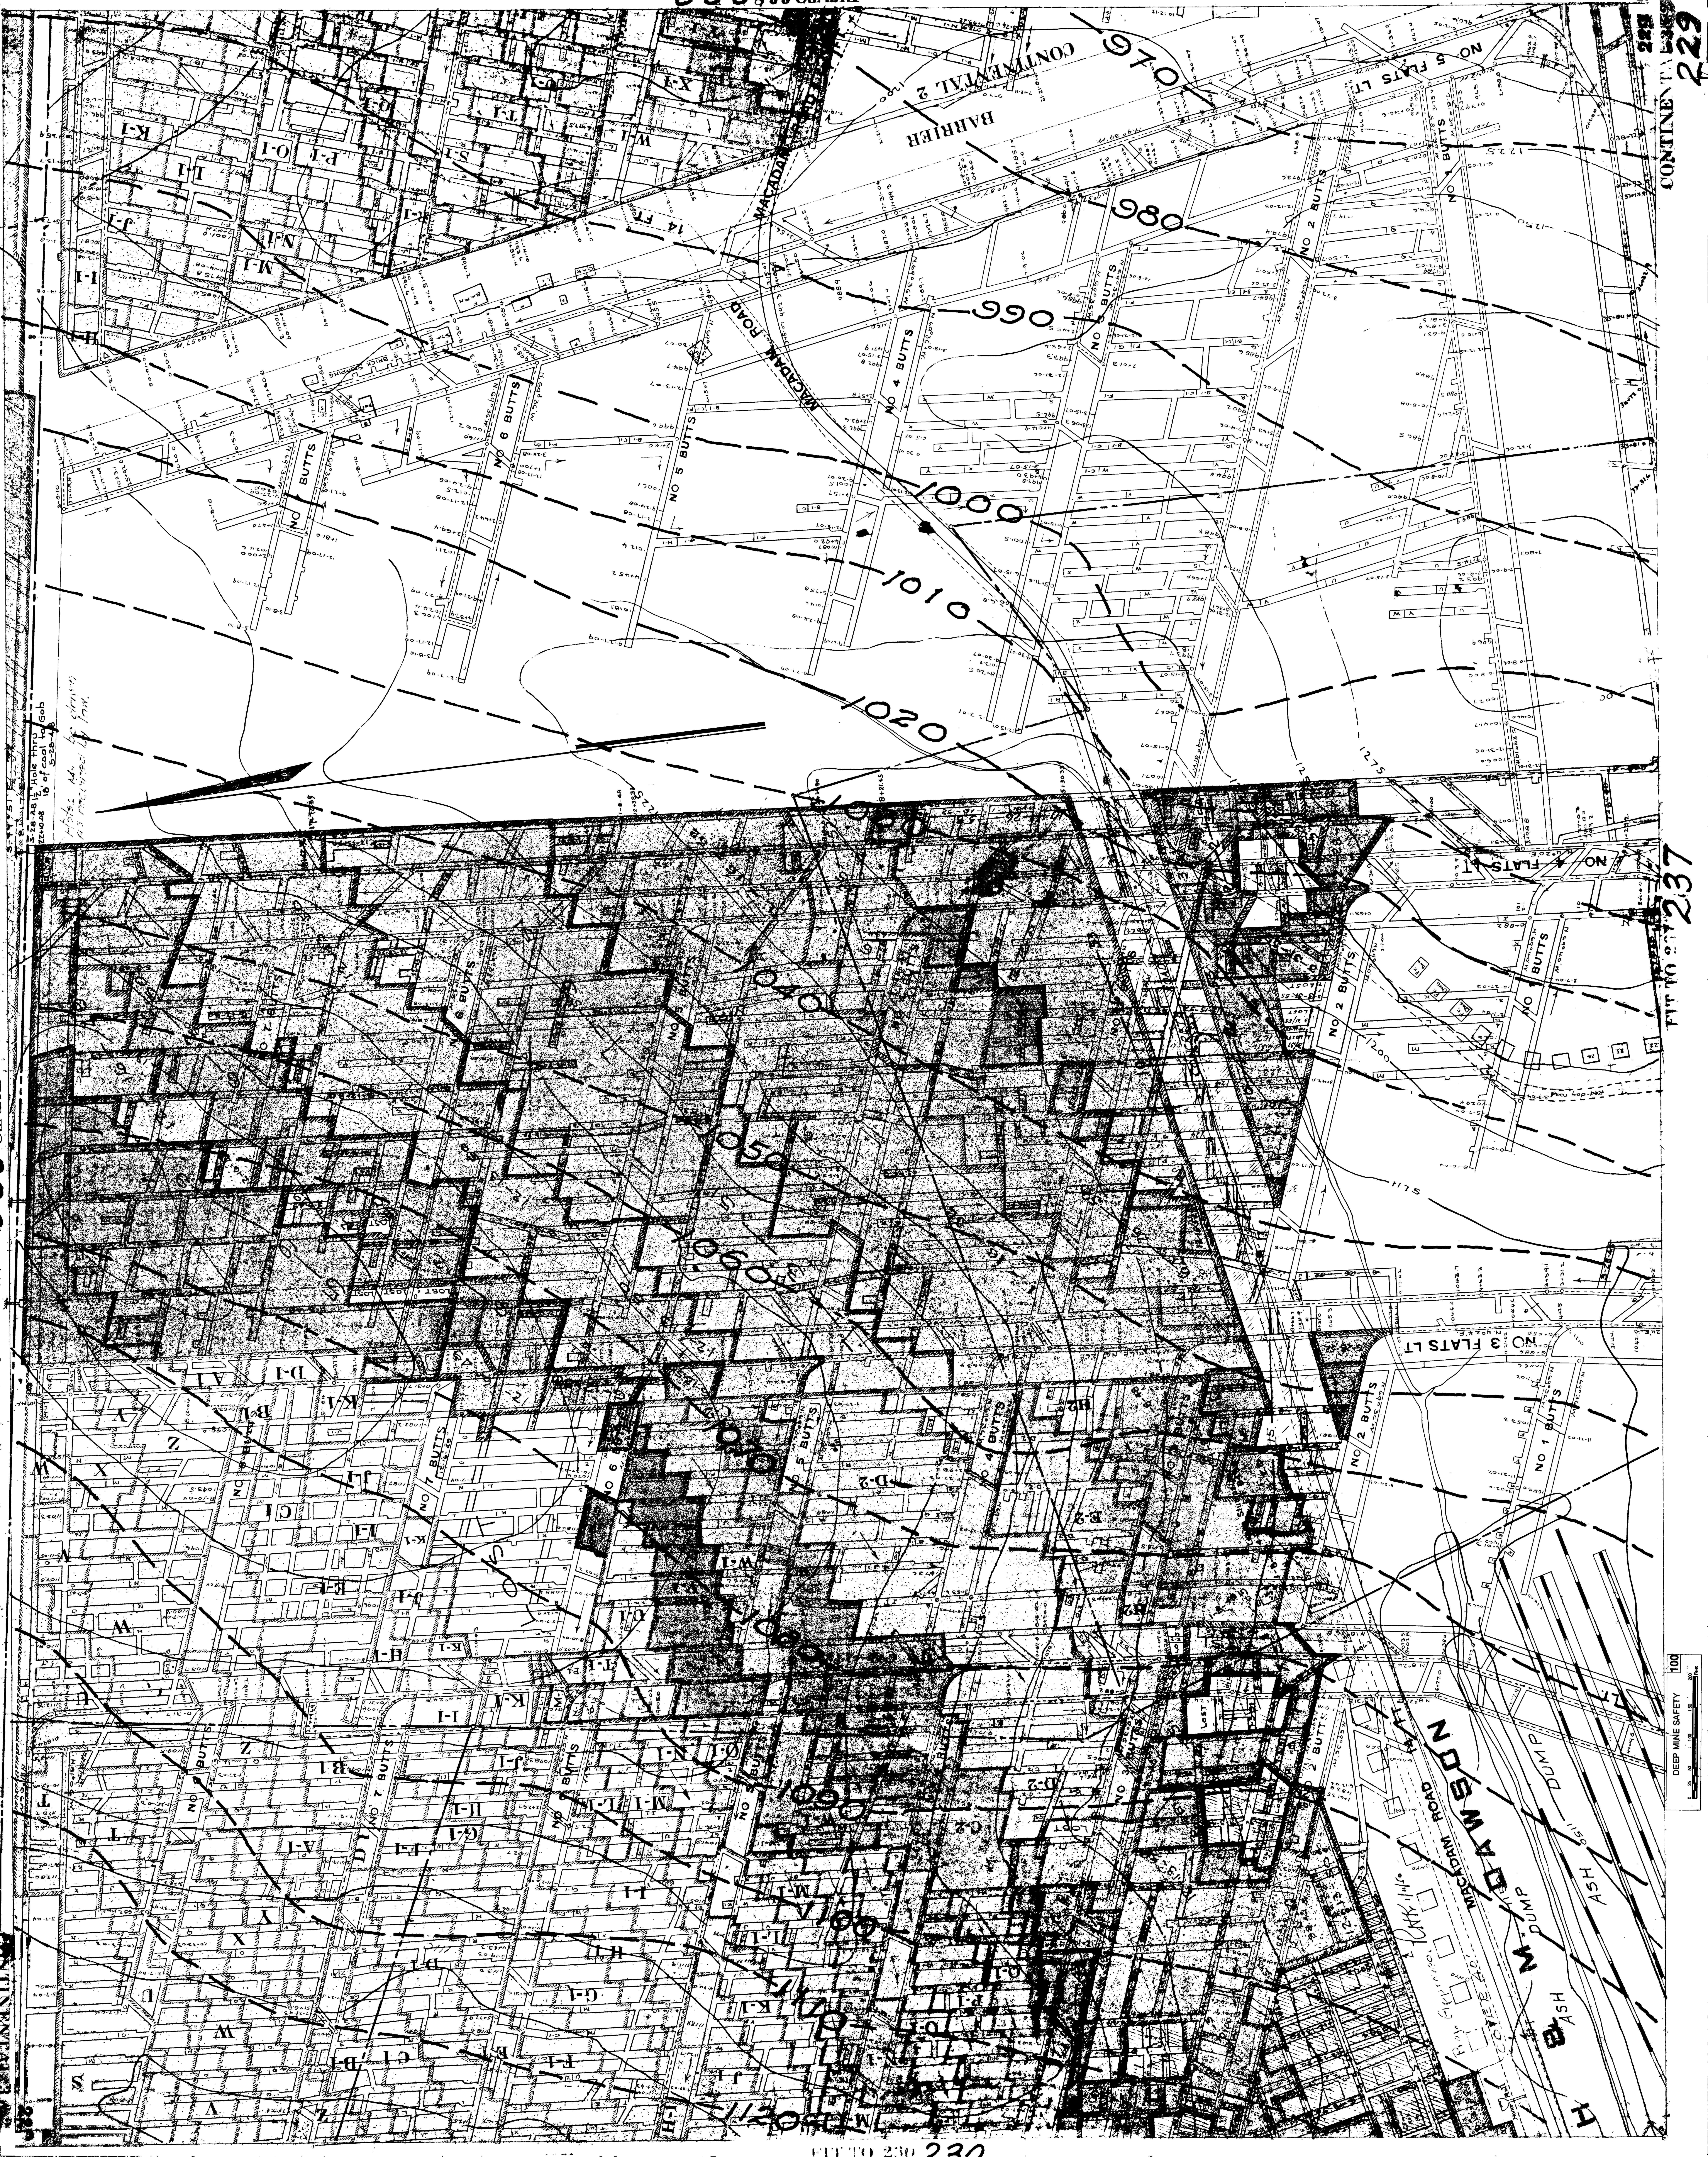
FIT TO 228 228
CONTINENTAL 229
CONTINENTAL 2
BARRIER
NO 5 FLATS LT
MACADAM ROAD
14 FT
NO 2 BUTTS
NO 3 BUTTS
NO 4 BUTTS
NO 5 BUTTS
NO 6 BUTTS
NO 7 BUTTS
NO 4 FLATS LT
FIT TO 237 237
NO 3 FLATS LT
NO 1 BUTTS
970
980
990
1000
1010
1020
1040
1050
1060
1070
1080
1090
1100
1110
1120
1175
1200
1225
1275
M. DAWSON
DUMP
ASH
DEEP MINE SAFETY
100
FIT TO 230 230