FIT TO 236 236

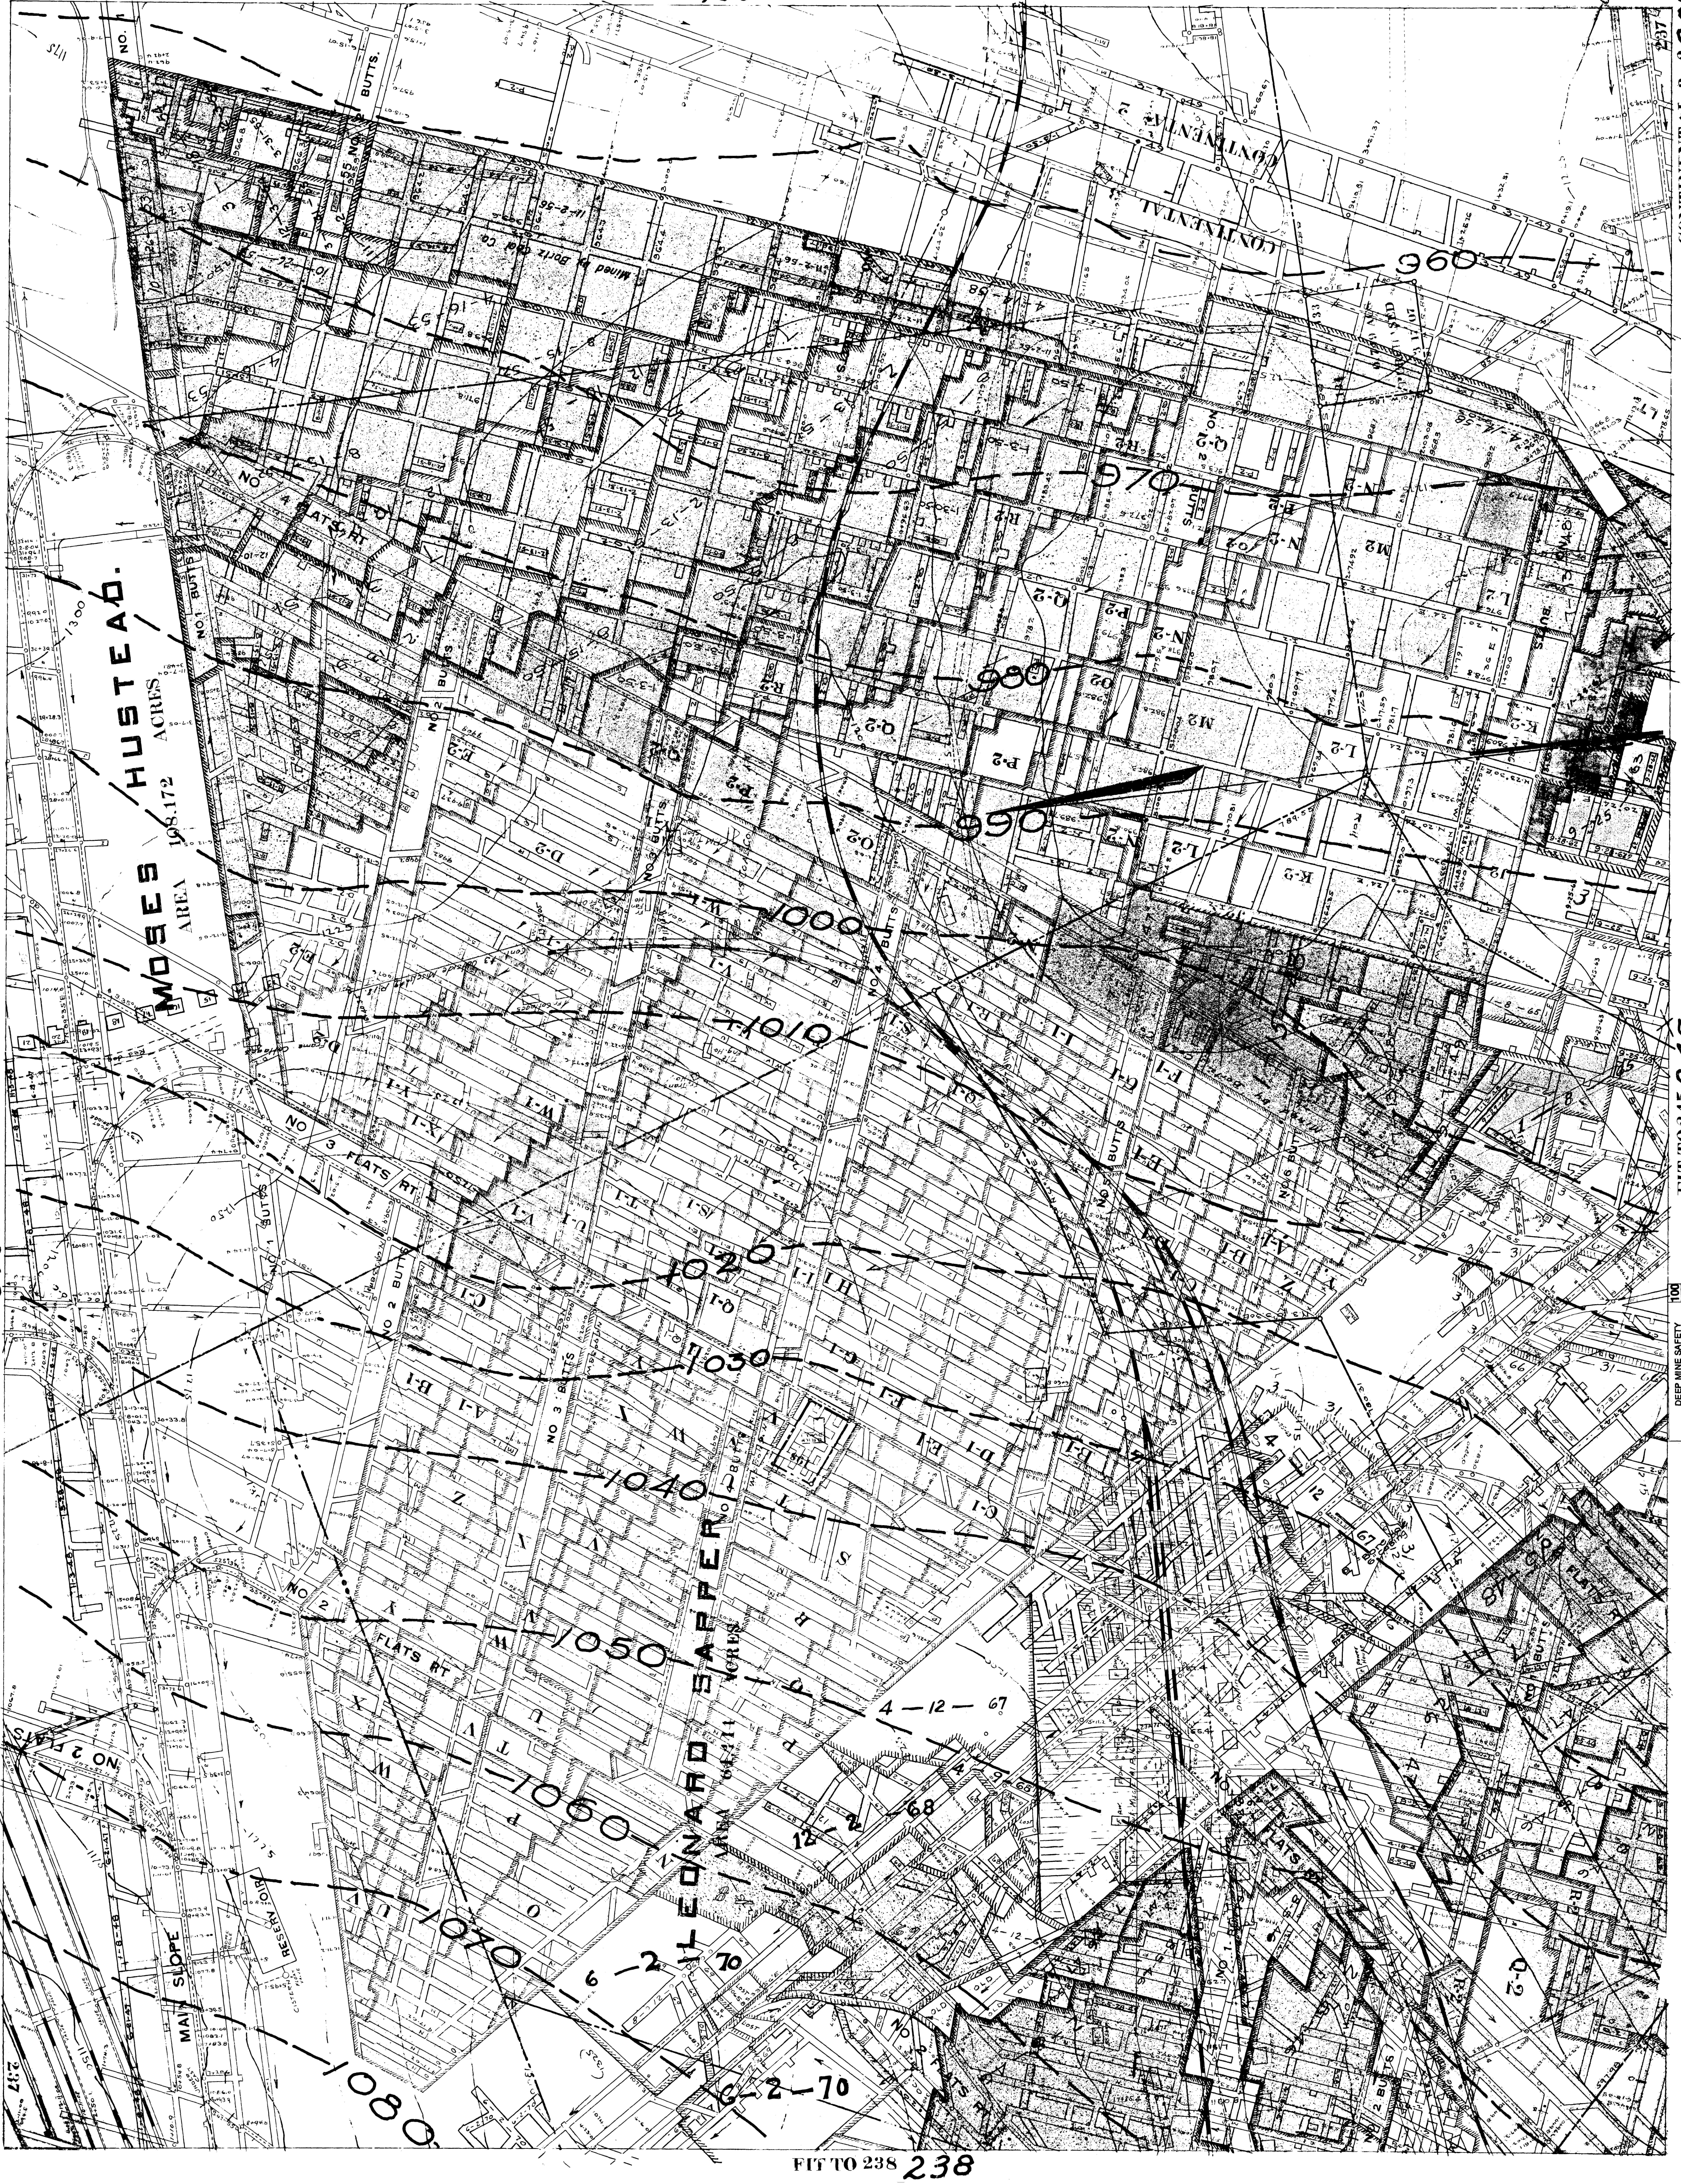
MOSES HUSTEAD AREA 108.172 ACRES
LEONARD SAPPER AREA 64.411 ACRES
CONTINENTAL
CONTINENTAL 2
Mined by Bortz Coal Co.
960
970
980
990
1000
1010
1020
1030
1040
1050
1060
1070
1080
4-12-67
12-2-68
6-2-70
6-2-70
NO 4 FLATS RT
NO 3 FLATS RT
NO 2 FLATS RT
NO 2 FLATS
NO 1 BUTTS
NO 2 BUTTS
NO 3 BUTTS
NO 4 BUTTS
NO 5 BUTTS
NO 6 BUTTS
55 NO 2 BUTTS
MAIN SLOPE
RESERVOIR
1300
1250
1225
1175
DEEP MINE SAFETY
100

CONTINENTAL 3-2 237

FIT TO 245 245

FIT TO 229 229

CONTINENTAL 3-2 237

FIT TO 238 238