


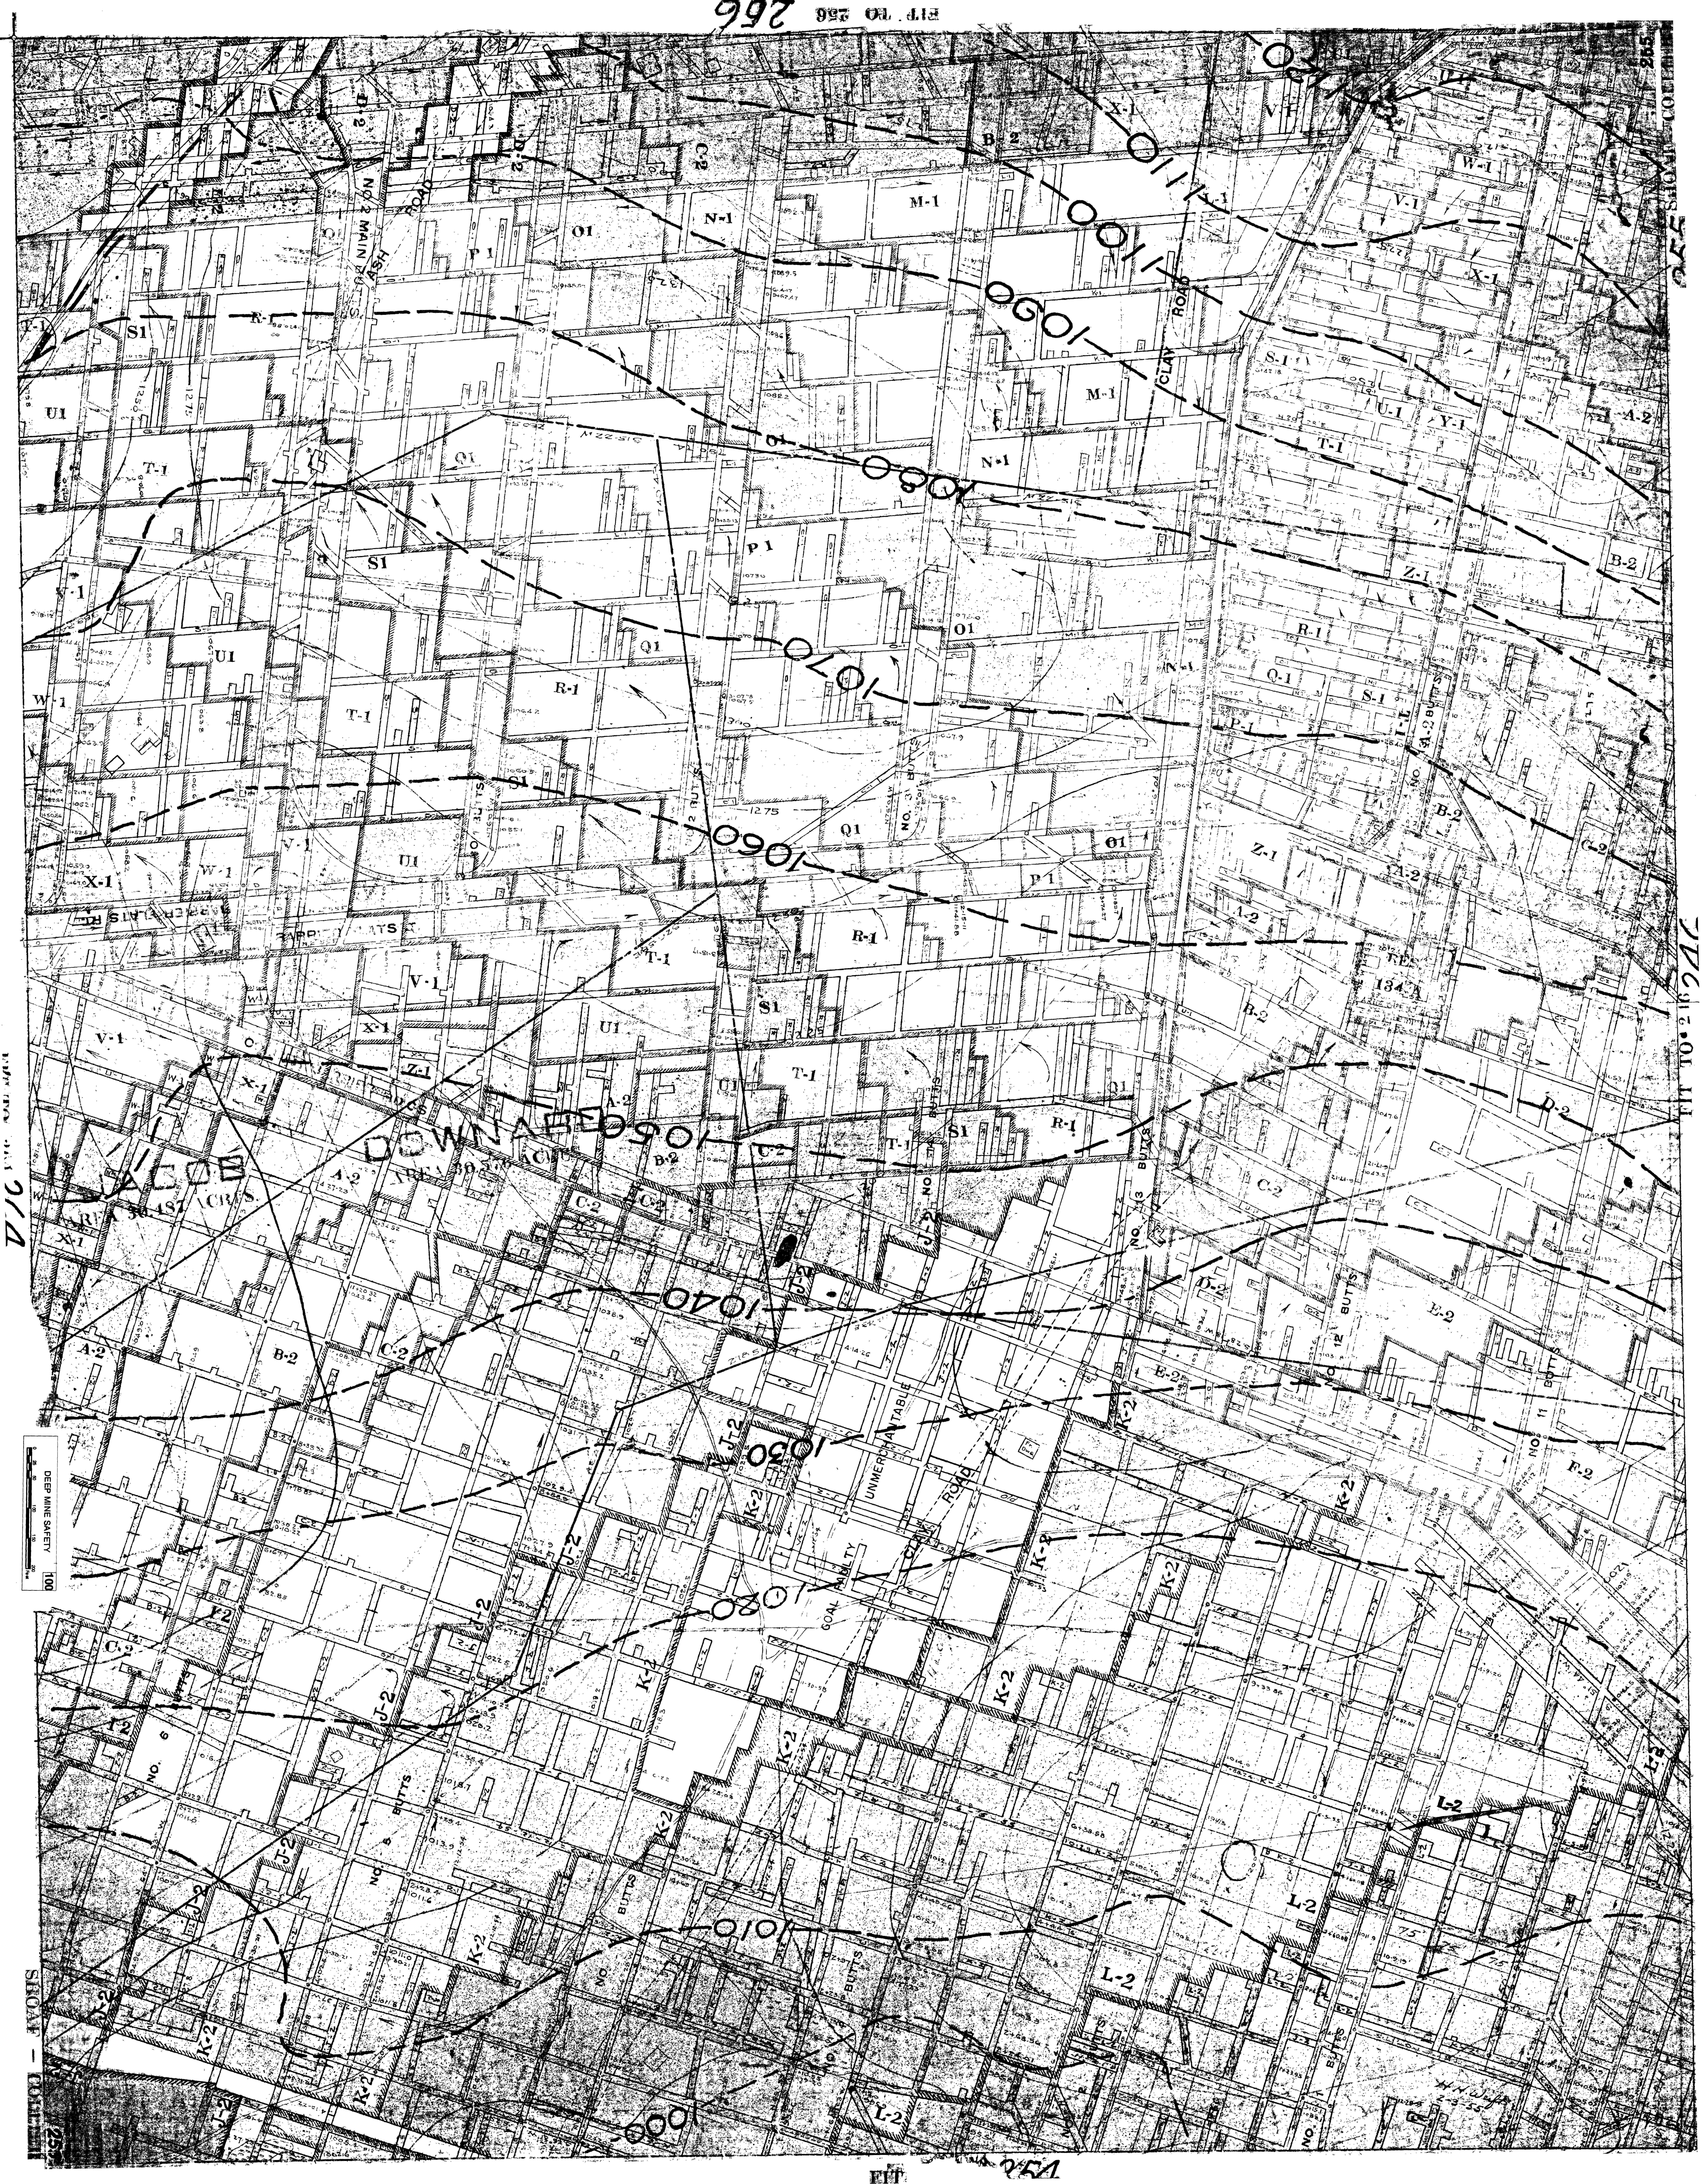

256 256 256

