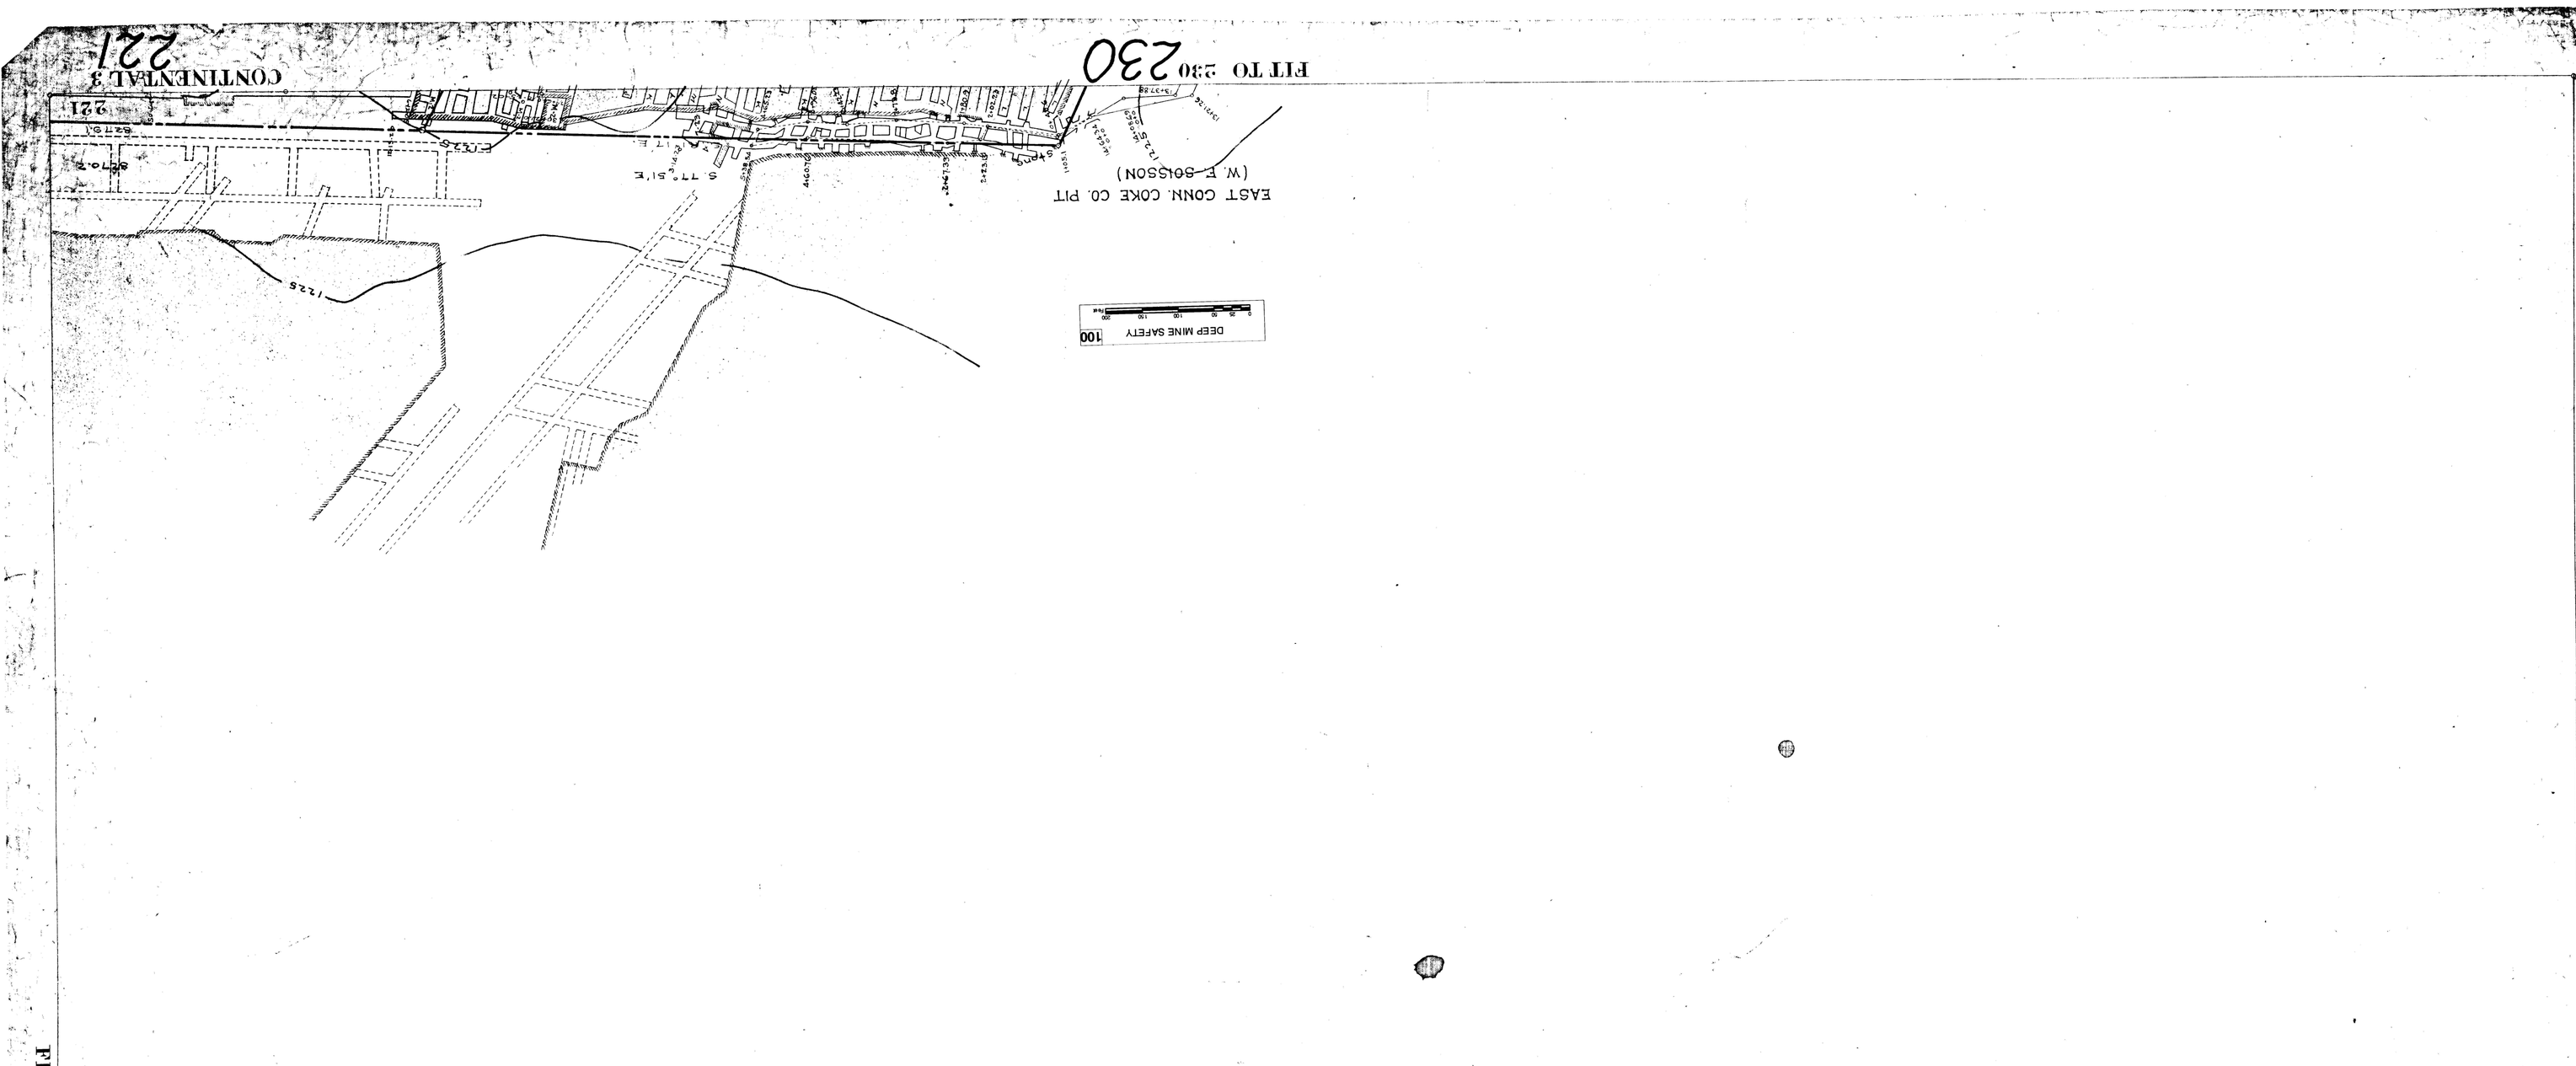
FIT TO 230
230
CONTINENTAL 3
221
EAST CONN. COKE CO. PIT
(W. E. SOLSSON)
S 77° 51' E
1225
DEEP MINE SAFETY
100
FIT TO 220
220