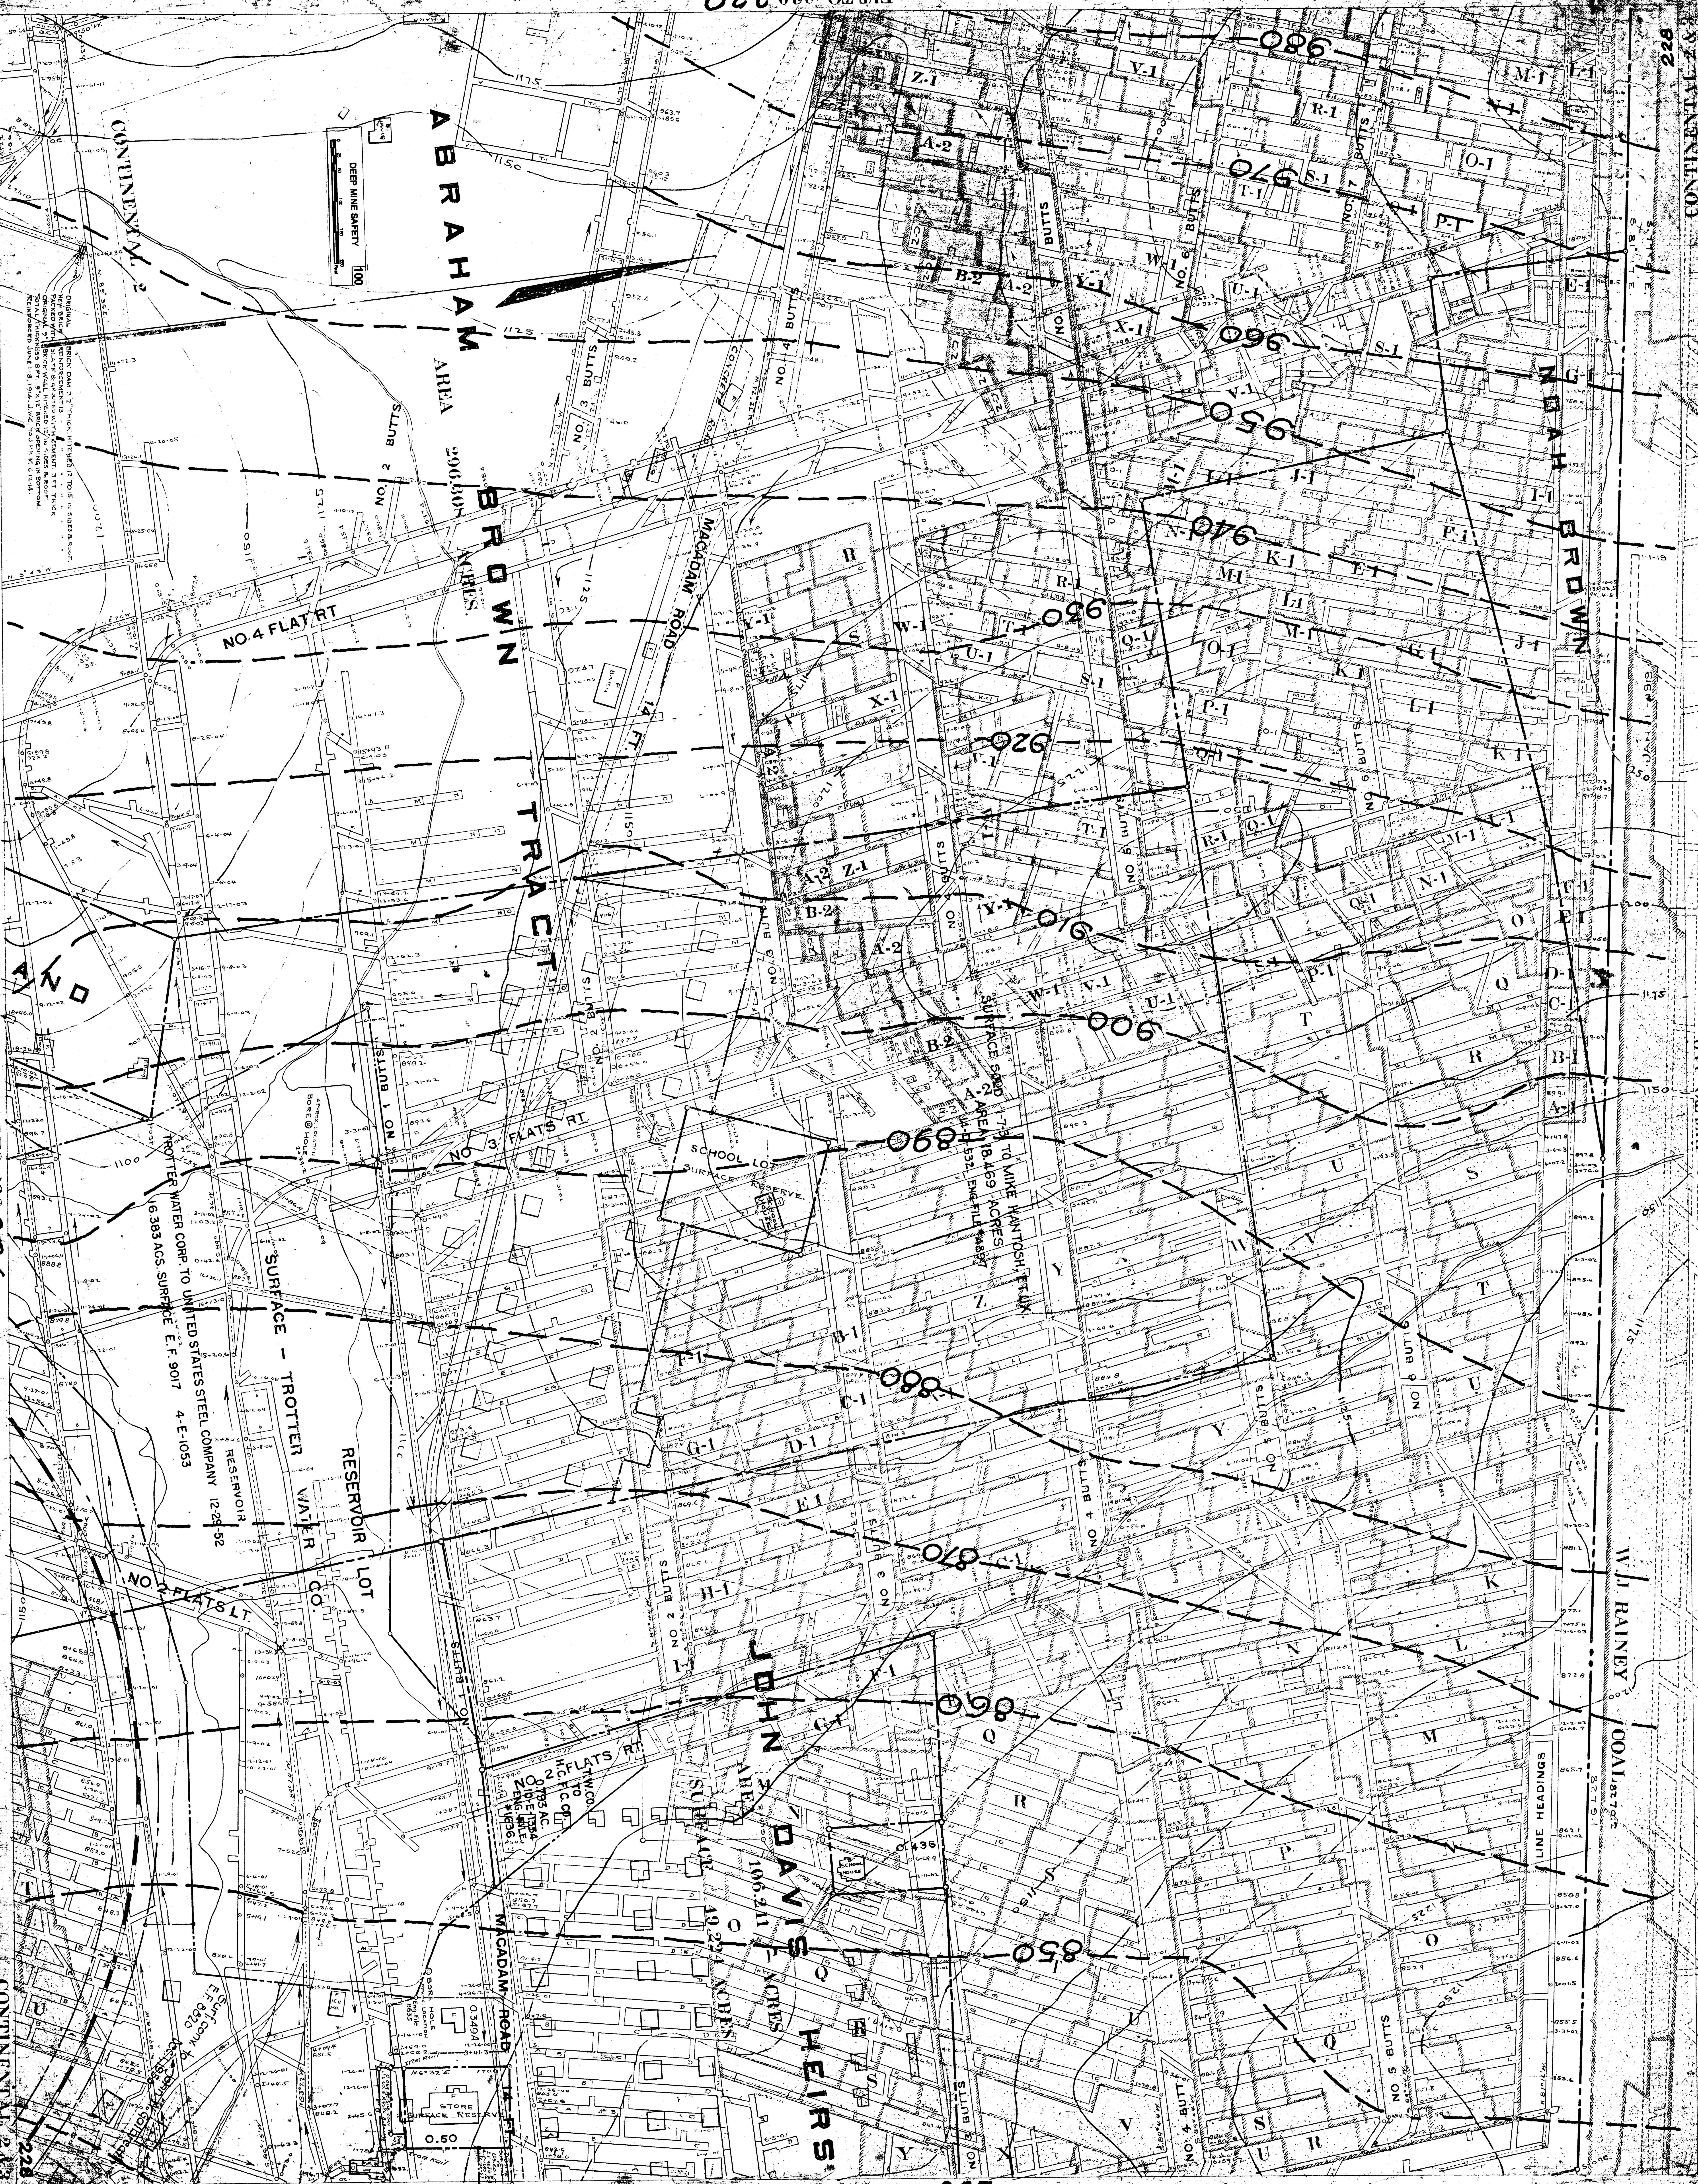
FIT TO 229 229
CONTINENTAL 2 & 3 228
228
FIT TO 219
FIT TO 236 236
CONTINENTAL 2 & 3 228
FIT TO 227 227
DEEP MINE SAFETY
0 25 50 100 150 200 Feet
100
ABRAHAM BROWN TRACT
AREA 296.308 ACRES
CONTINENTAL 2
ORIGINAL BRICK DAM 3'2" THICK, HITCHED 12" TO 15" IN SIDES & ROOF.
NEW BRICK REINFORCEMENT 13" " " " "
PACKED WITH SLATE & GROUTED WITH CEMENT 3 FT THICK.
ORIGINAL 9" BRICK WALL HITCHED 12" IN SIDES & ROOF.
TOTAL THICKNESS 8 FT. 9"X12" BRICK OPENING IN BOTTOM.
REINFORCED JUNE 1-8, 1914. J.W.C. TO J.K.K. M. 6-12-14.
NO 4 FLAT RT
NO 3 FLATS RT
NO 2 FLATS LT.
NO 2 FLATS RT
NO. 2 BUTTS
NO. 3 BUTTS
NO. 4 BUTTS
NO 5 BUTTS
NO 6 BUTTS
NO. 7 BUTTS
NO 1 BUTTS
CONCRETE ROAD
MACADAM ROAD
14 FT.
AND
SCHOOL LOT SURFACE RESERVE.
SCHOOL HOUSE
APPROX. LOCATION BORE HOLE
SURFACE - TROTTER WATER CO. RESERVOIR LOT
TROTTER WATER CORP. TO UNITED STATES STEEL COMPANY 12-29-52
RESERVOIR
16.383 ACS. SURFACE E.F. 9017 4-E-1053
SURFACE SOLD 1-7-53 TO MIKE HANTOSH, ET UX.
AREA 18.469 ACRES
14-D-532. ENG. FILE #4897
NOAH BROWN
JOHN DAVIS HEIRS
AREA 106.211 ACRES
SURFACE 49.224 ACRES
T.W.CO. TO H.C.F.C.CO.
0.793 AC.
10-E-1334
ENG. FILE #1636
U.S.S. Surf. conv. to E.F. 8620
BORE HOLE APPROX. LOCATION Eng. File 8635
0.349A
STORE SURFACE RESERVE
0.50
N.6°32'E 1700
Iron Rail
W.J. RAINEY COAL
LINE HEADINGS
1175
1150
1125
1100
1200
1250
1225
980
970
960
950
940
930
920
910
900
890
880
870
860
850
436