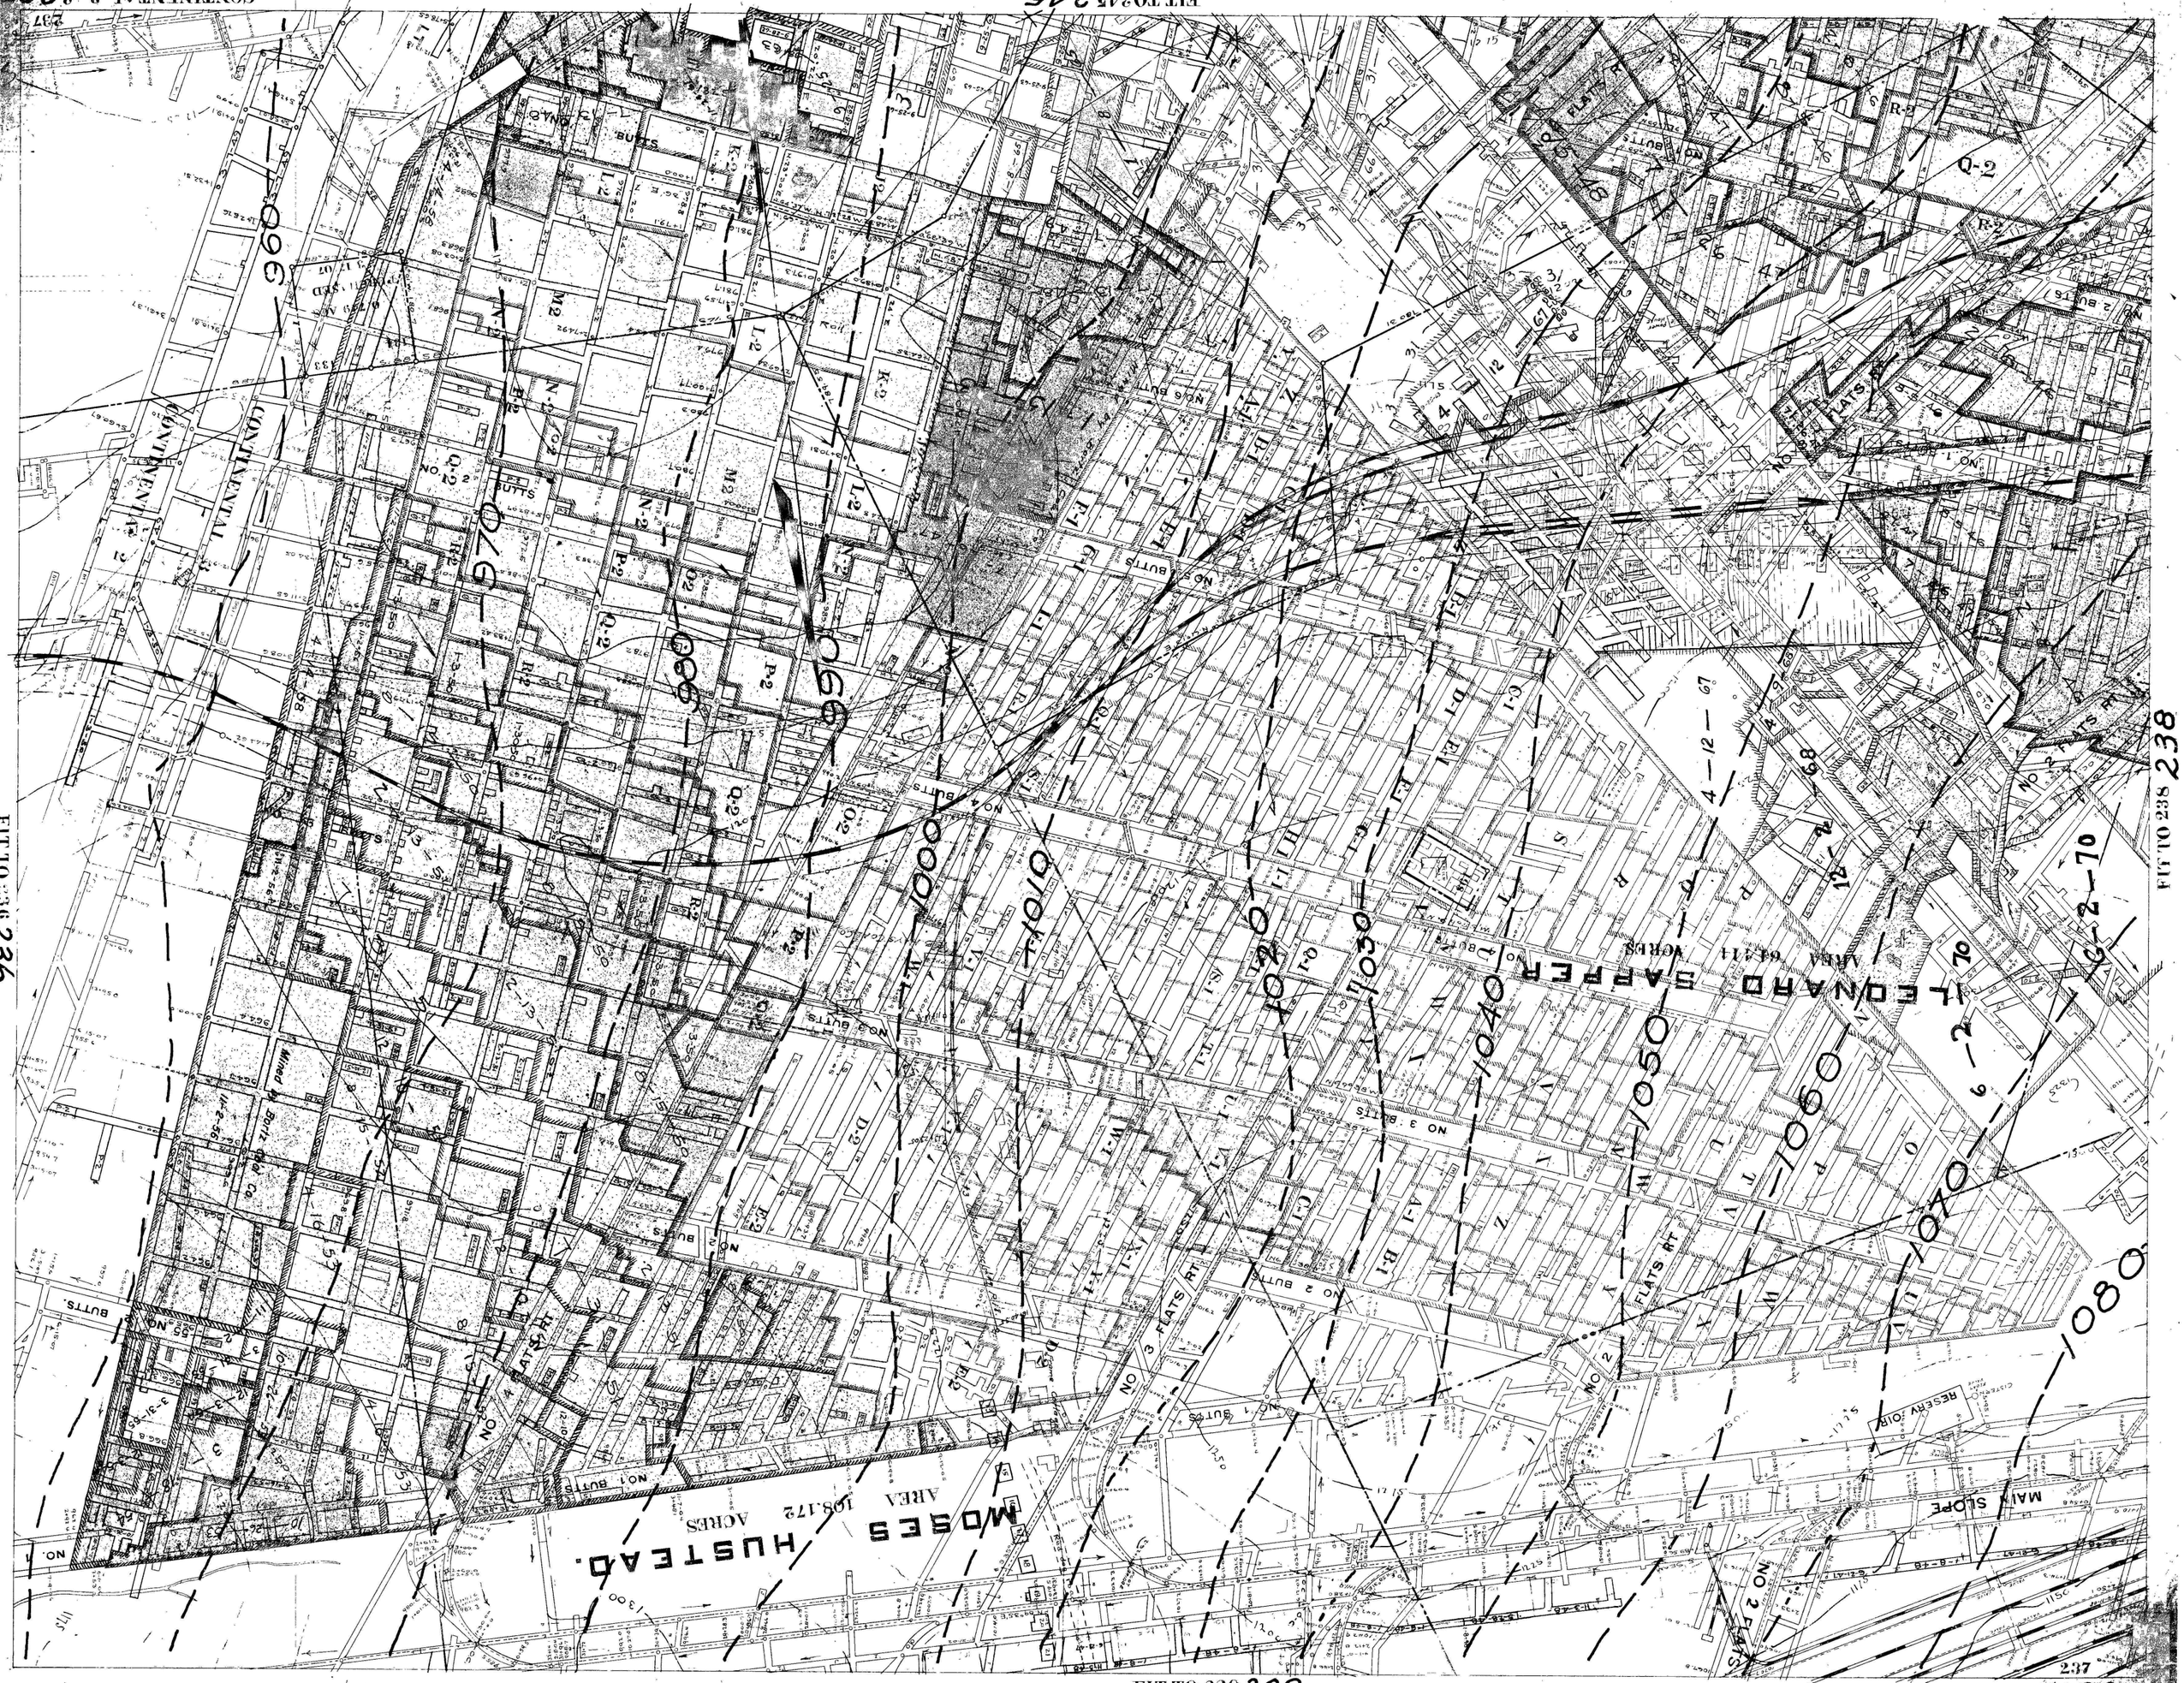
MOSES HUSTEAD.
AREA 108.172 ACRES
LEONARD SAFFER
AREA 64.411 ACRES
MAIN SLOPE
RESERVOIR
FLATS RT
NO 1 BUTTS
NO 2 BUTTS
NO 3 BUTTS
NO 4 BUTTS
CONTINENTAL
Mined by Doris Coal Co.
FIT TO 229
FIT TO 236
FIT TO 238
CONTINENTAL 3-2 237
FIT TO 245
CONTINENTAL 3-2 237