FIT TO 237 227

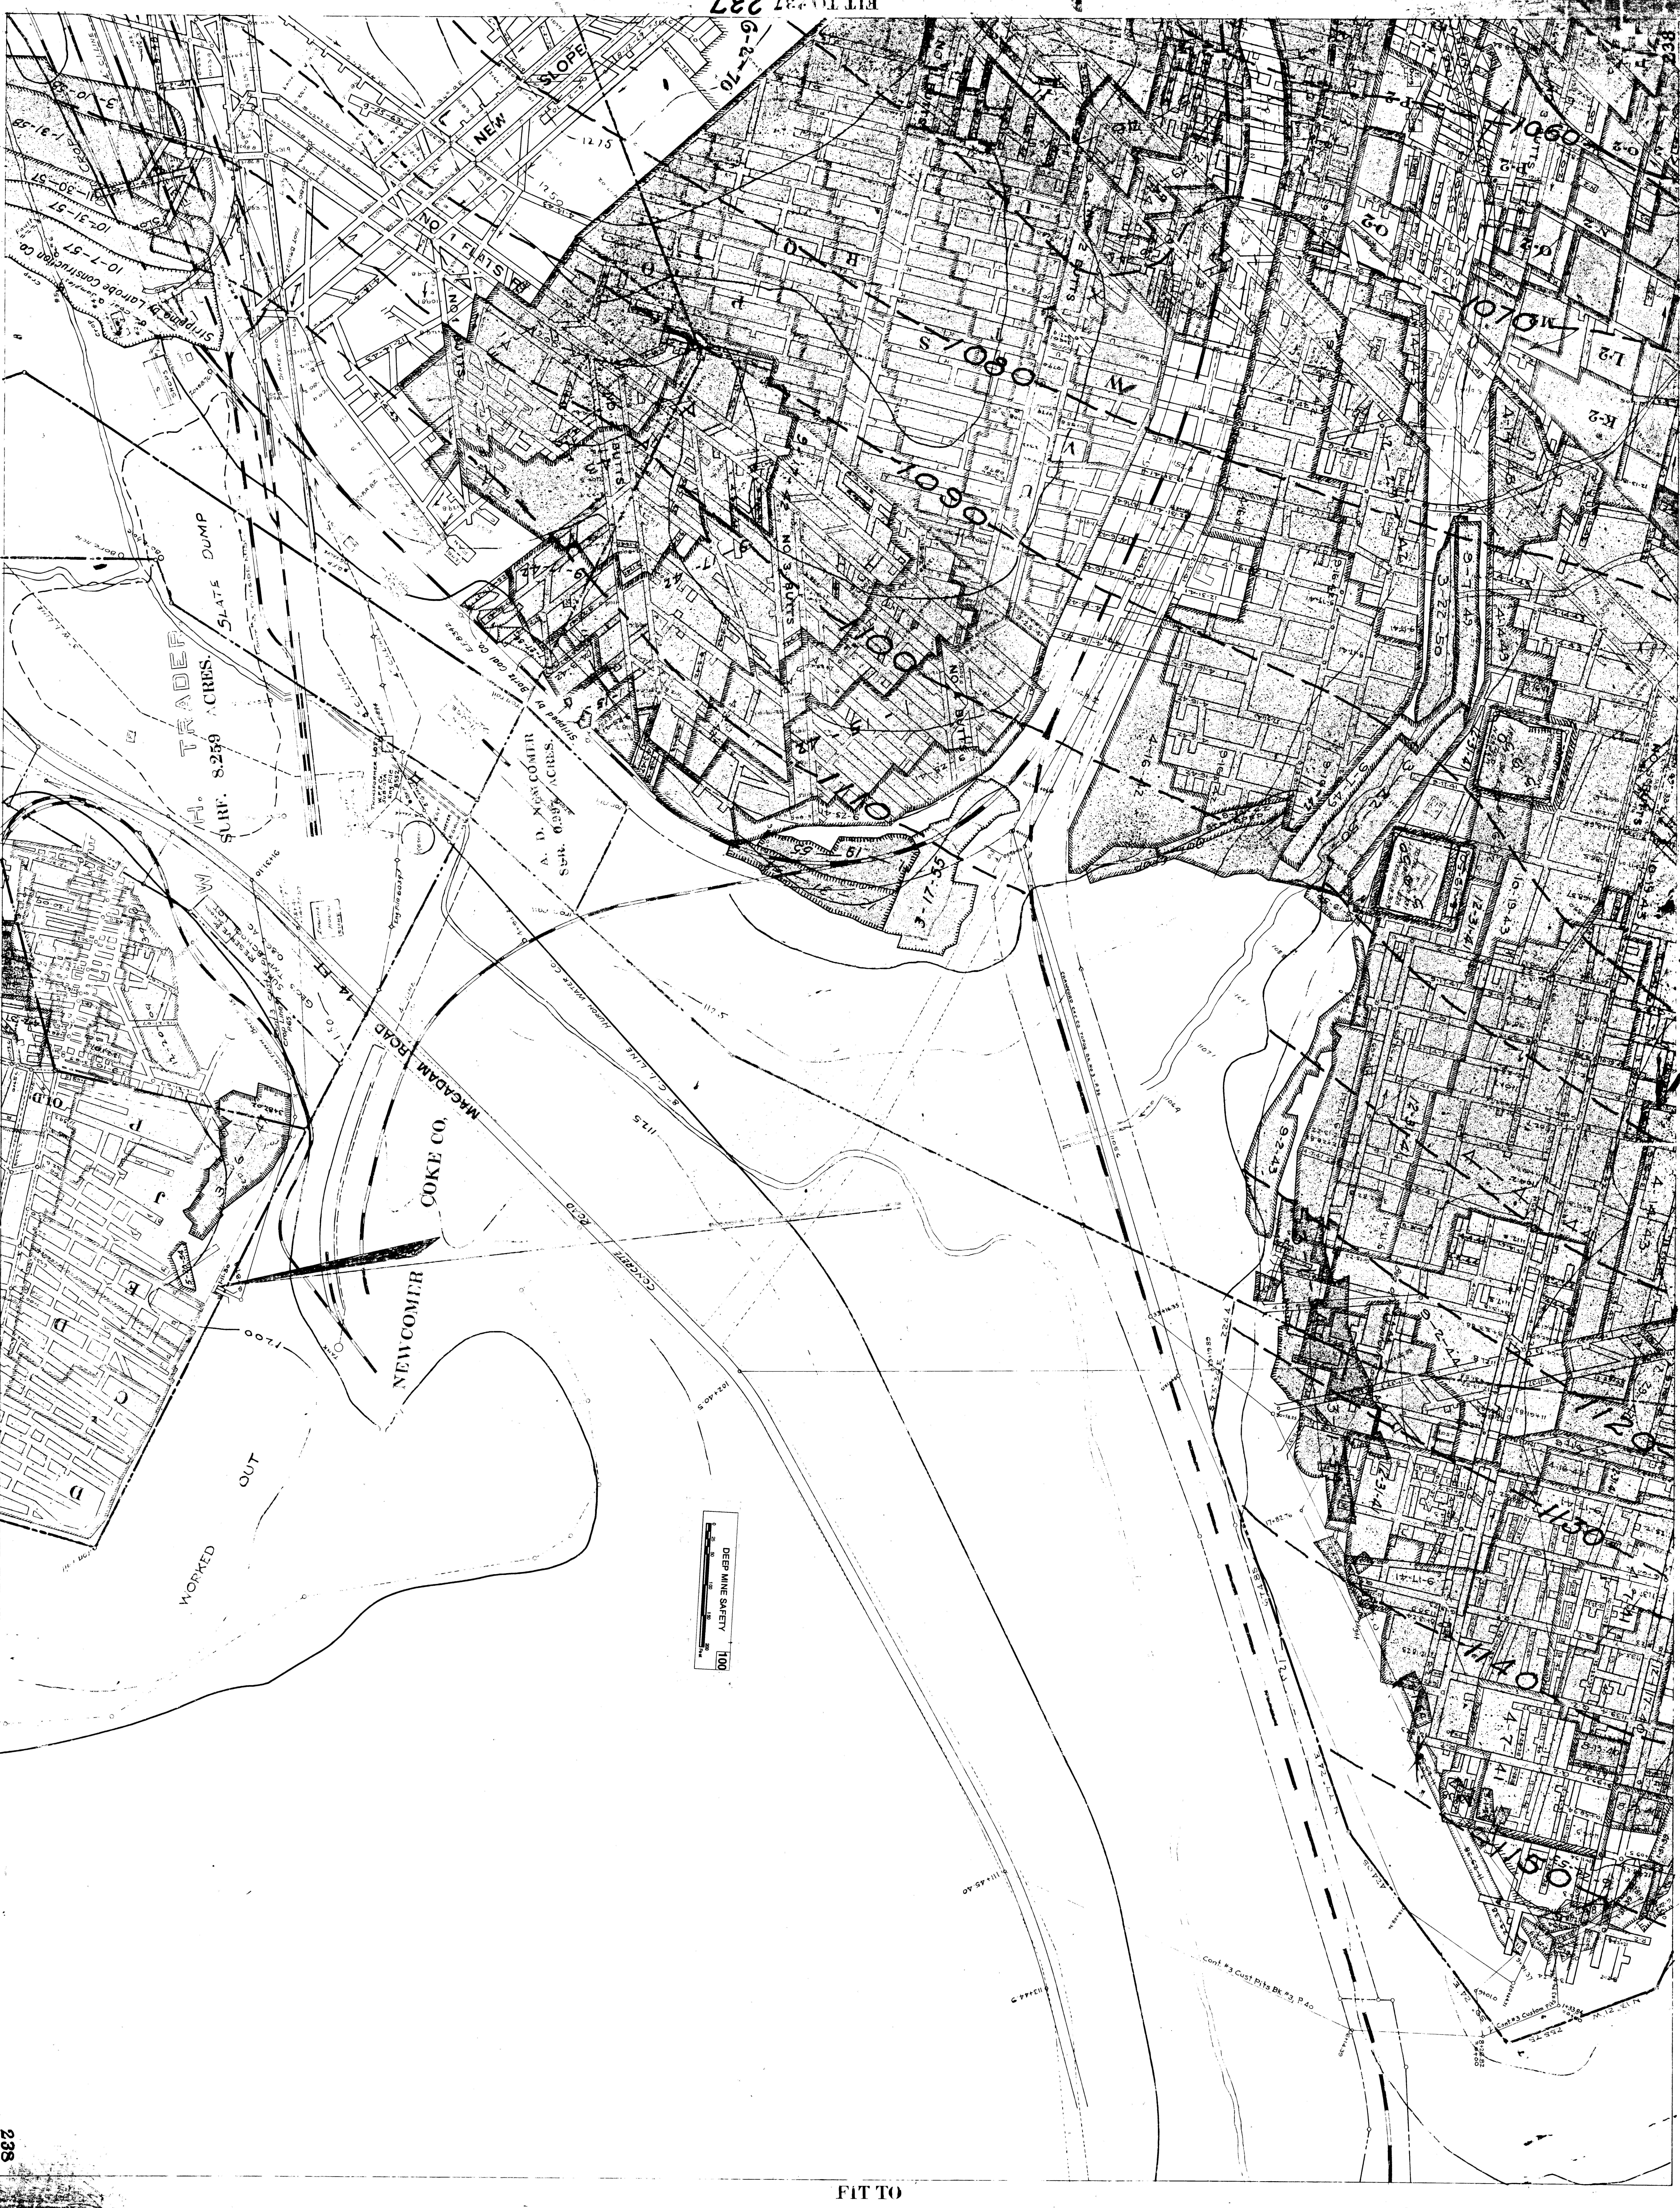
NEW SLOPE
NO 1 FLATS
NO 3 BUTTS
BUTTS
6-2-70
9-25-63
1275
1250
1080
1090
1100
1110
1060
1070
1120
1130
1140
1150
P-2
O-2
N-2
L-2
K-2
3-10-58
1-31-58
11-30-57
10-31-57
10-7-57
Stripping by Latrobe Construction Co.
Crop
Coal Samples
SLATE DUMP
H. TRADER SURF. 8.259 ACRES.
A. D. NEWCOMER SURF. 0.99 ACRES.
Stripped by Bortz Coal Co.
3-17-55
9-23-41
3-22-50
9-7-49
4-16-42
12-31-41
10-19-43
4-14-43
9-2-43
9-2-44
4-4-43
4-7-41
8-13-40
9-17-41
12-31-4
GEO. S. SURF. RESERVE
SCHOOL TWP.
14 FT. MACADAM ROAD
CONCRETE ROAD
8" C. L. LINE
HURON WATER CO.
NEWCOMER COKE CO.
OLD
D
E
F
J
C
1200
1125
1071
1069
5-20-54
WORKED OUT
TRANSFORMER LOT
ENGINE HOUSE STONE
TANK
Cont. #3 Cust Pits BK #3, P. 40
Cont. #3 Custom Pits
S 73° 30' E
N 7° 24' E
N 12° 12' W
DEEP MINE SAFETY
0 25 50 100 150 200 Feet
100

CONTINENTAL 238

FIT TO 246 246

FIT TO 230 230

CONTINENTAL 238 3

238

FIT TO