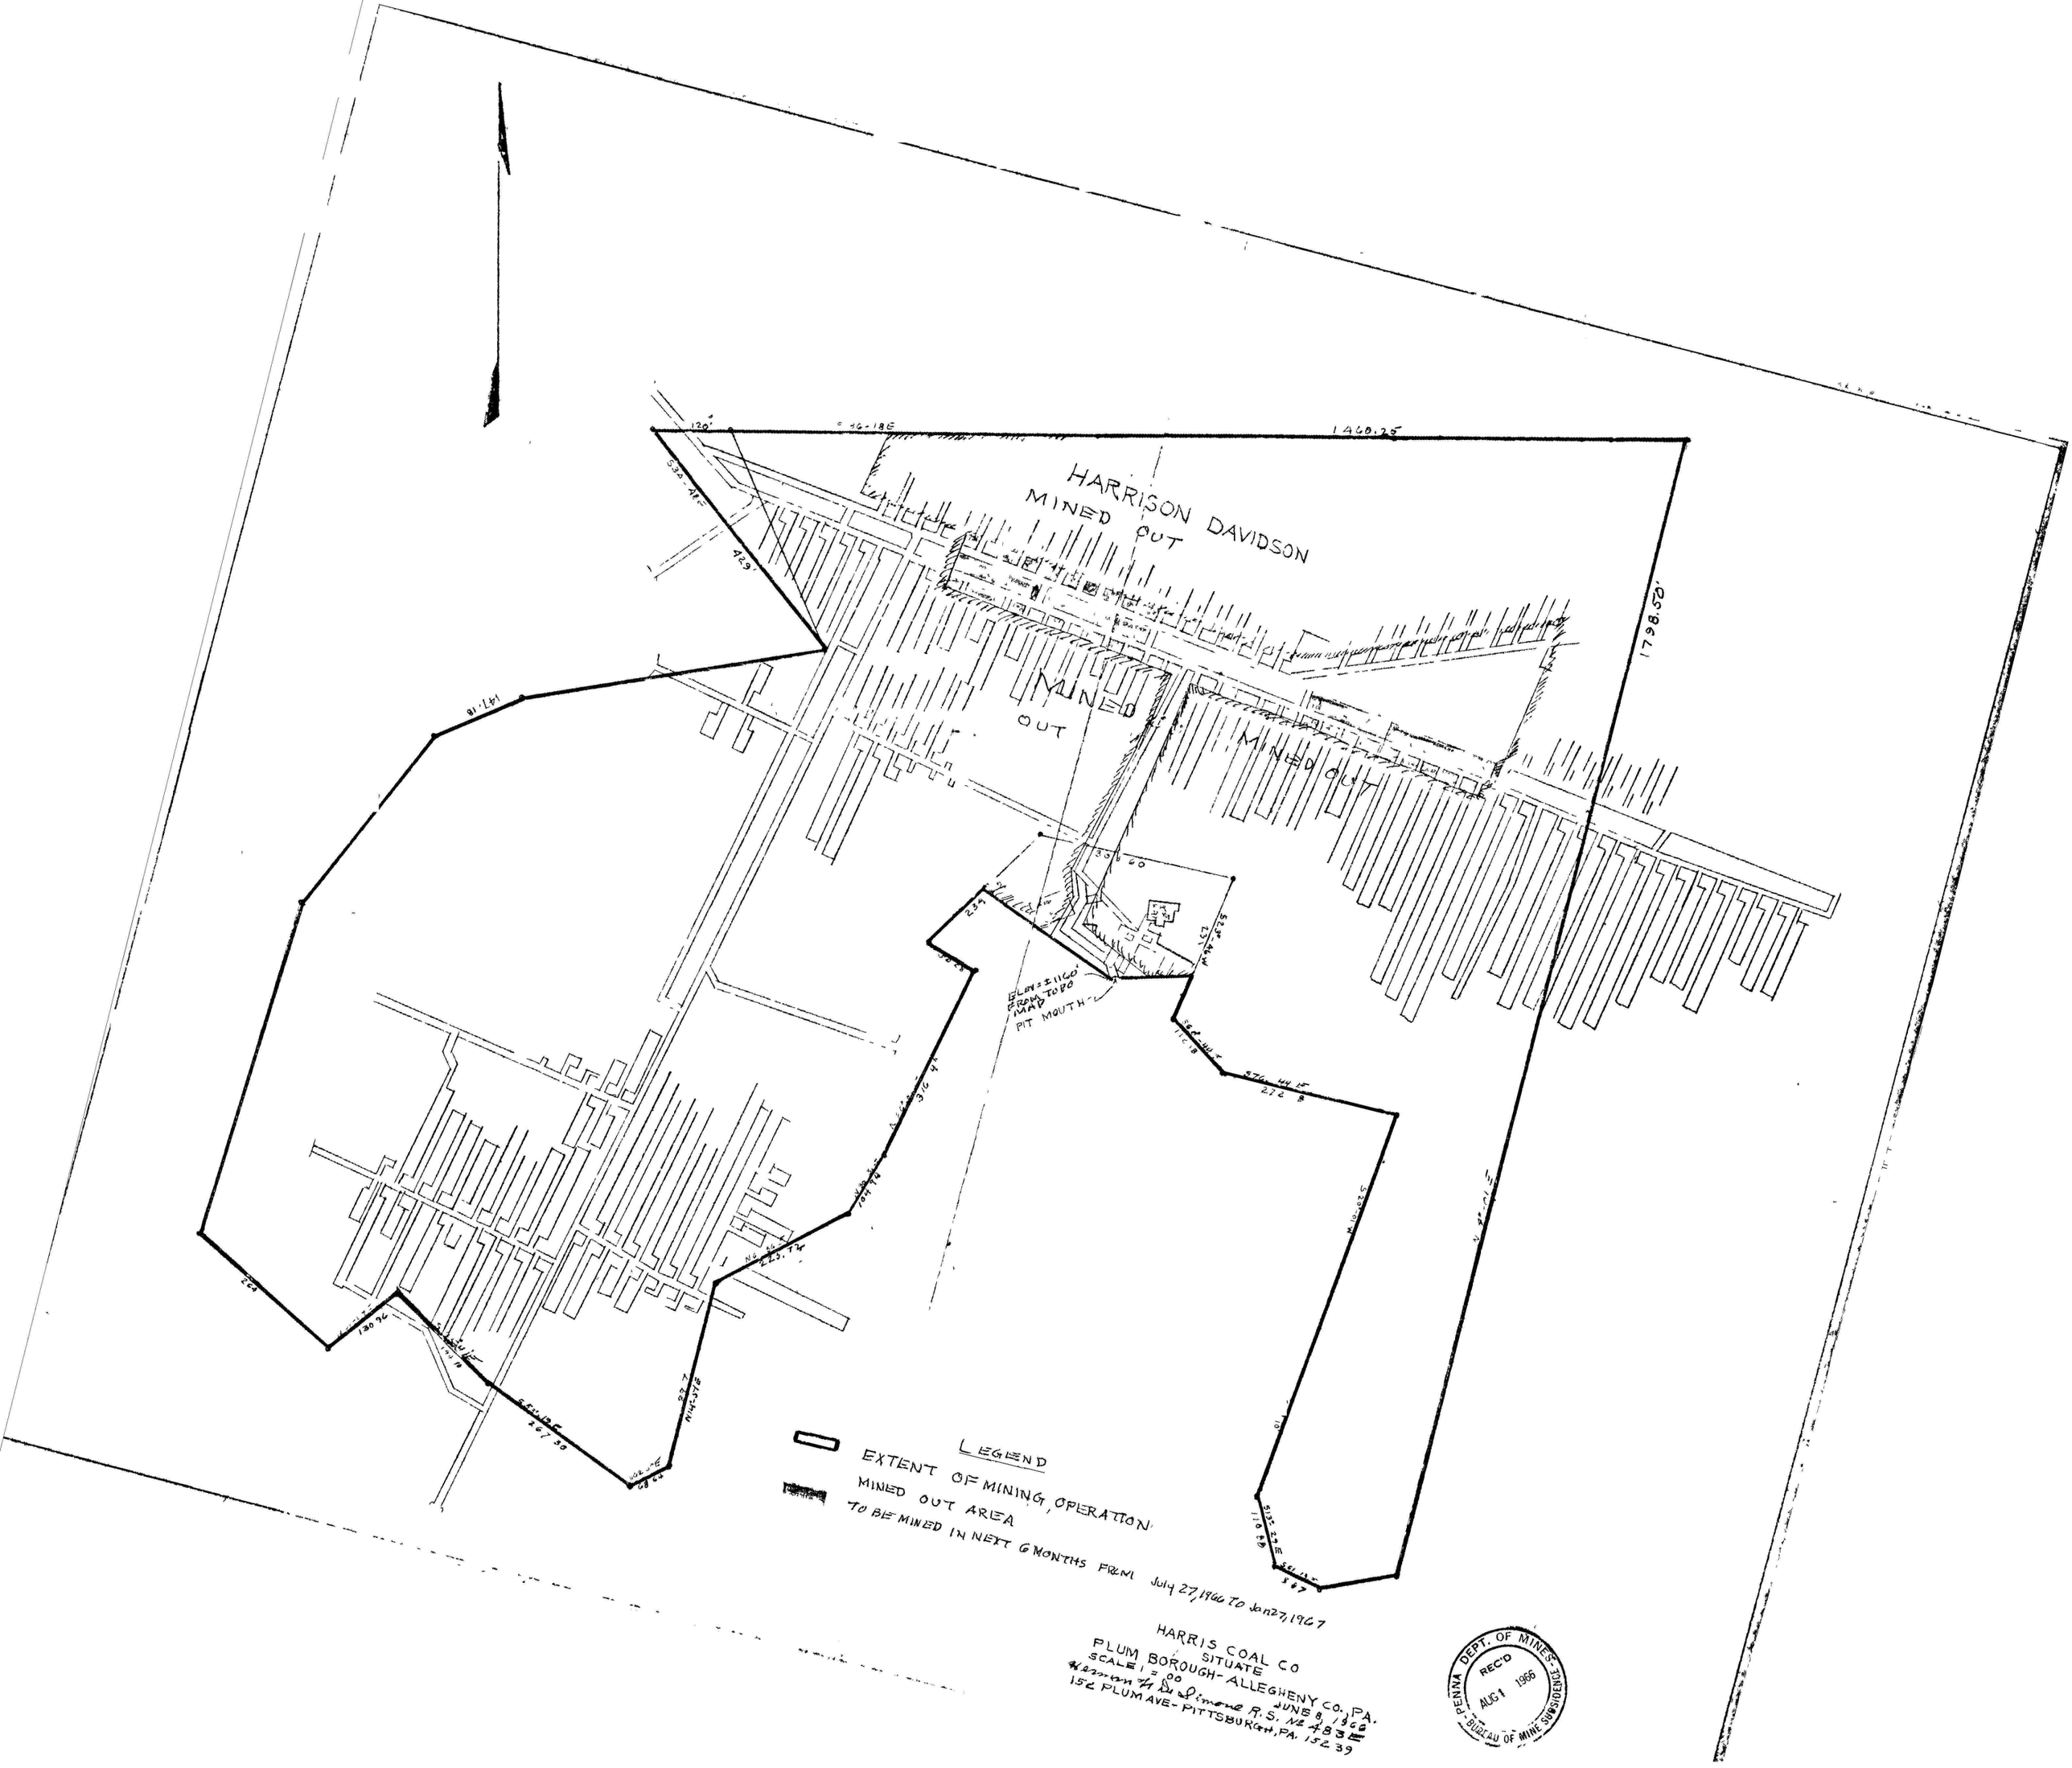
HARRISON DAVIDSON
MINED OUT
MINED OUT
MINED OUT
1460.25
1798.50'
ELEV. ±1160' FROM TOPO MAP TO PIT MOUTH
LEGEND
EXTENT OF MINING OPERATION
MINED OUT AREA
TO BE MINED IN NEXT 6 MONTHS FROM July 27, 1966 TO Jan 27, 1967
HARRIS COAL CO
SITUATE
PLUM BOROUGH-ALLEGHENY CO., PA.
SCALE 1" = 100'
JUNE 8, 1966
Warren H. DiSimone R.S. No. 4838
152 PLUM AVE - PITTSBURGH, PA. 15239
PENNA DEPT. OF MINES
REC'D
AUG 1 1966
BUREAU OF MINE SUBSIDENCE