


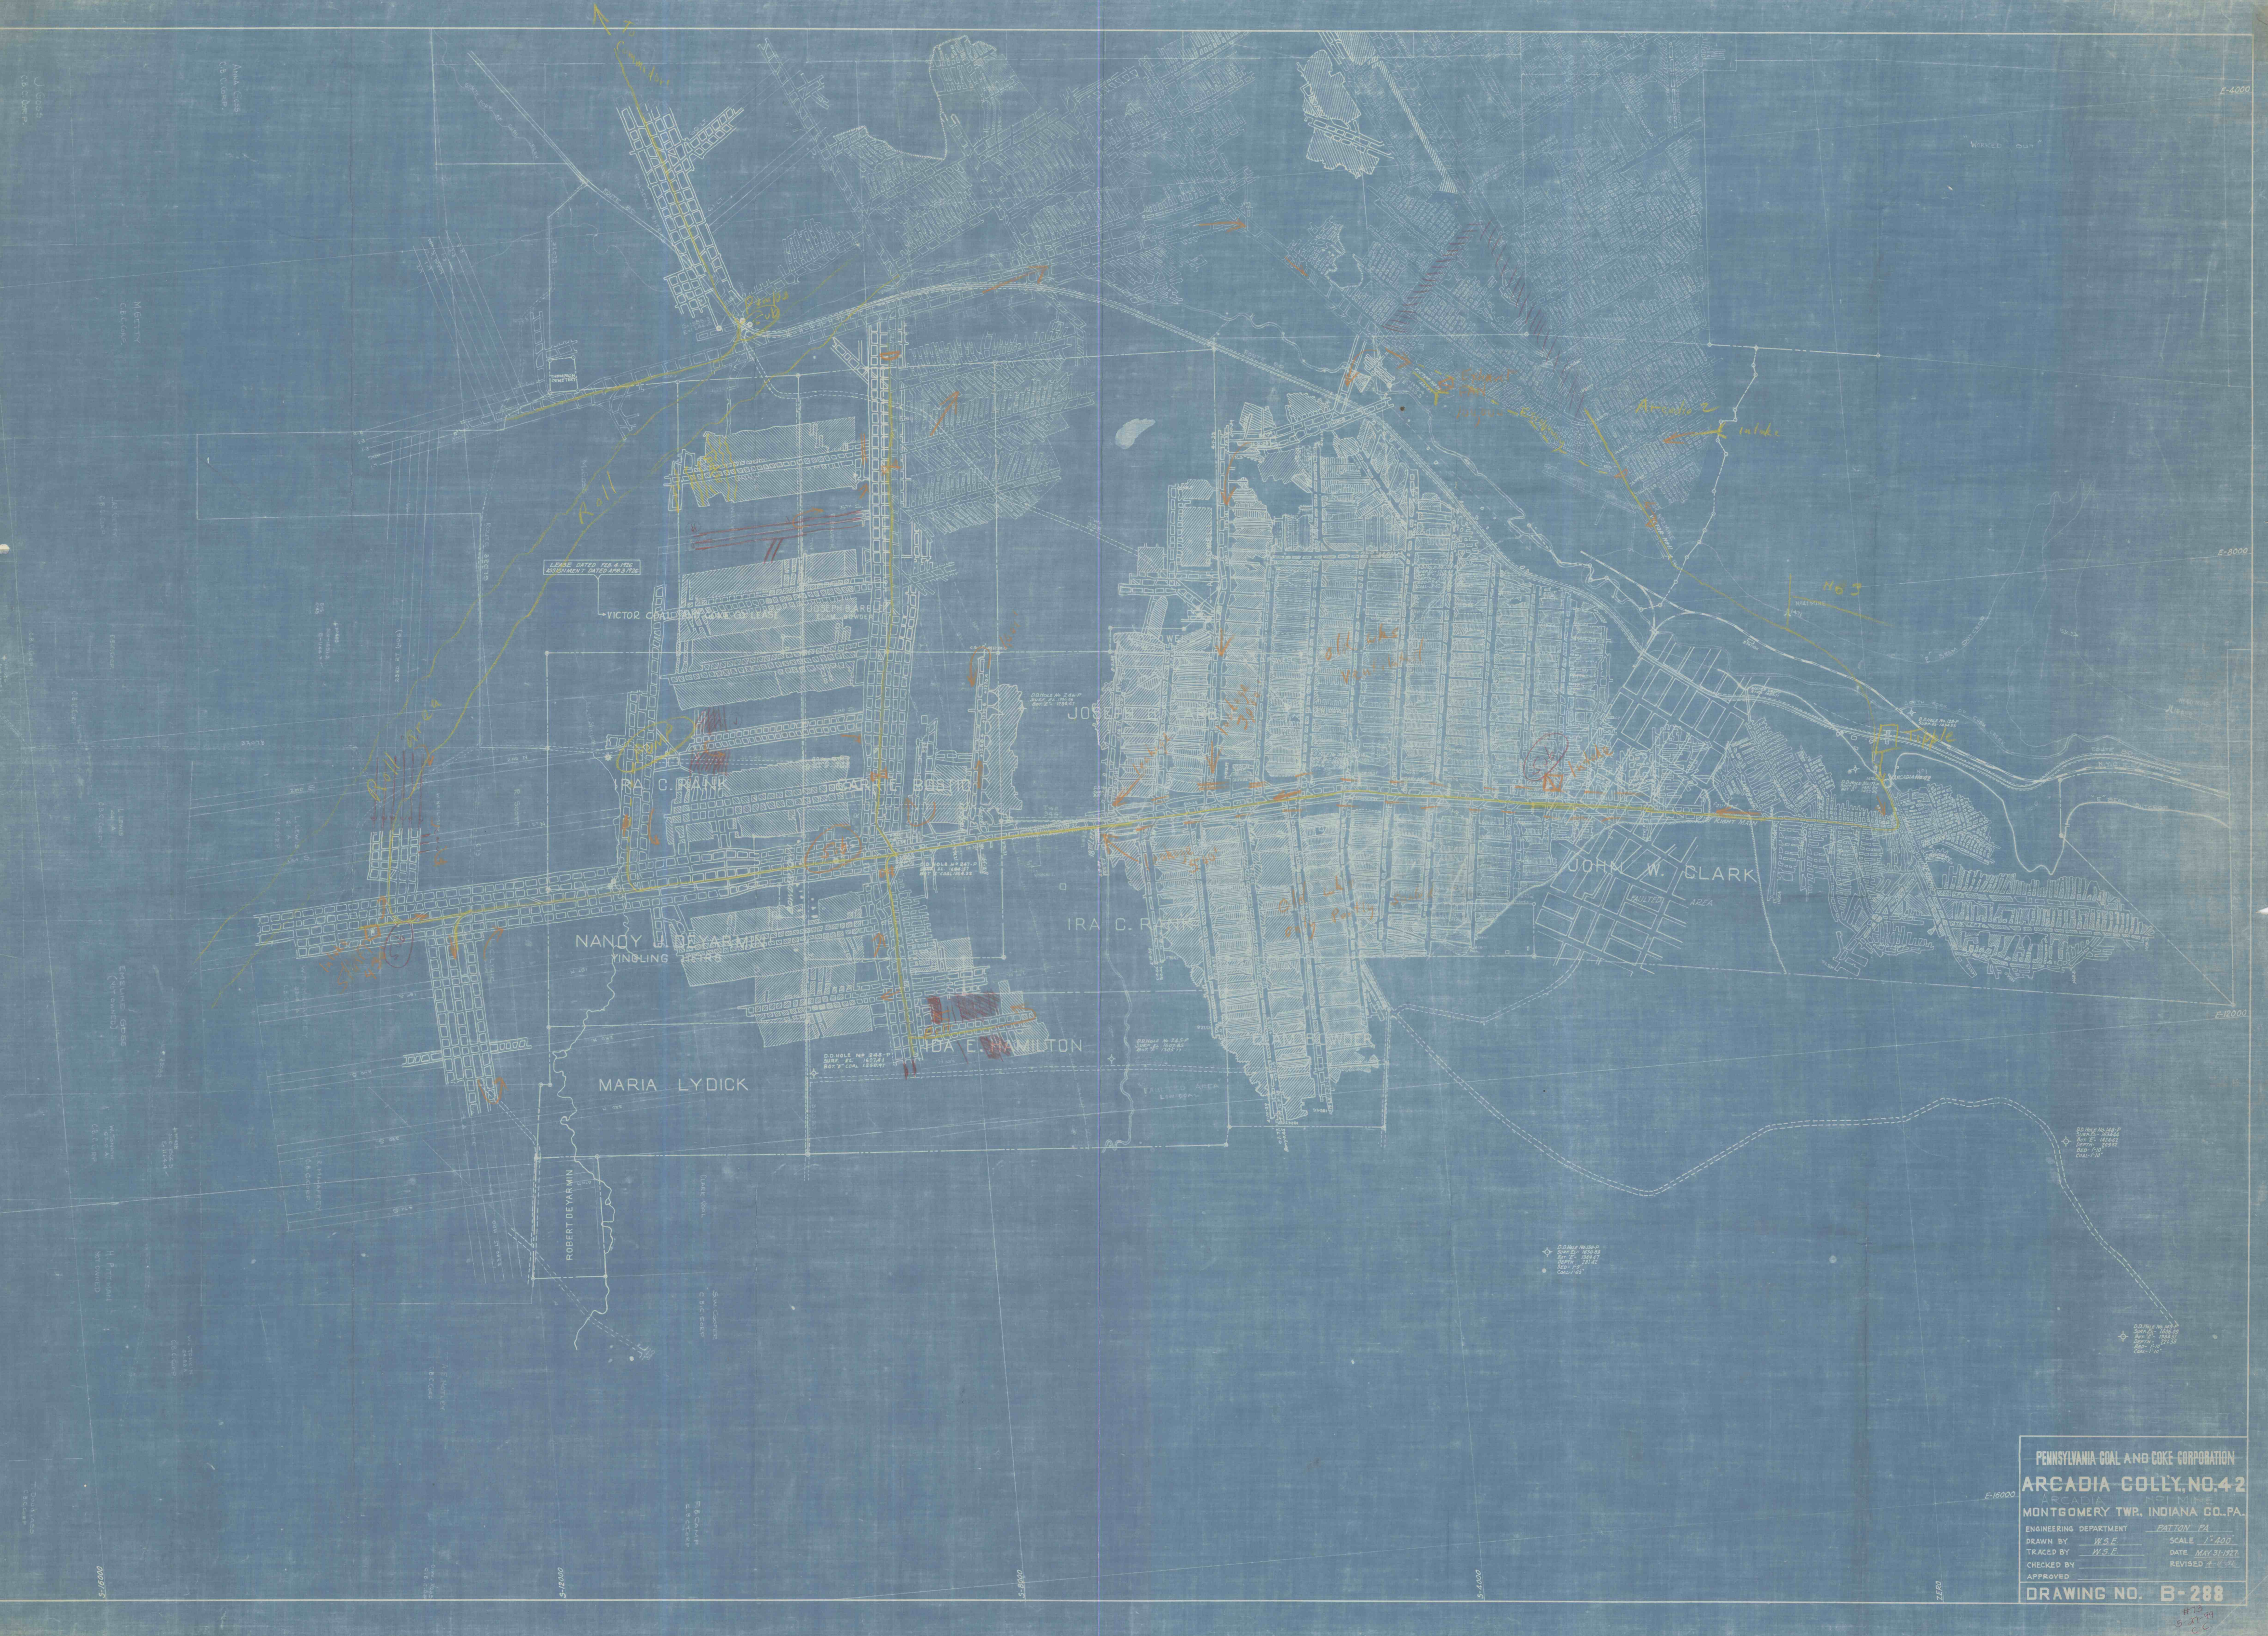

PENNSYLVANIA COAL AND COKE CORPORATION
ARCADIA CO. NO. 42
MONTGOMERY TWP., INDIANA CO., PA.
ENGINEERING DEPARTMENT
DRAWN BY: W.S.E.
CHECKED BY: W.S.E.
APPROVED: [Signature]
SCALE: 1"=200'
DATE: MAY 31, 1927
DRAWING NO. B-288