


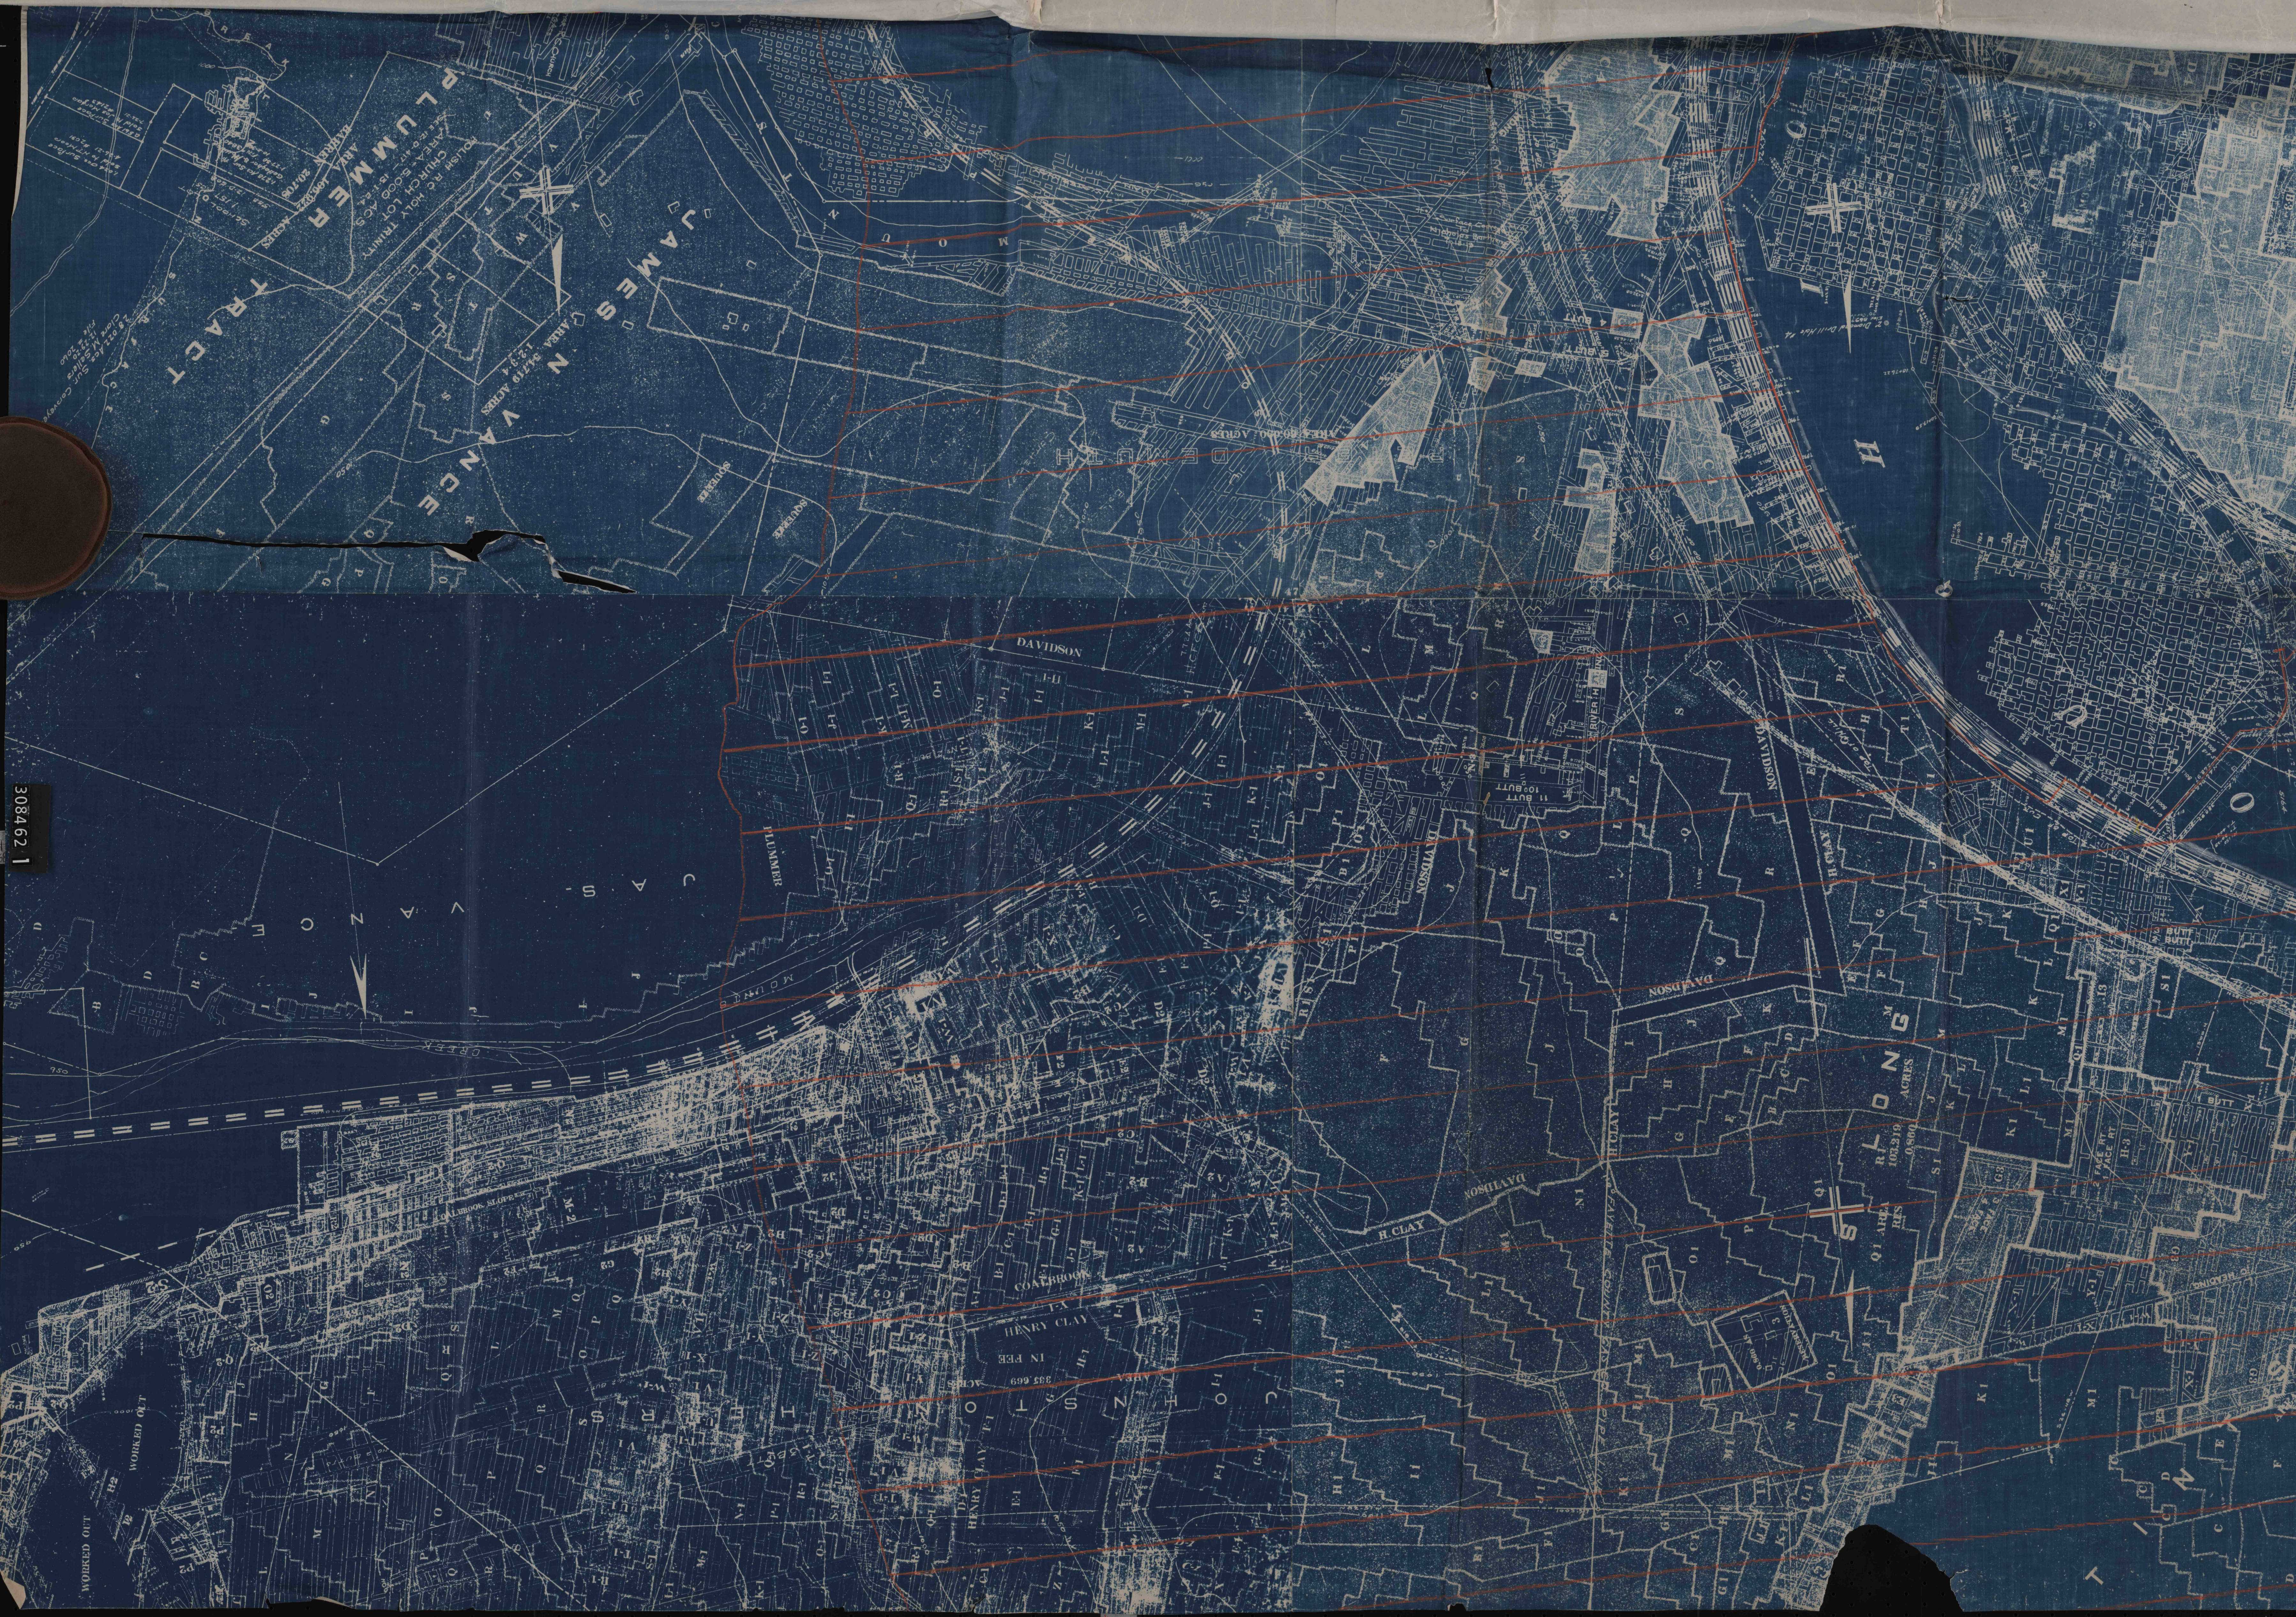

308462 1