


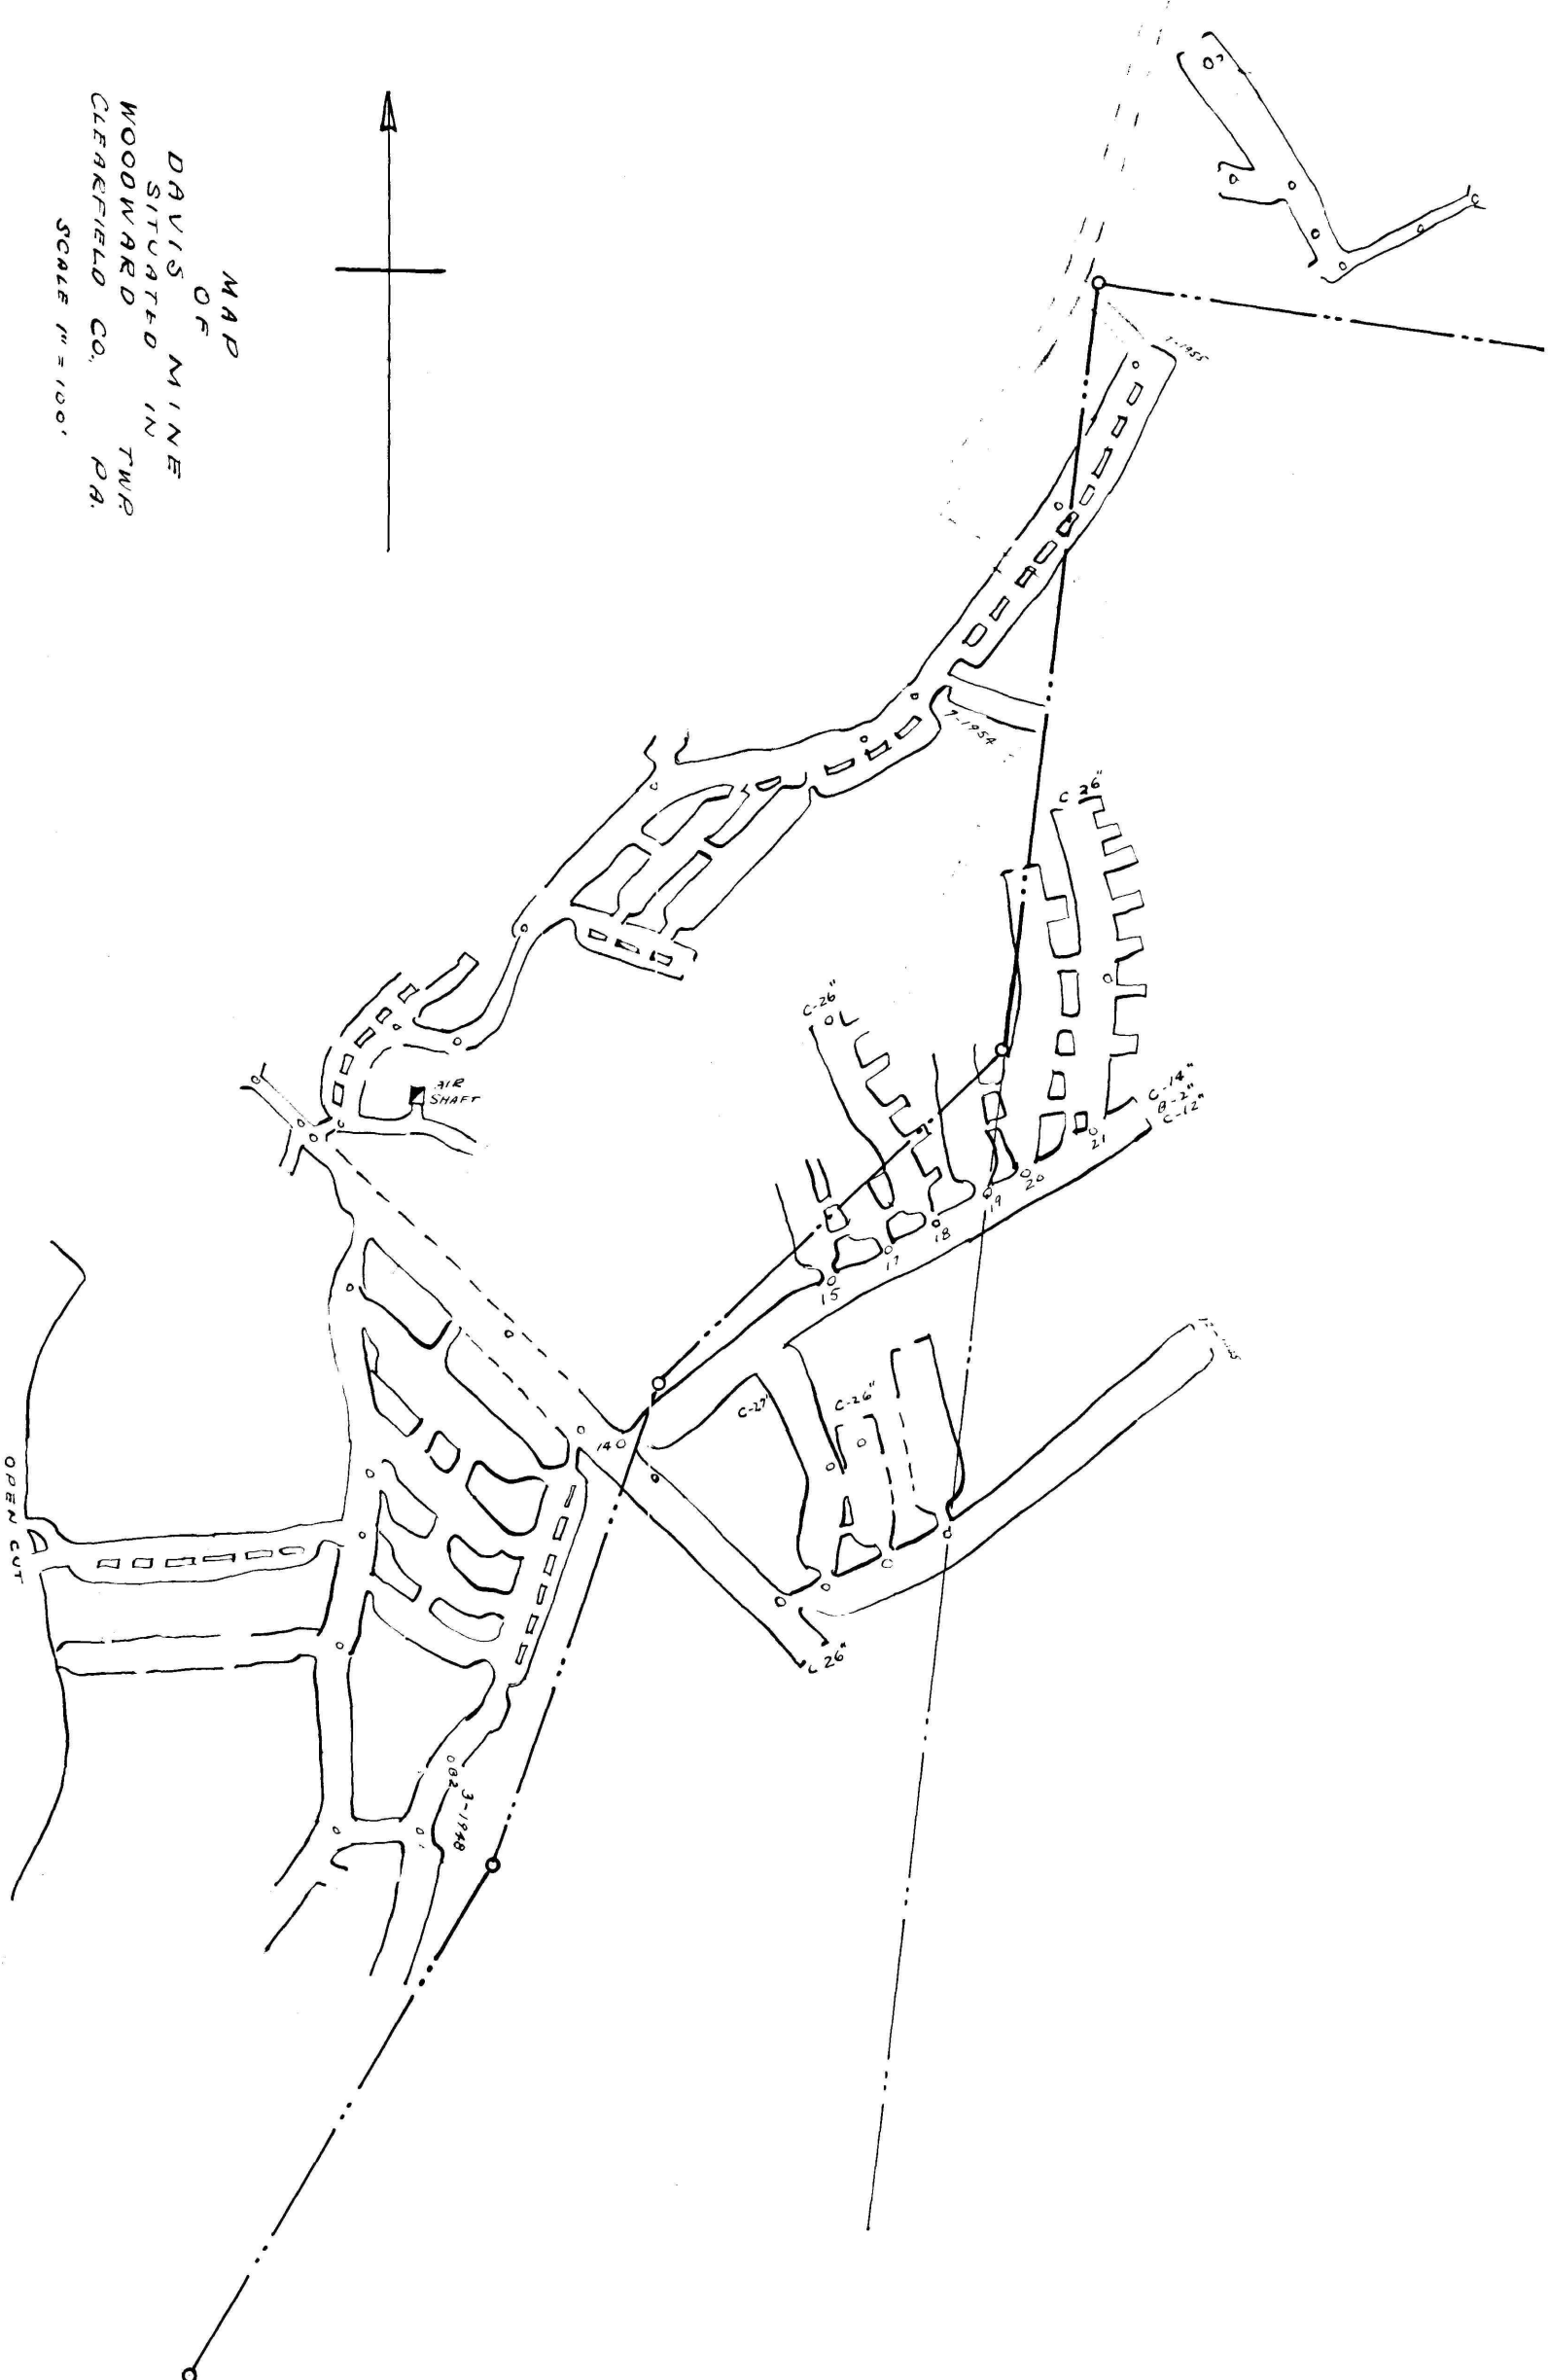

MAP
OF
DAVIS MINE
SITUATED IN
WOODWARD
CLEARFIELD CO.,
PA.
SCALE 1" = 100'