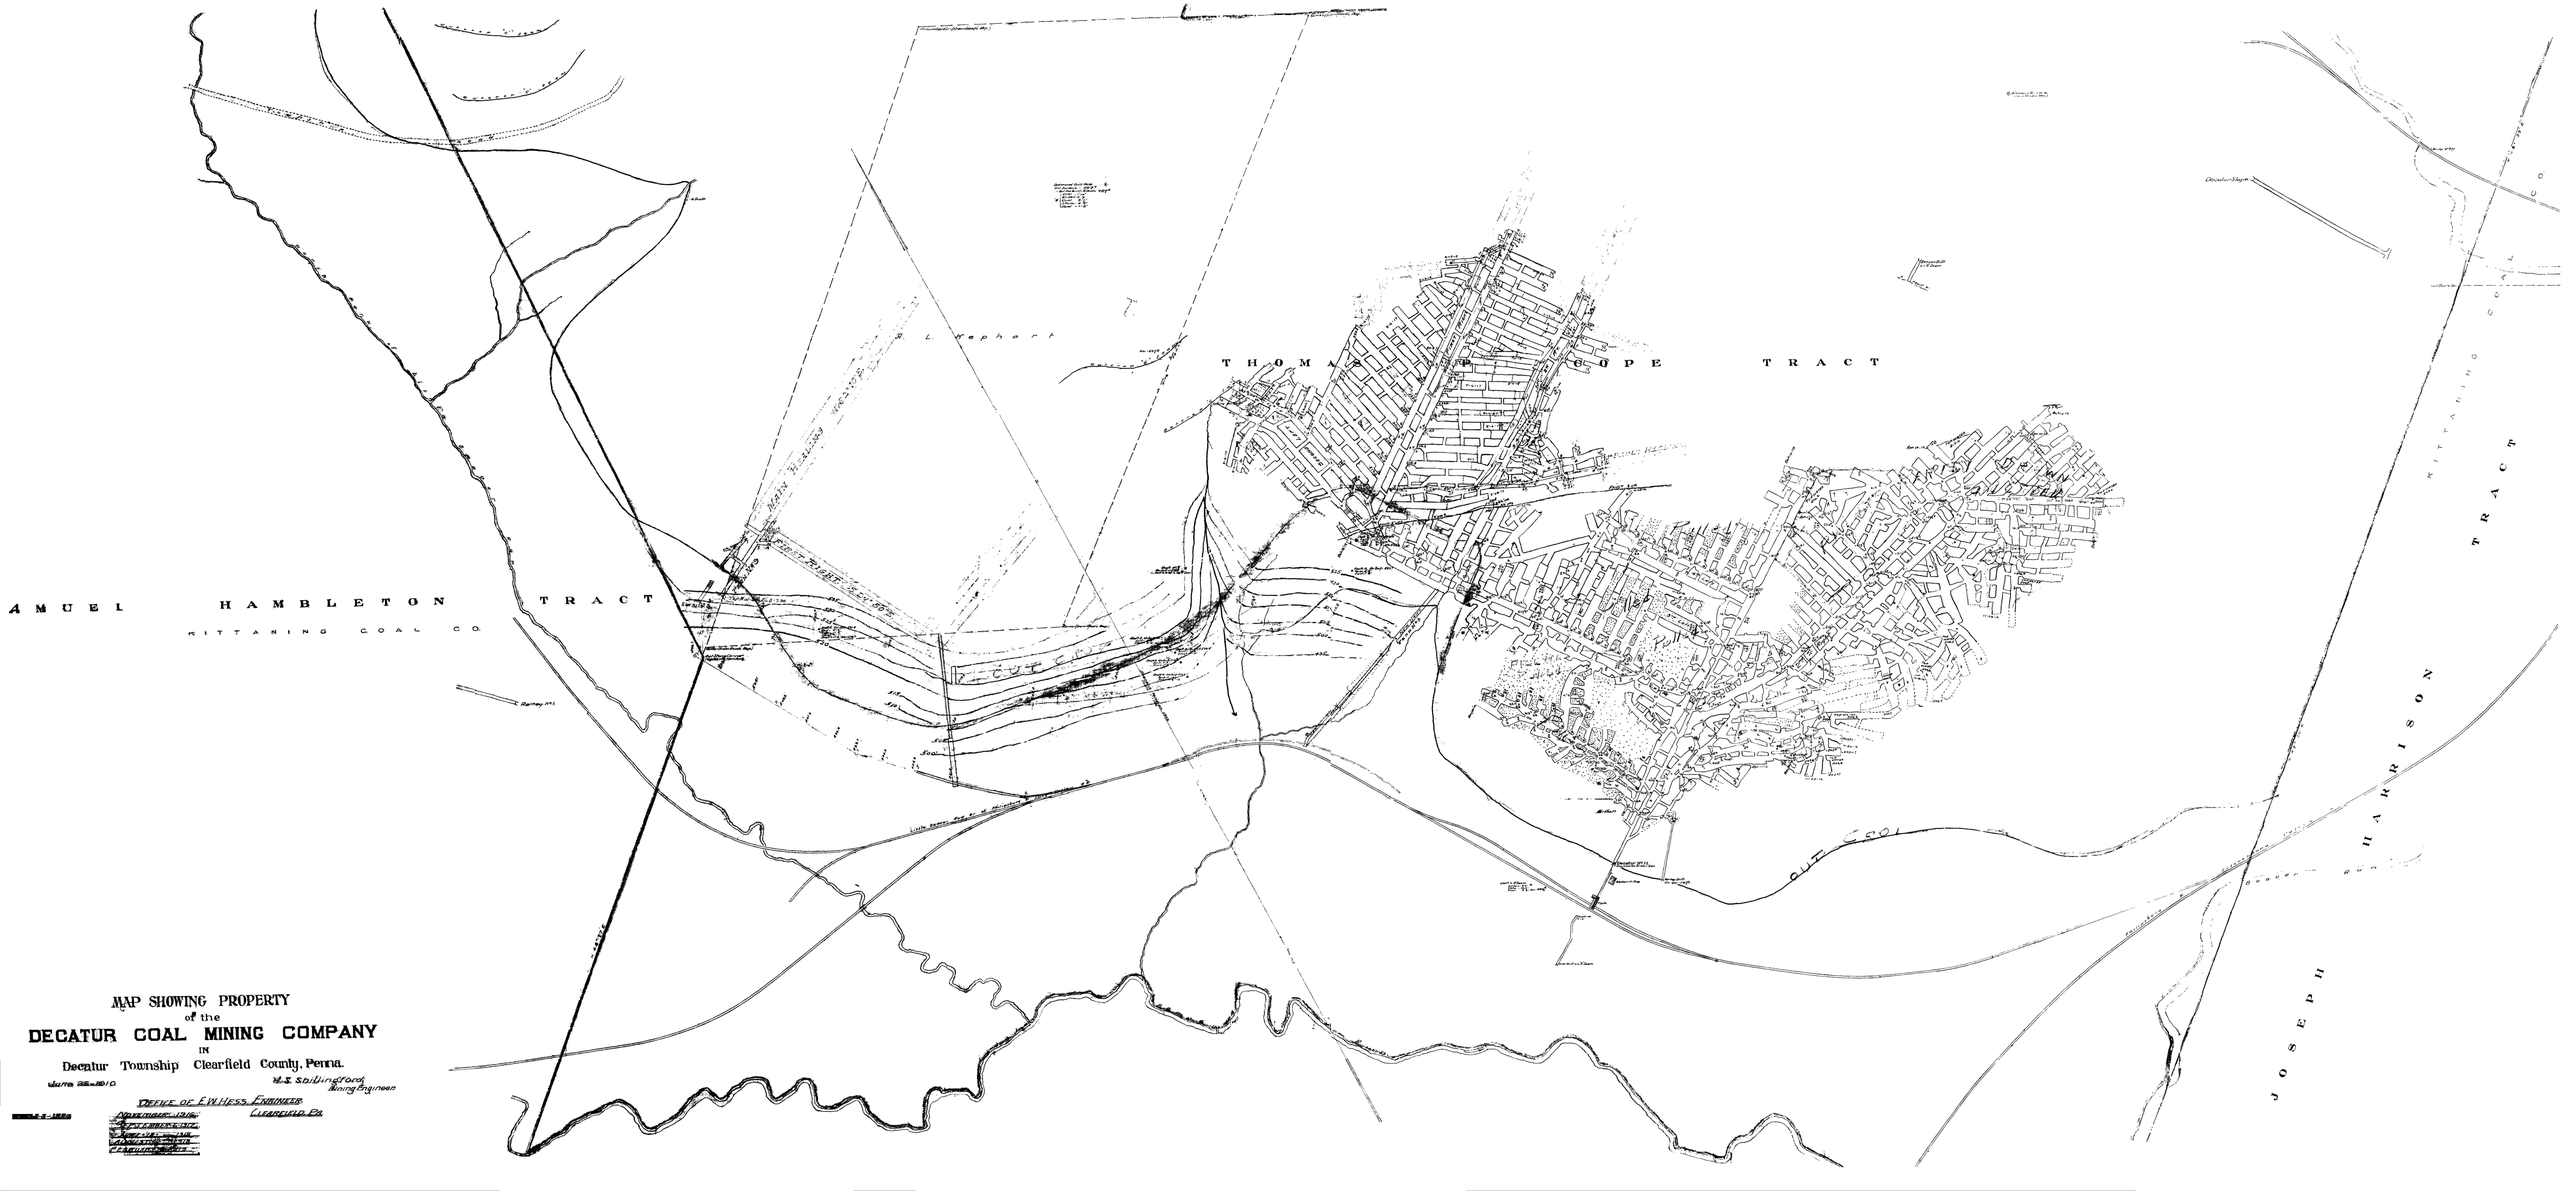
MAP SHOWING PROPERTY
of the
DECATUR COAL MINING COMPANY
IN
Decatur Township Clearfield County, Penna.
June 22nd 1910
W.S. Stillingford
Mining Engineer
OFFICE OF E.W. HESS, ENGINEER
CLEARFIELD, PA.
November 1916
Scale of Feet per Inch
THOMAS COPE TRACT
SAMUEL HAMBLETON TRACT
RITTANING COAL CO.
JOSEPH HARRISON TRACT
RITTANING COAL CO.
OUT COP
OUT COP
MAIN HAULING WAYS
MAIN HAULING WAYS