


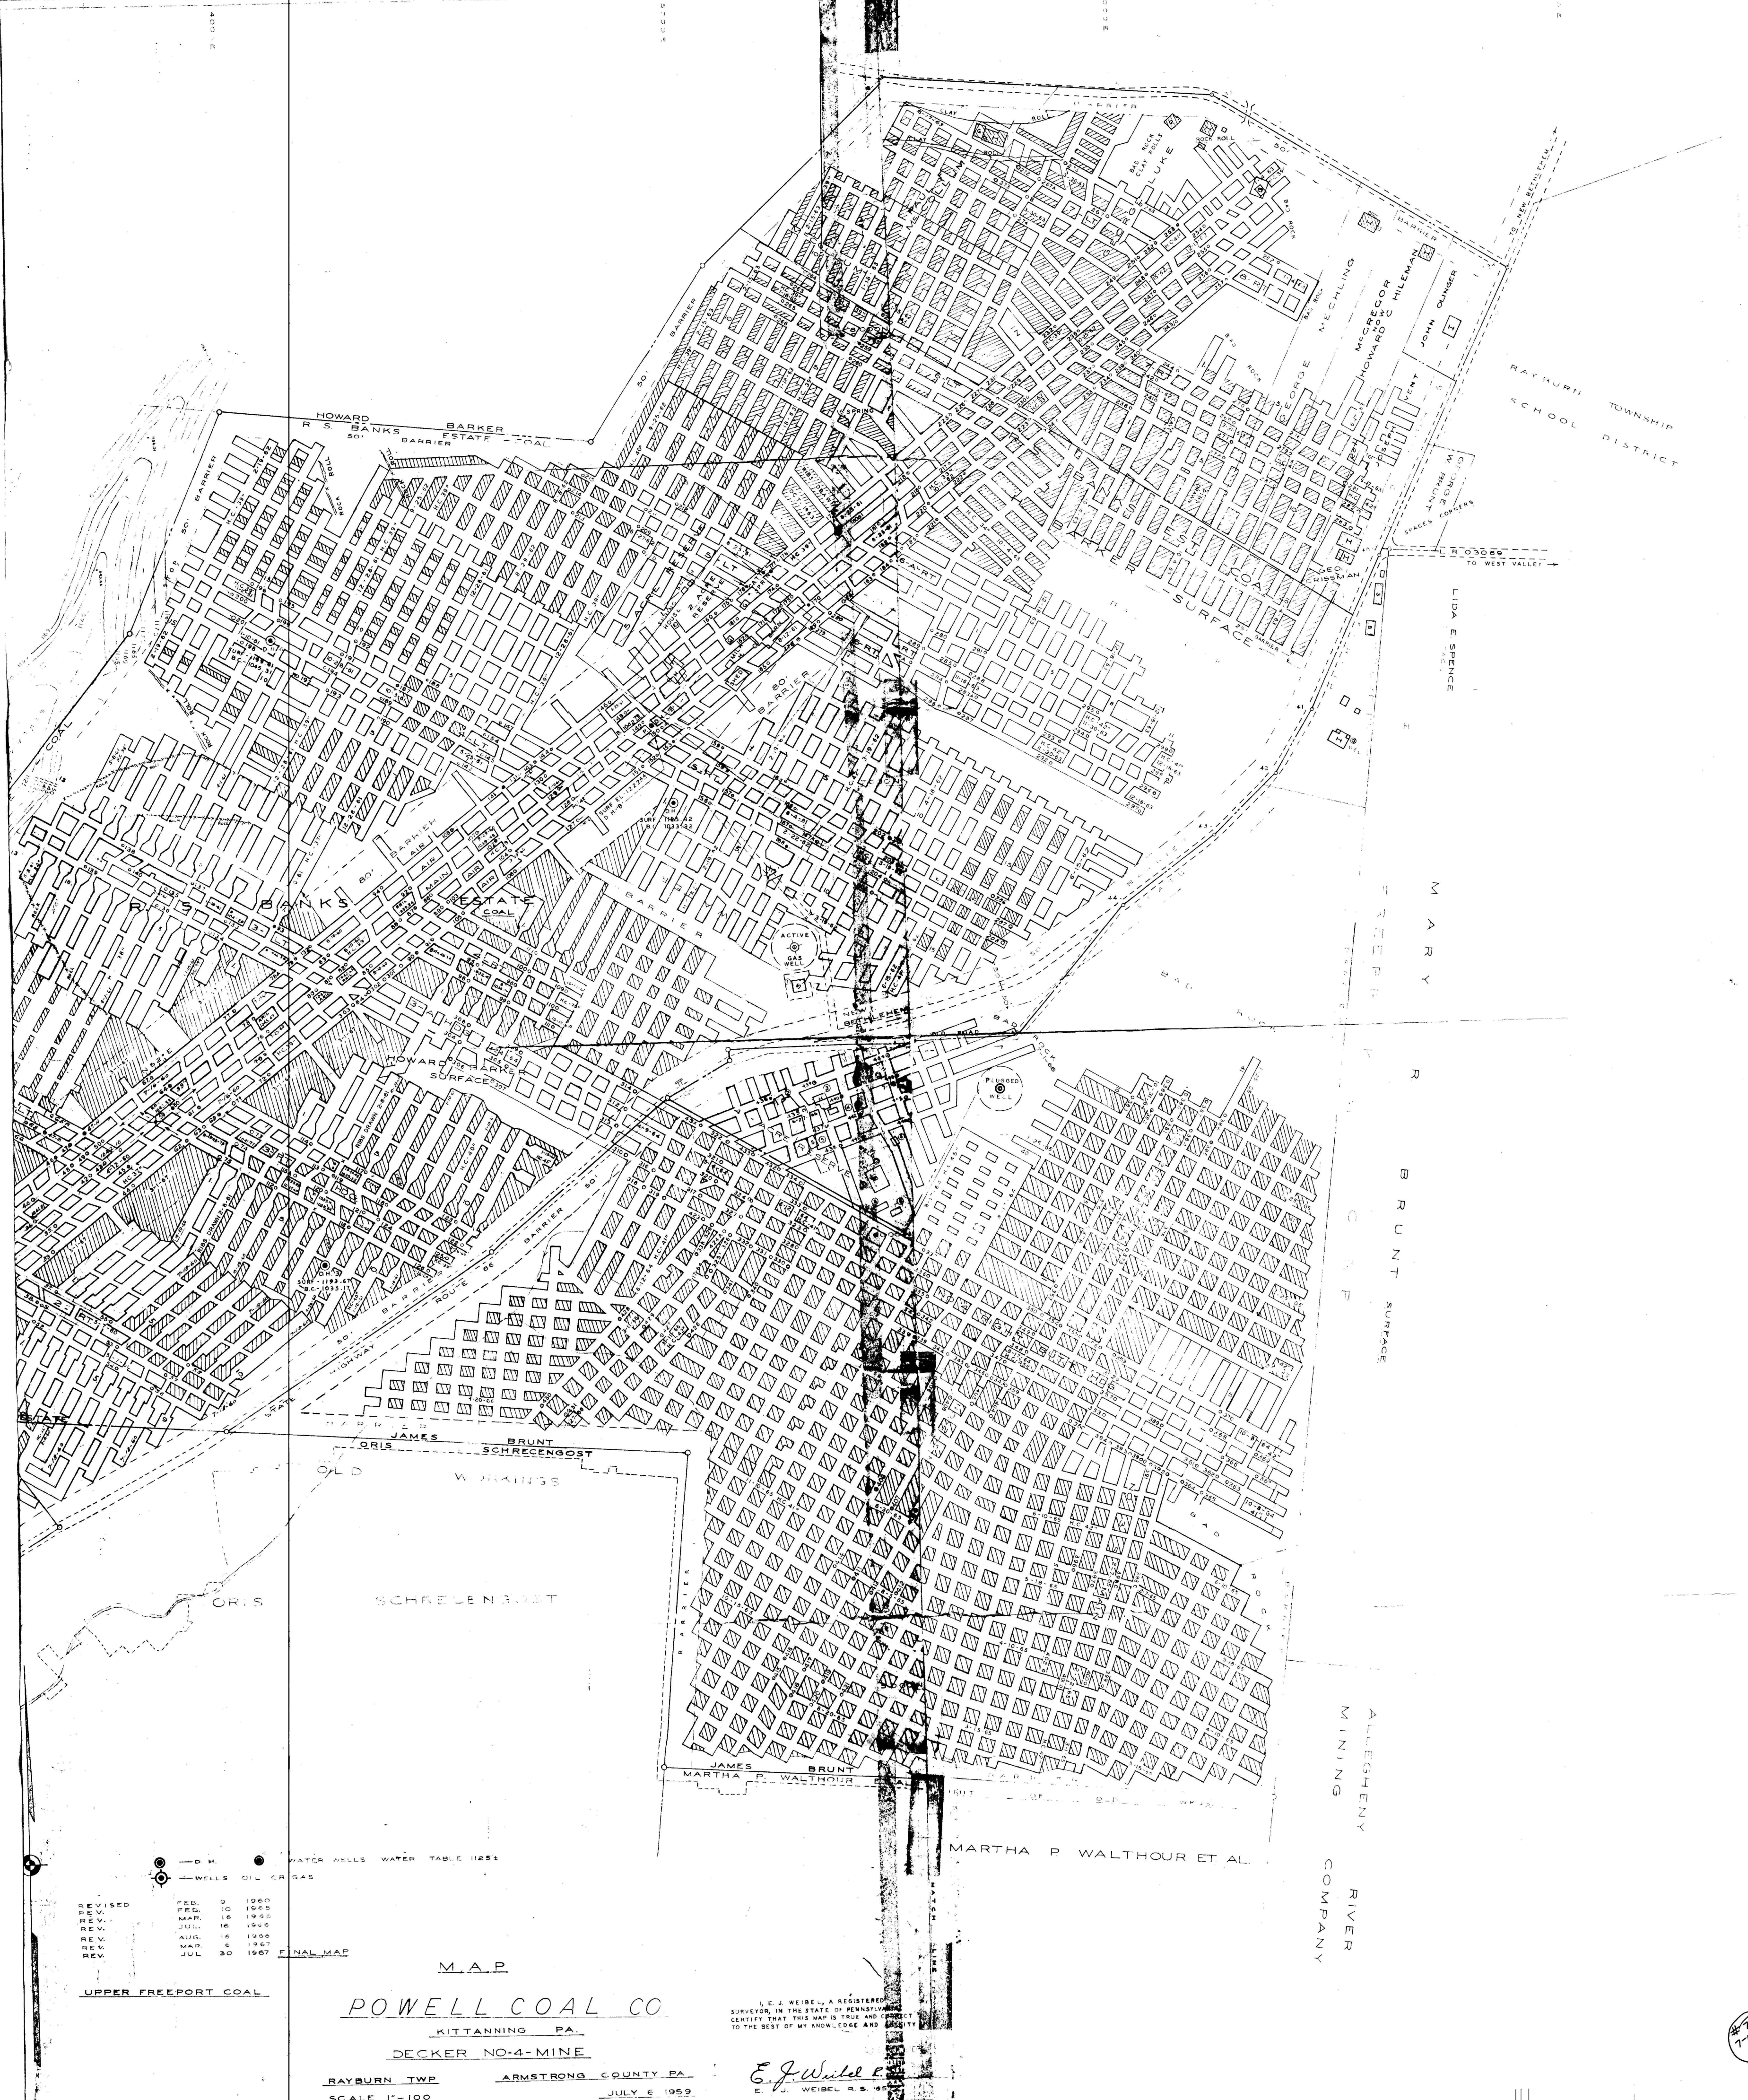

— D.H. — WATER WELLS WATER TABLE 11251
— WELLS OIL OR GAS

REVISED	DATE	BY
REV.	FEB. 9 1960	
REV.	FEB. 10 1963	
REV.	MAR. 16 1965	
REV.	JUL. 16 1966	
REV.	AUG. 16 1966	
REV.	MAR. 6 1967	
REV.	JUL. 30 1967	

FINAL MAP

UPPER FREEPORT COAL

M.A.P.
POWELL COAL CO.
KITTANNING PA.
DECKER NO. 4-MINE
RAYBURN TWP. ARMSTRONG COUNTY PA.
SCALE 1"=100' JULY 6 1959

I, E. J. WEIBEL, A REGISTERED
SURVEYOR, IN THE STATE OF PENNSYLVANIA,
CERTIFY THAT THIS MAP IS TRUE AND CORRECT
TO THE BEST OF MY KNOWLEDGE AND CREDIBILITY.

E. J. Weibel
E. J. WEIBEL R.S. 1959

ALLEGHENY RIVER
MINING COMPANY

MARTHA P. WALTHOUR ET AL.

RAYBURN TOWNSHIP
SCHOOL DISTRICT

LIDA E. SPENCE

MARY

R

BRUNT SURFACE

C

174.99
66