


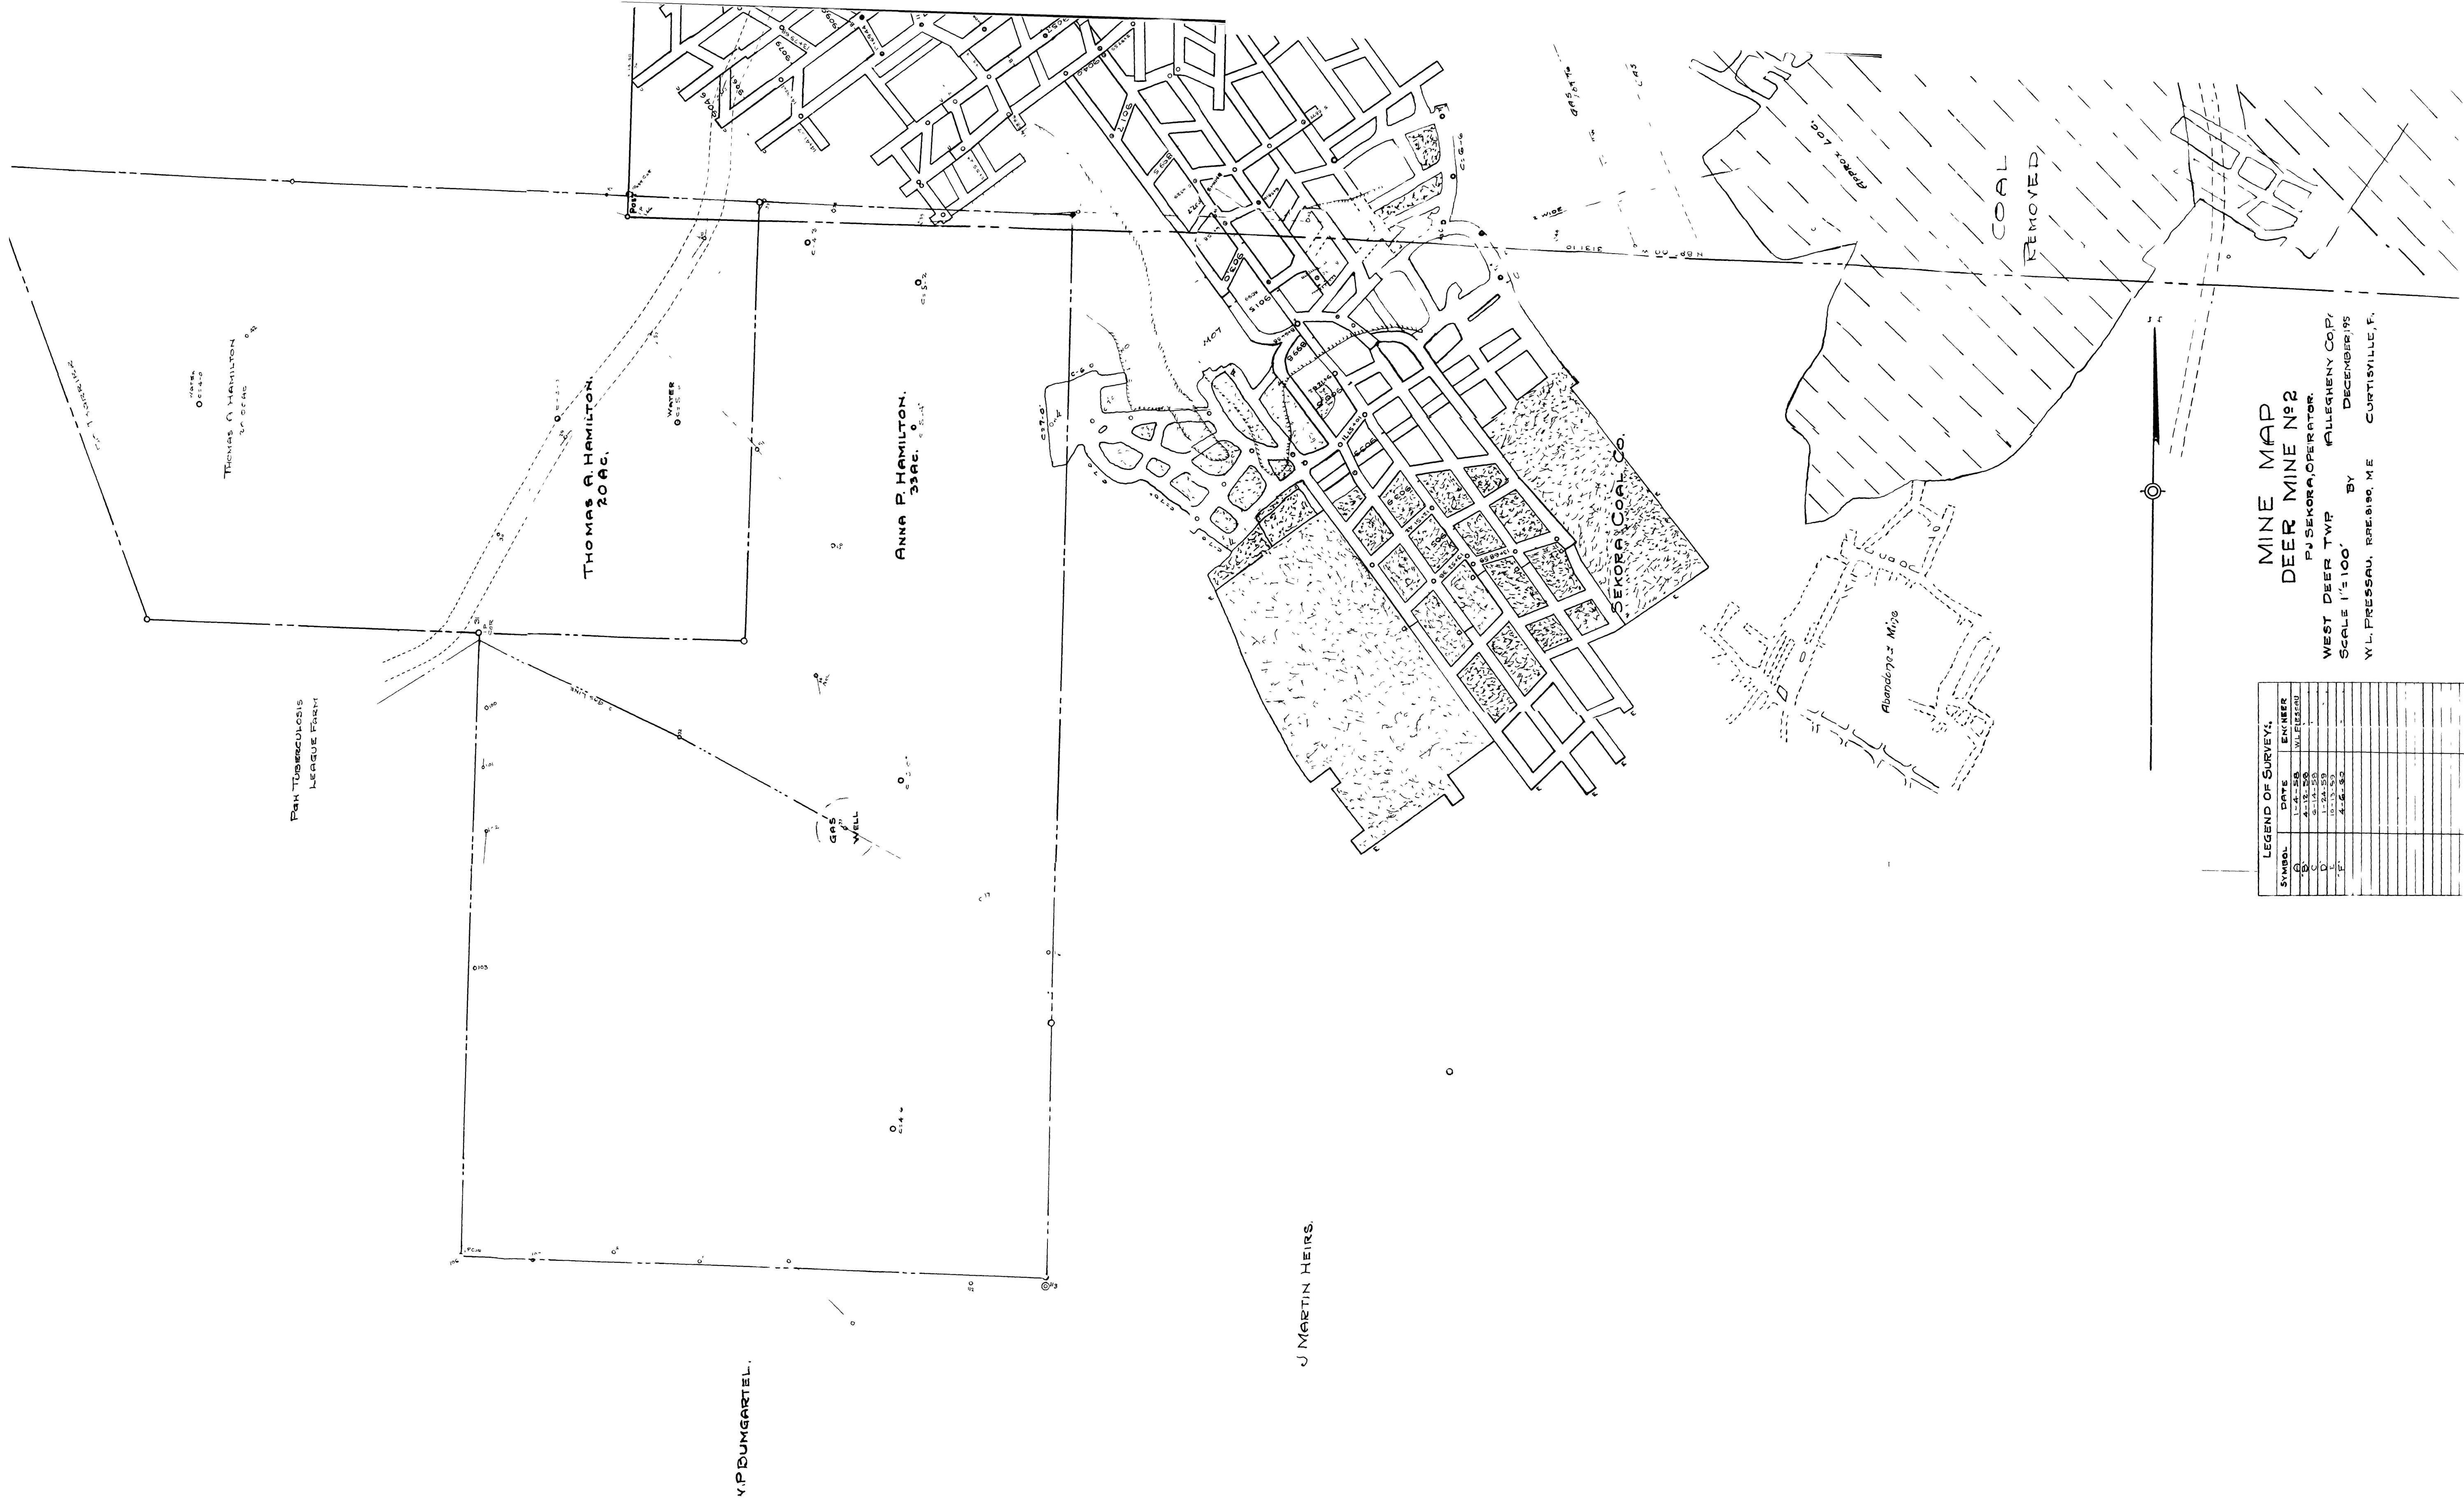

Legend of Survey		
Symbol	Date	Engineer
MINE MAP
DEER MINE No 2
P. J. SEKORA, OPERATOR.
WEST DEER TWP ALLEGHENY CO. PA
SCALE 1"=100' BY DECEMBER, 1958
W. L. PRESSAU, RAE, 1950, M.E. CURTISVILLE, F.