


MAP
OF
DELAWARE
NO 1
OPERATED BY THE
HUNTINGDON COAL CO.

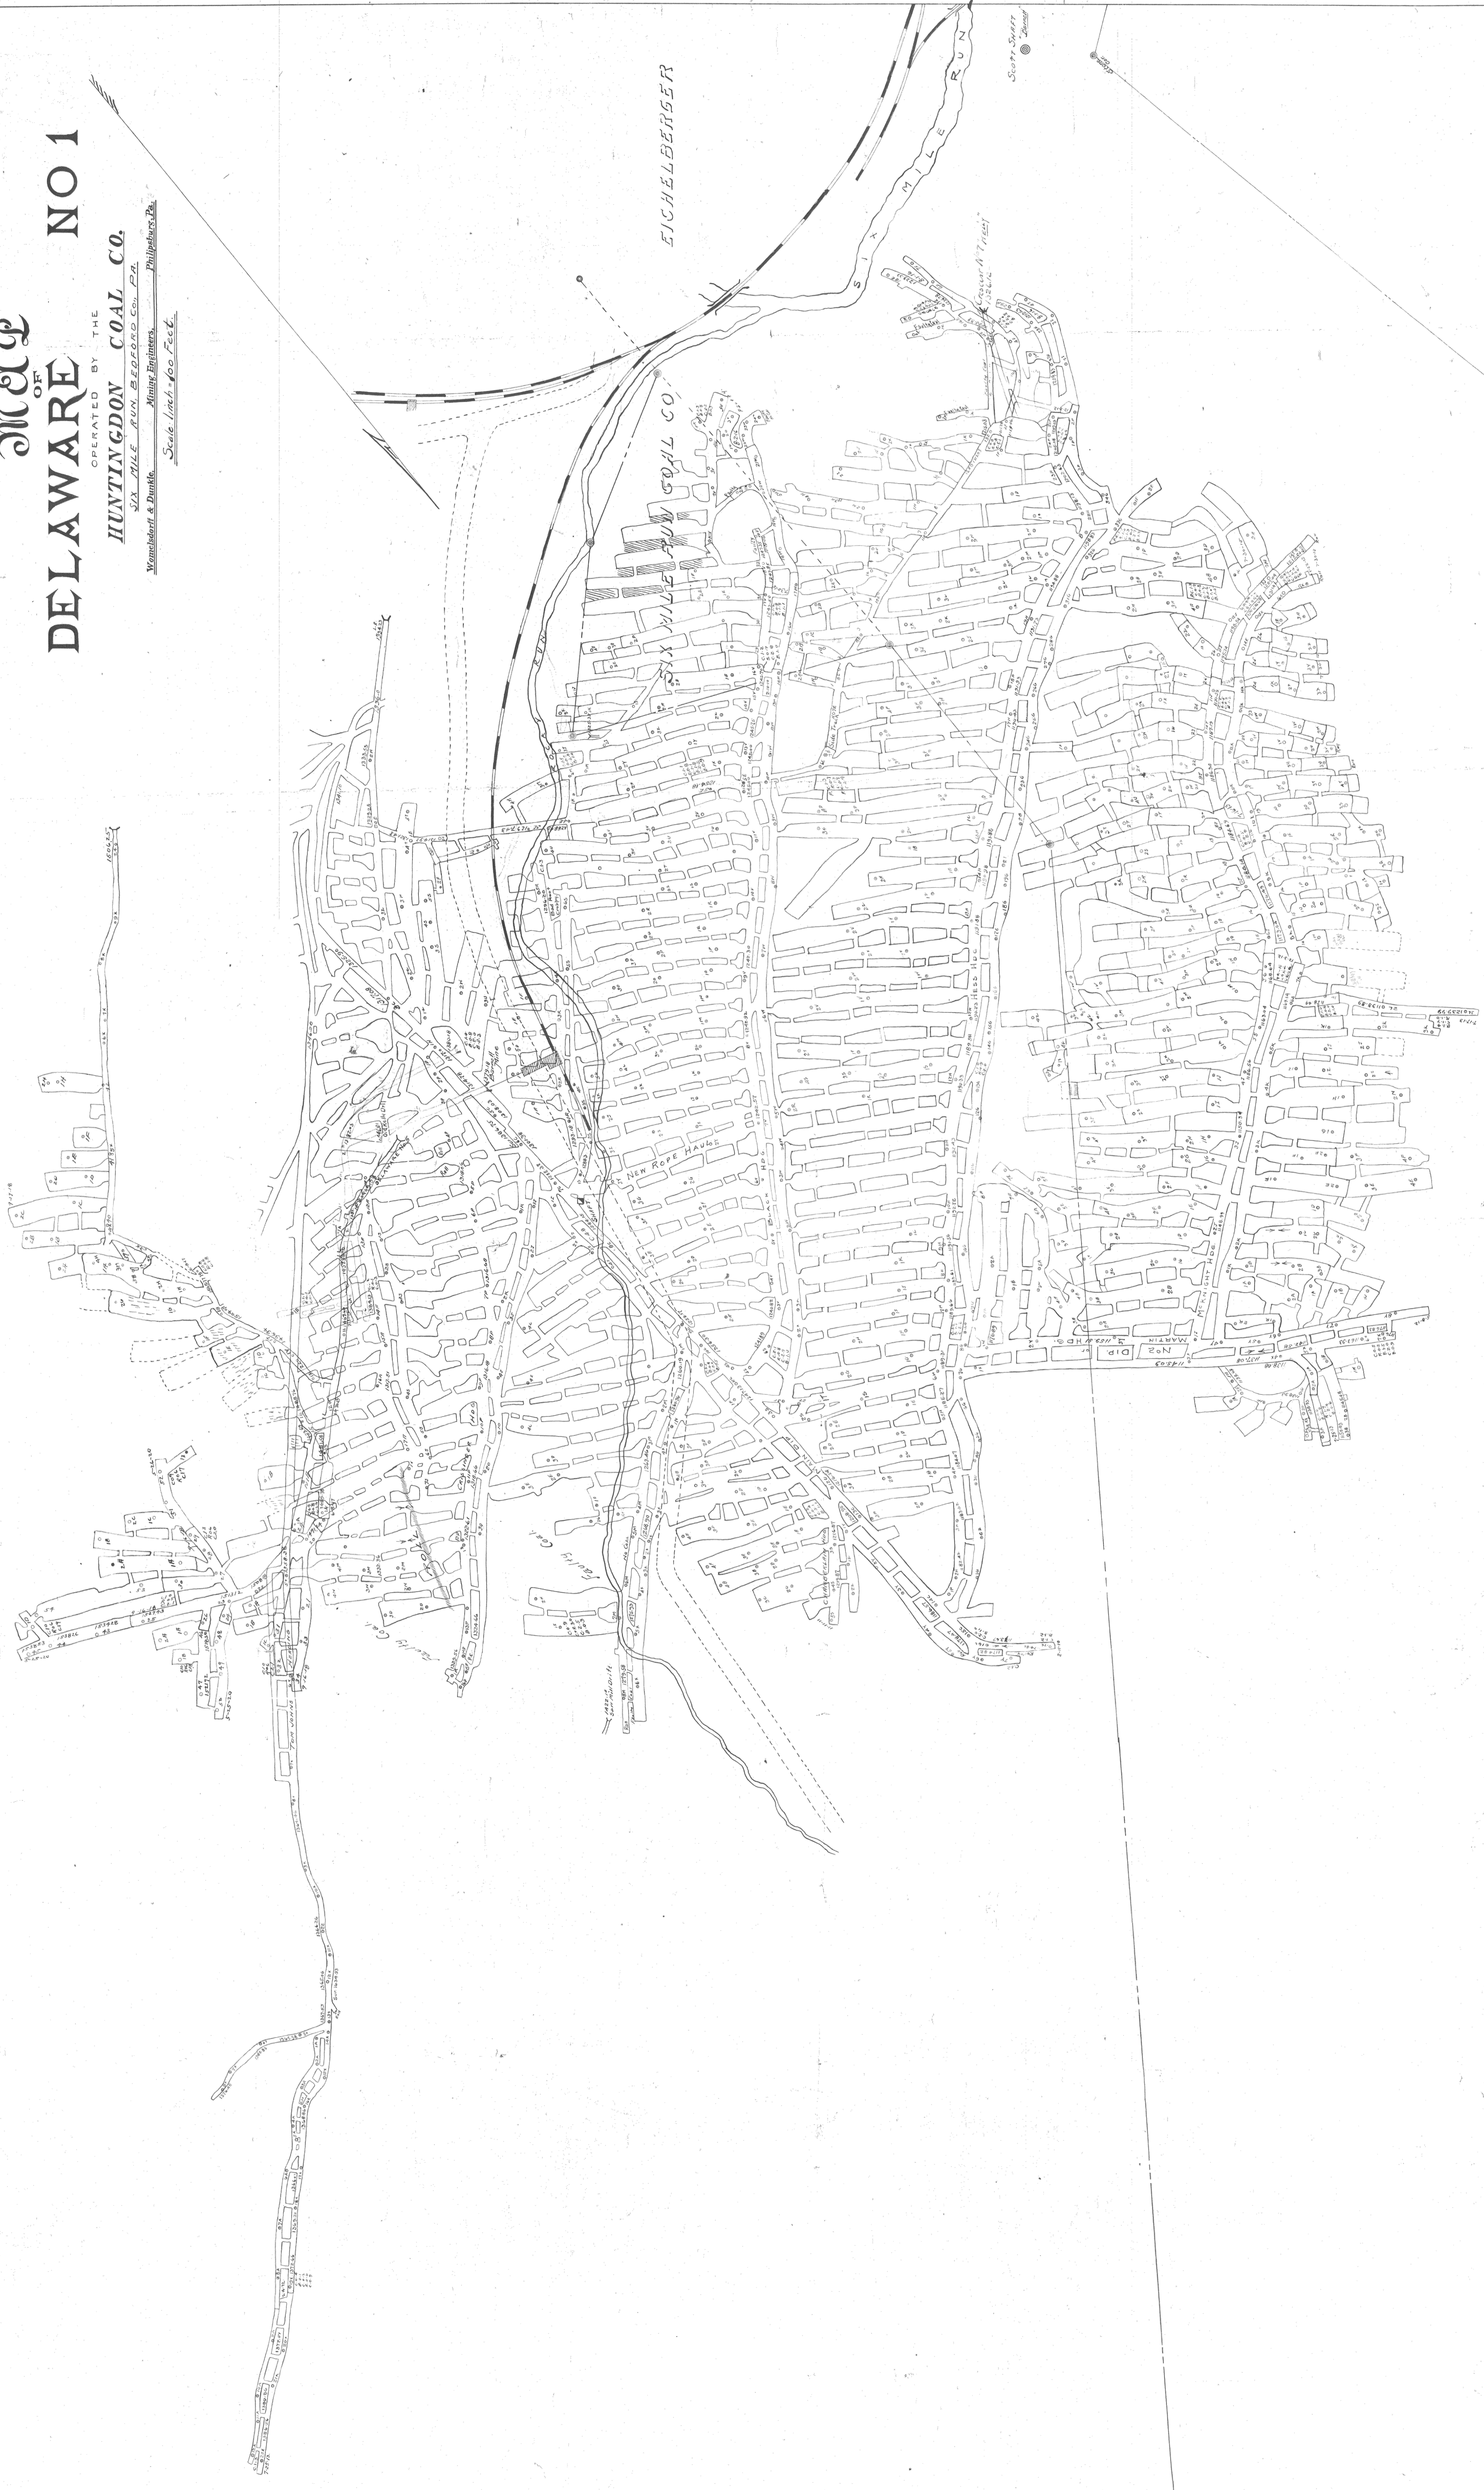


