
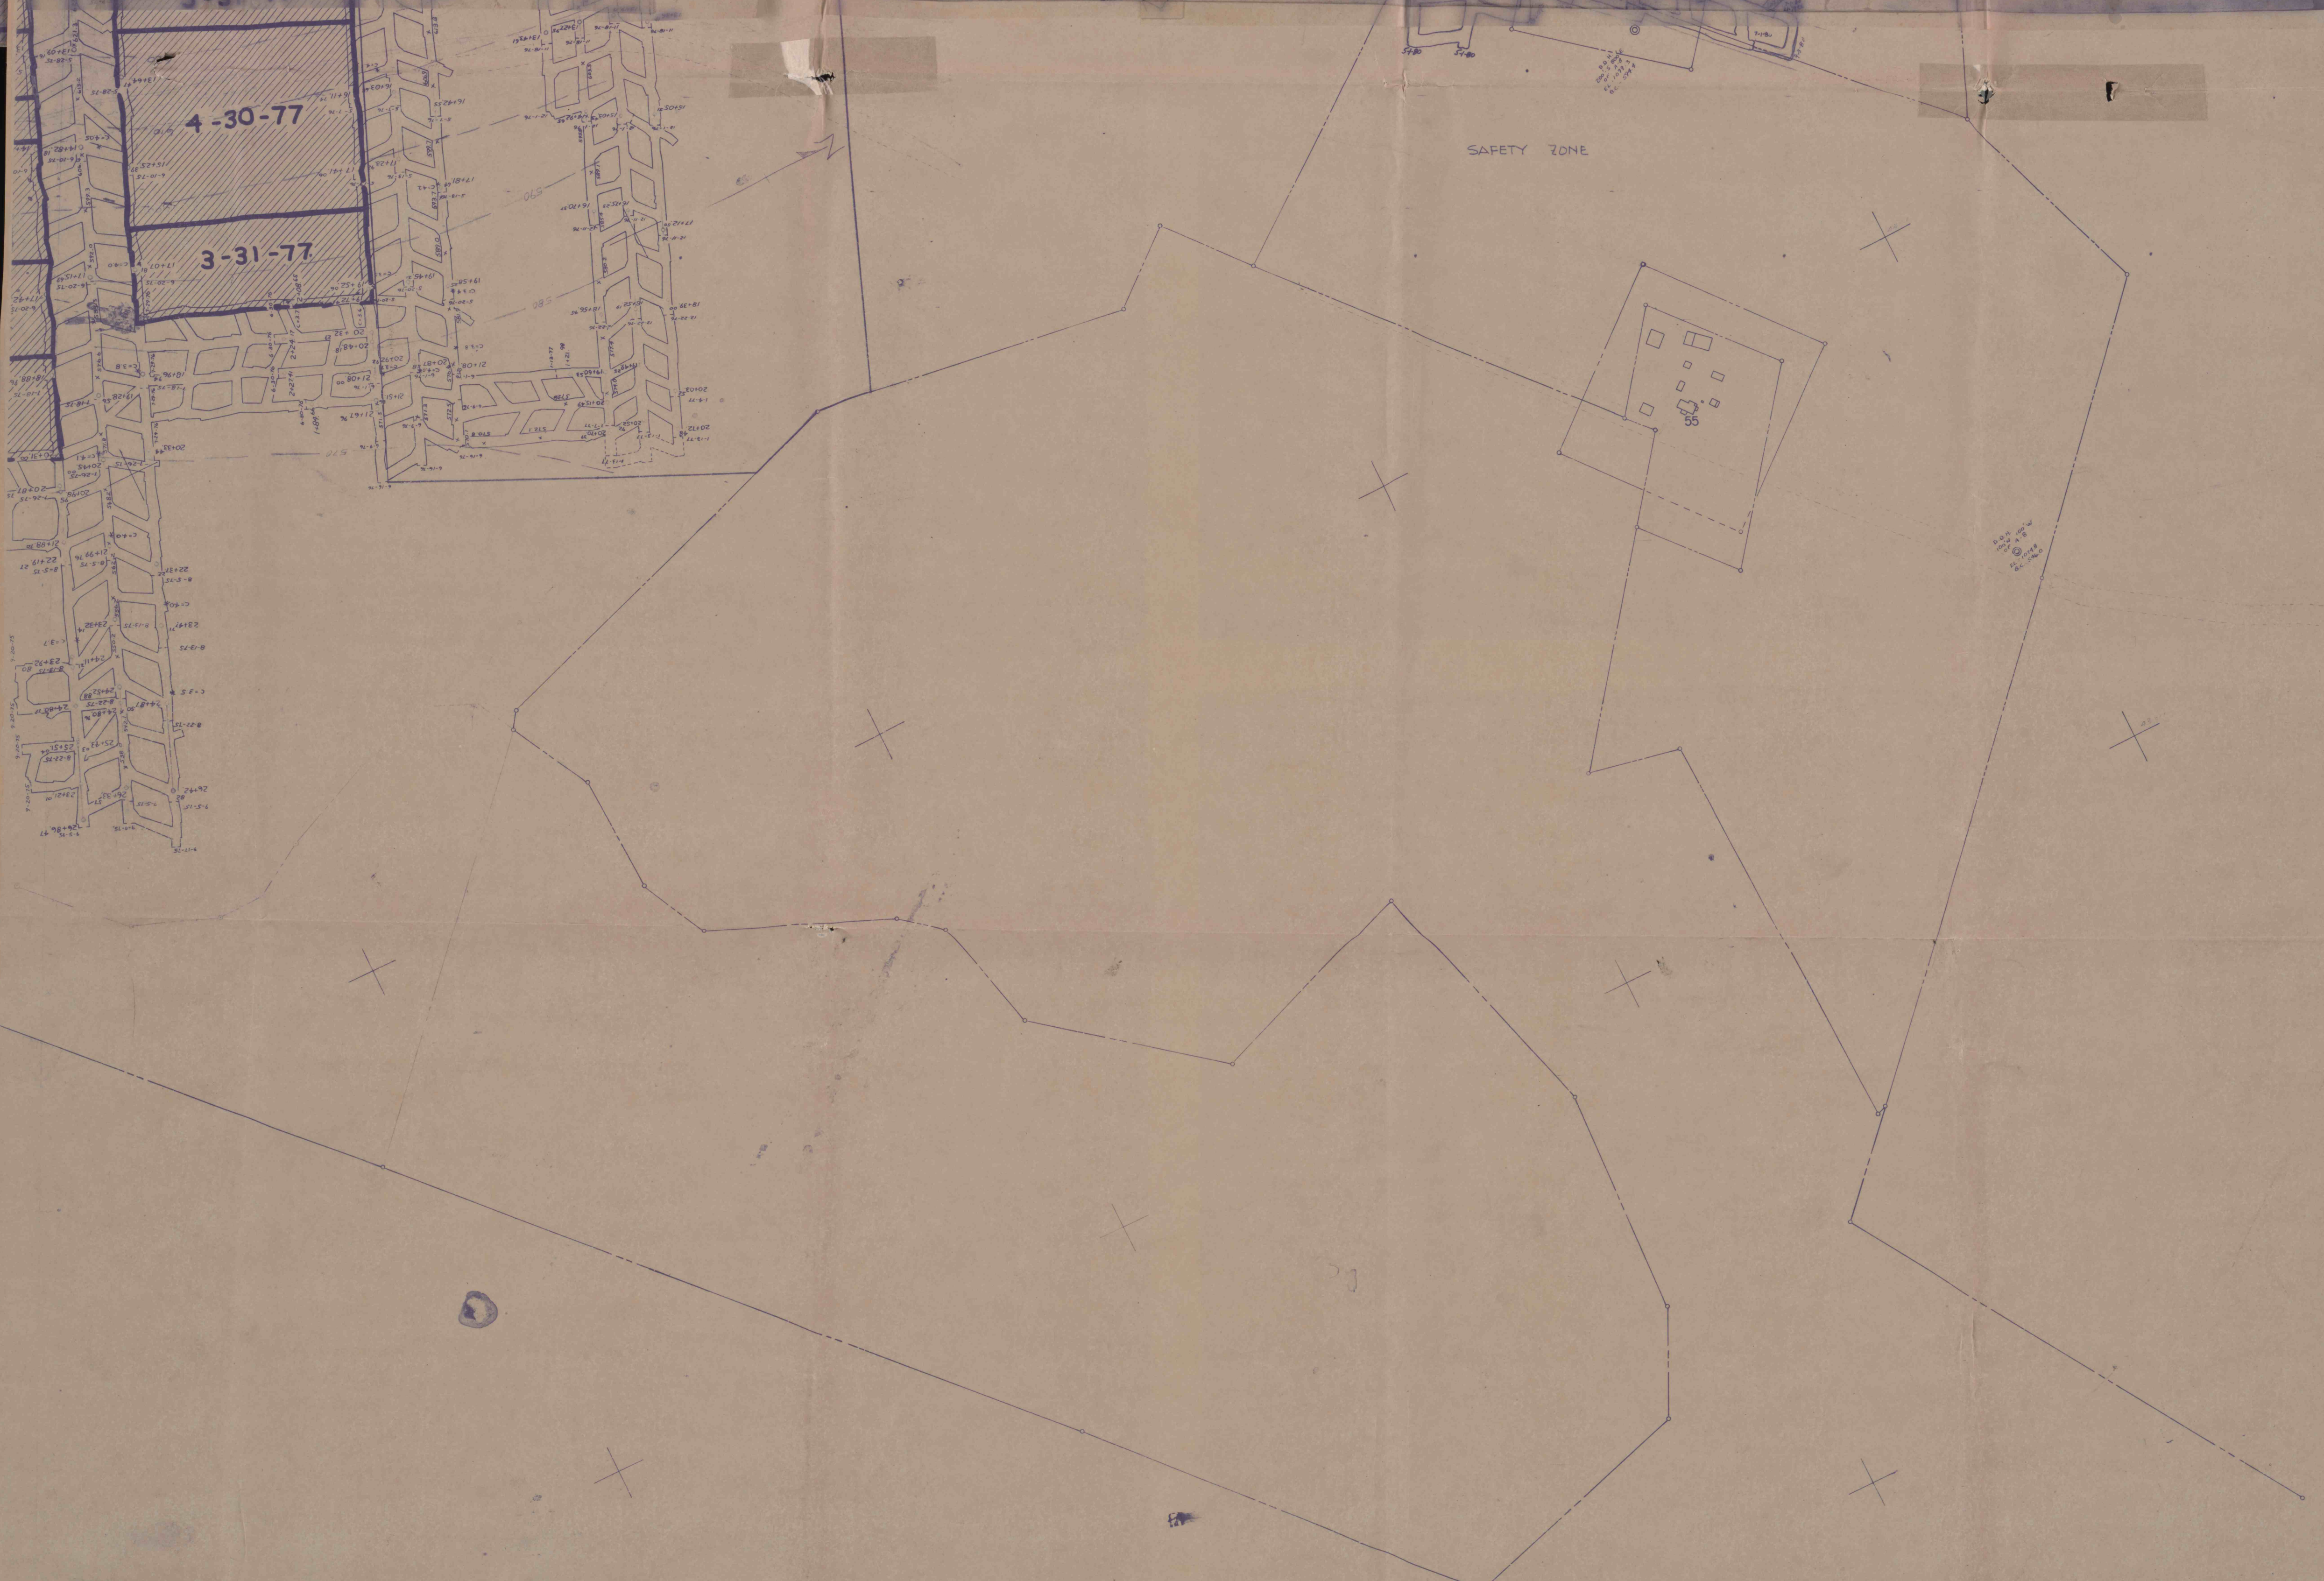


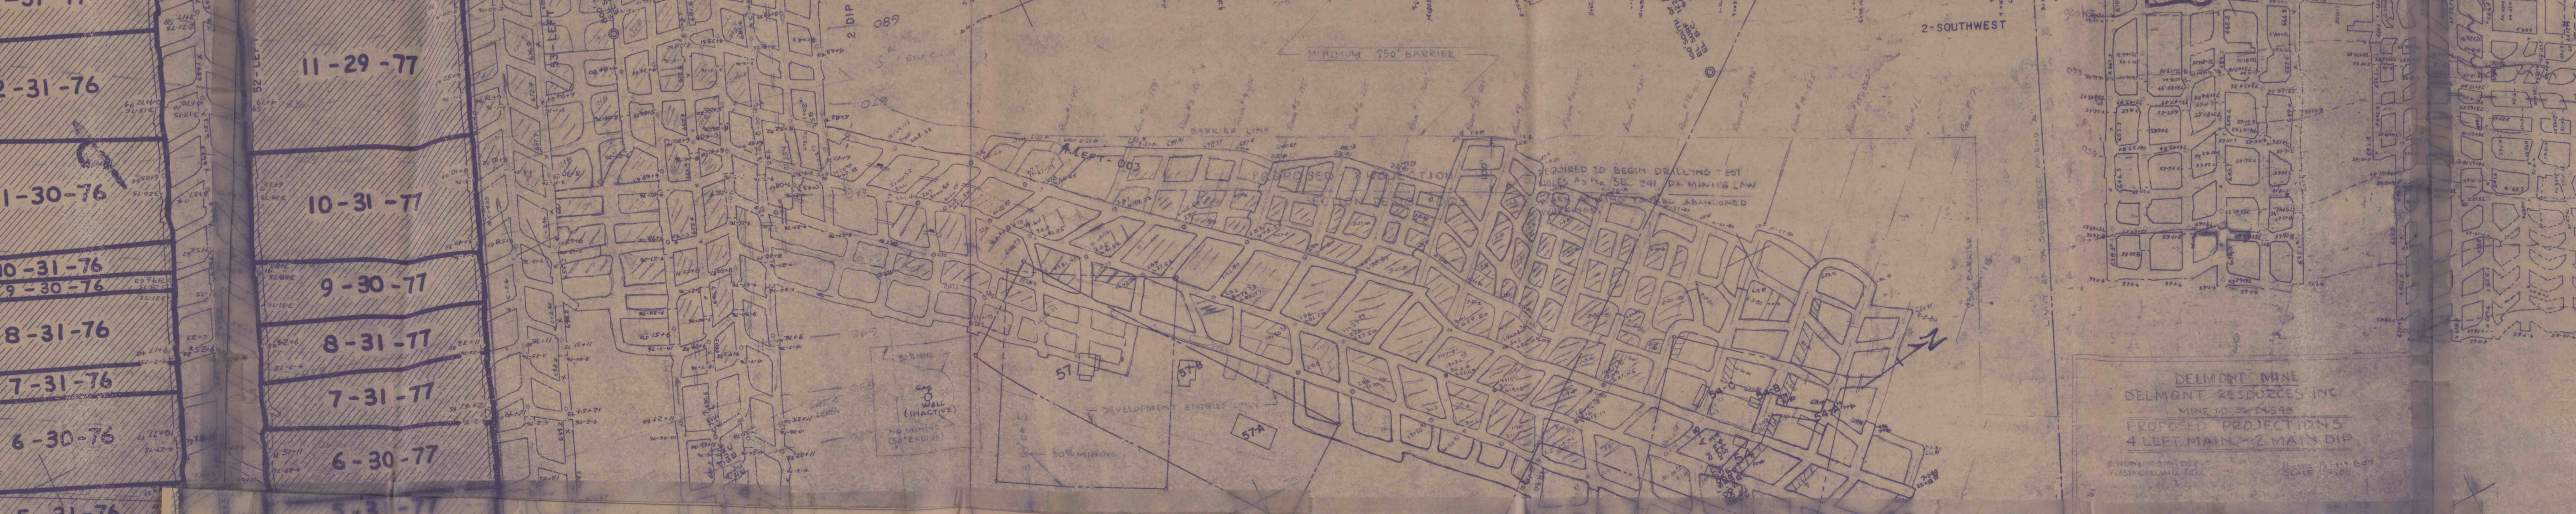

387490 11