


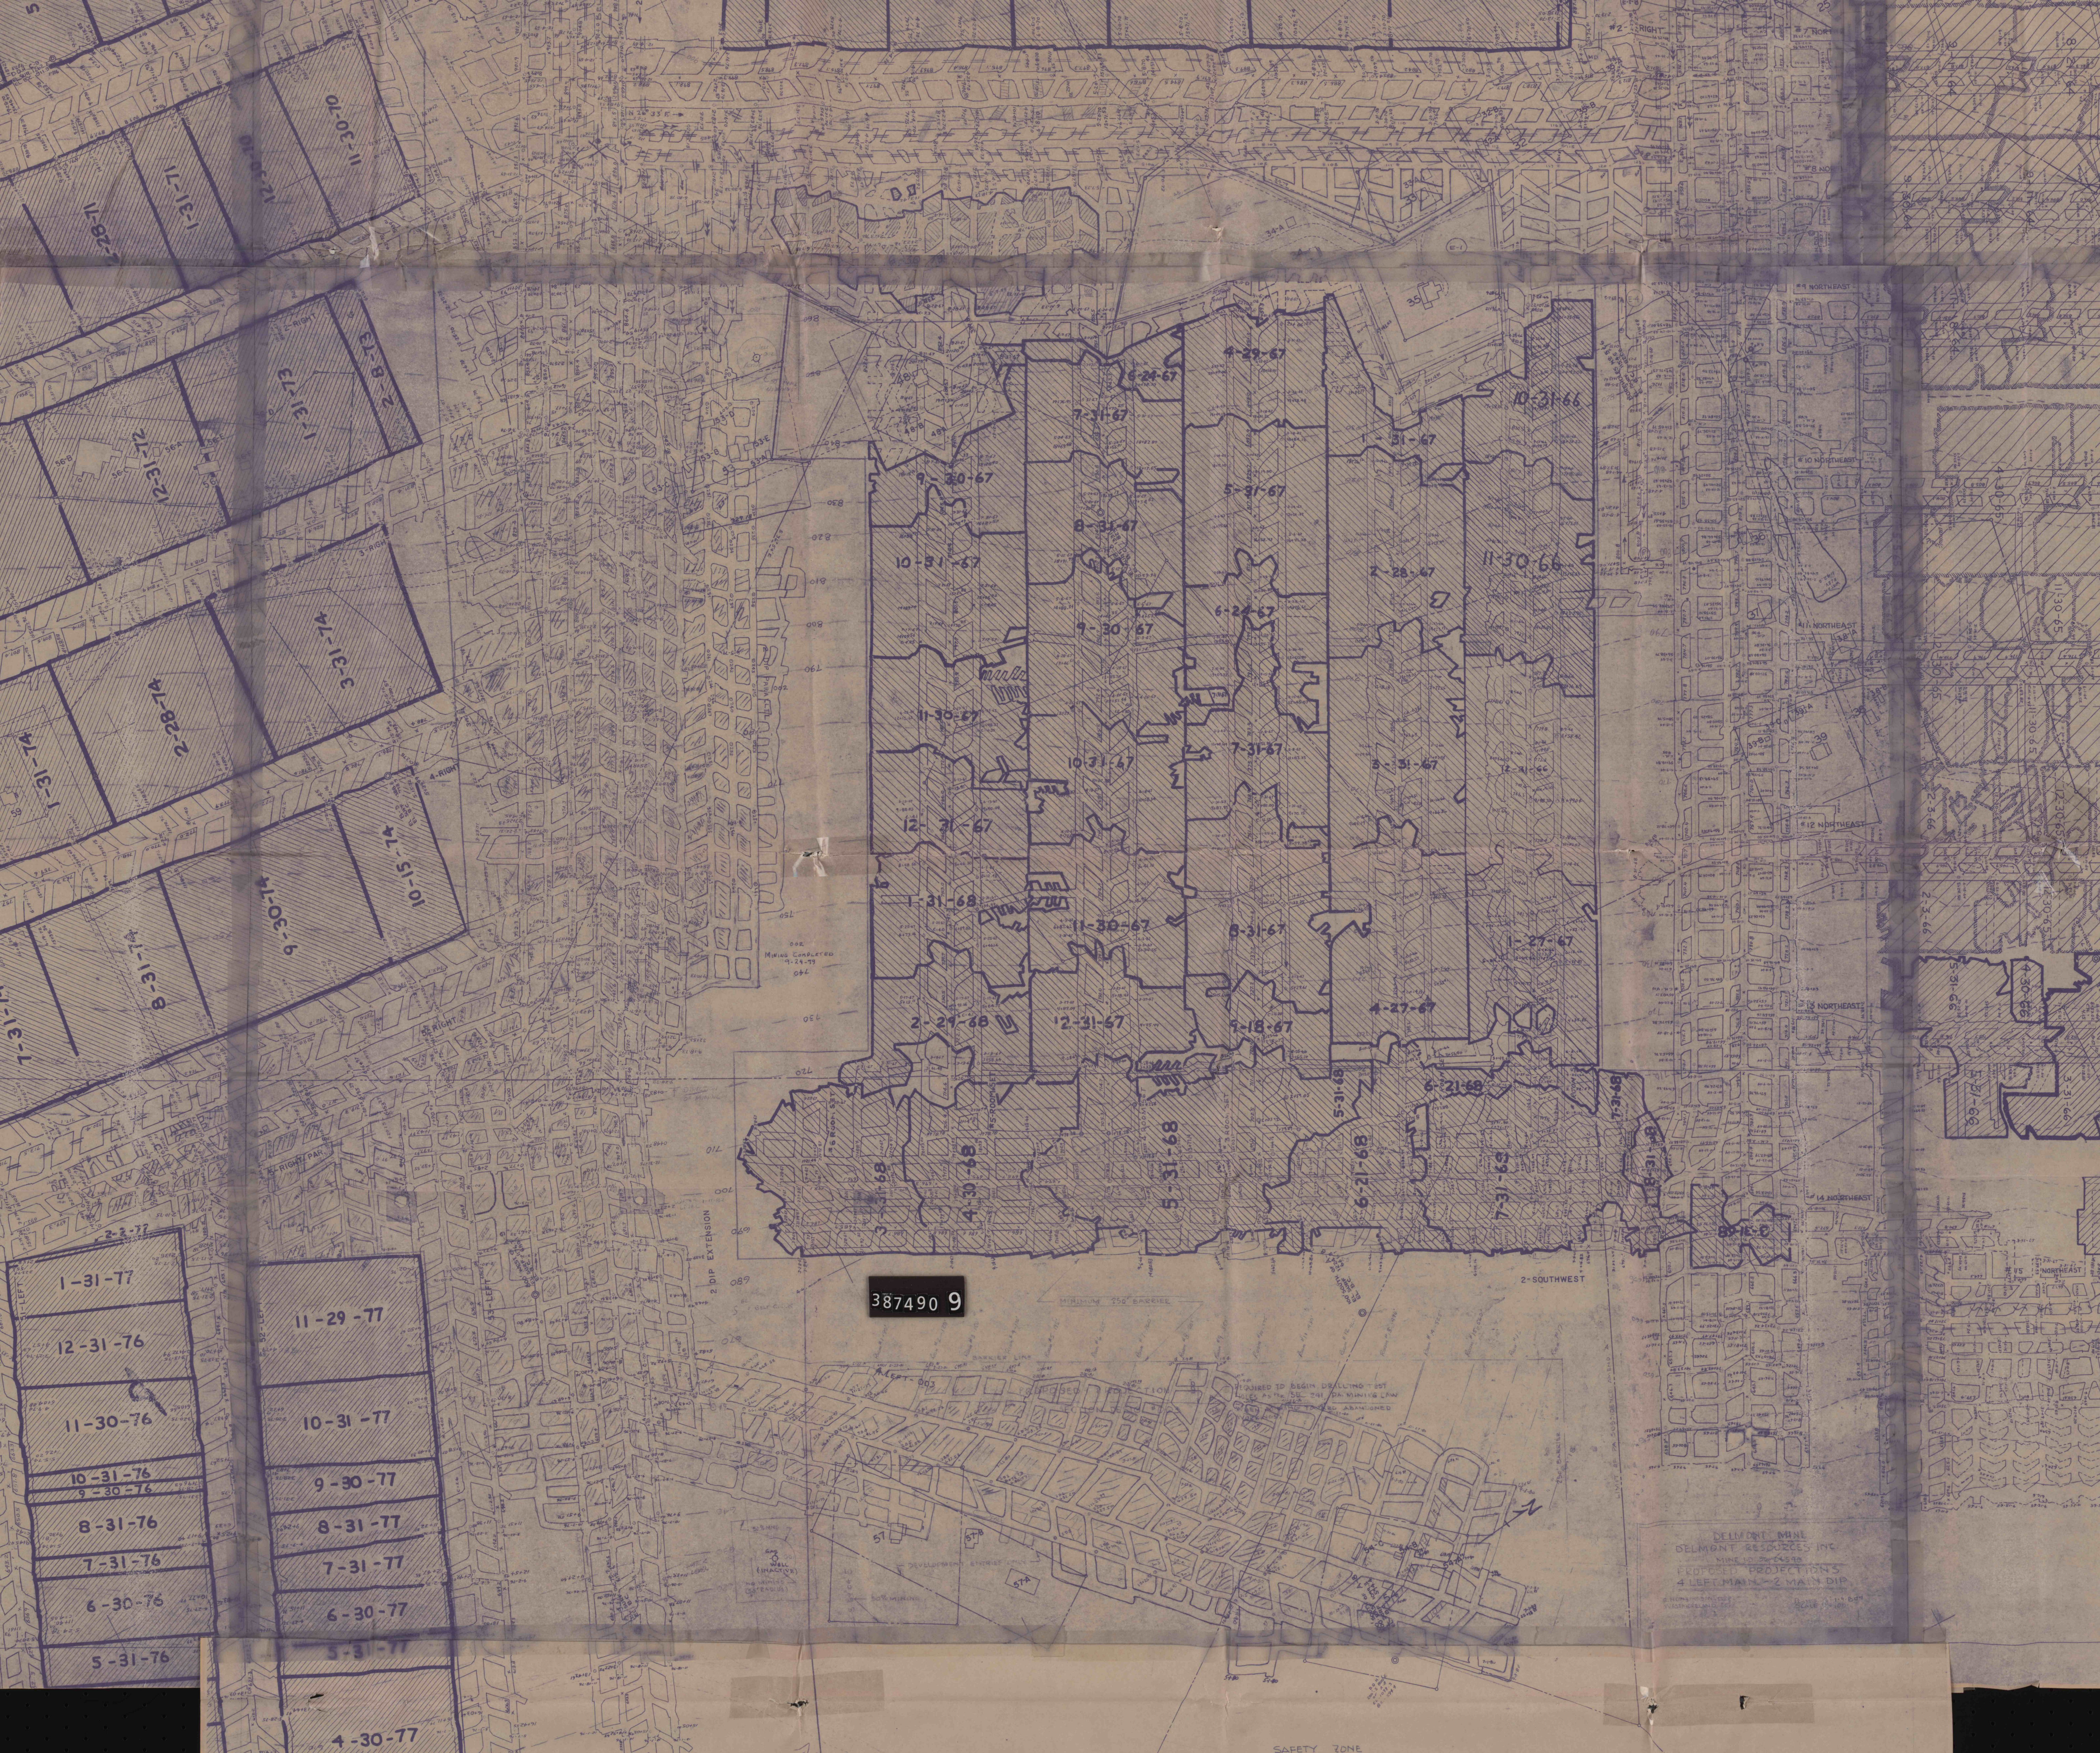

387490 9

DELMONT MINE
DELMONT RESOURCES INC.
MINE ID: 20-0450
PROPOSED PROJECTIONS
4 LEFT MAIN - 2 MAIN DIP

SAFETY ZONE