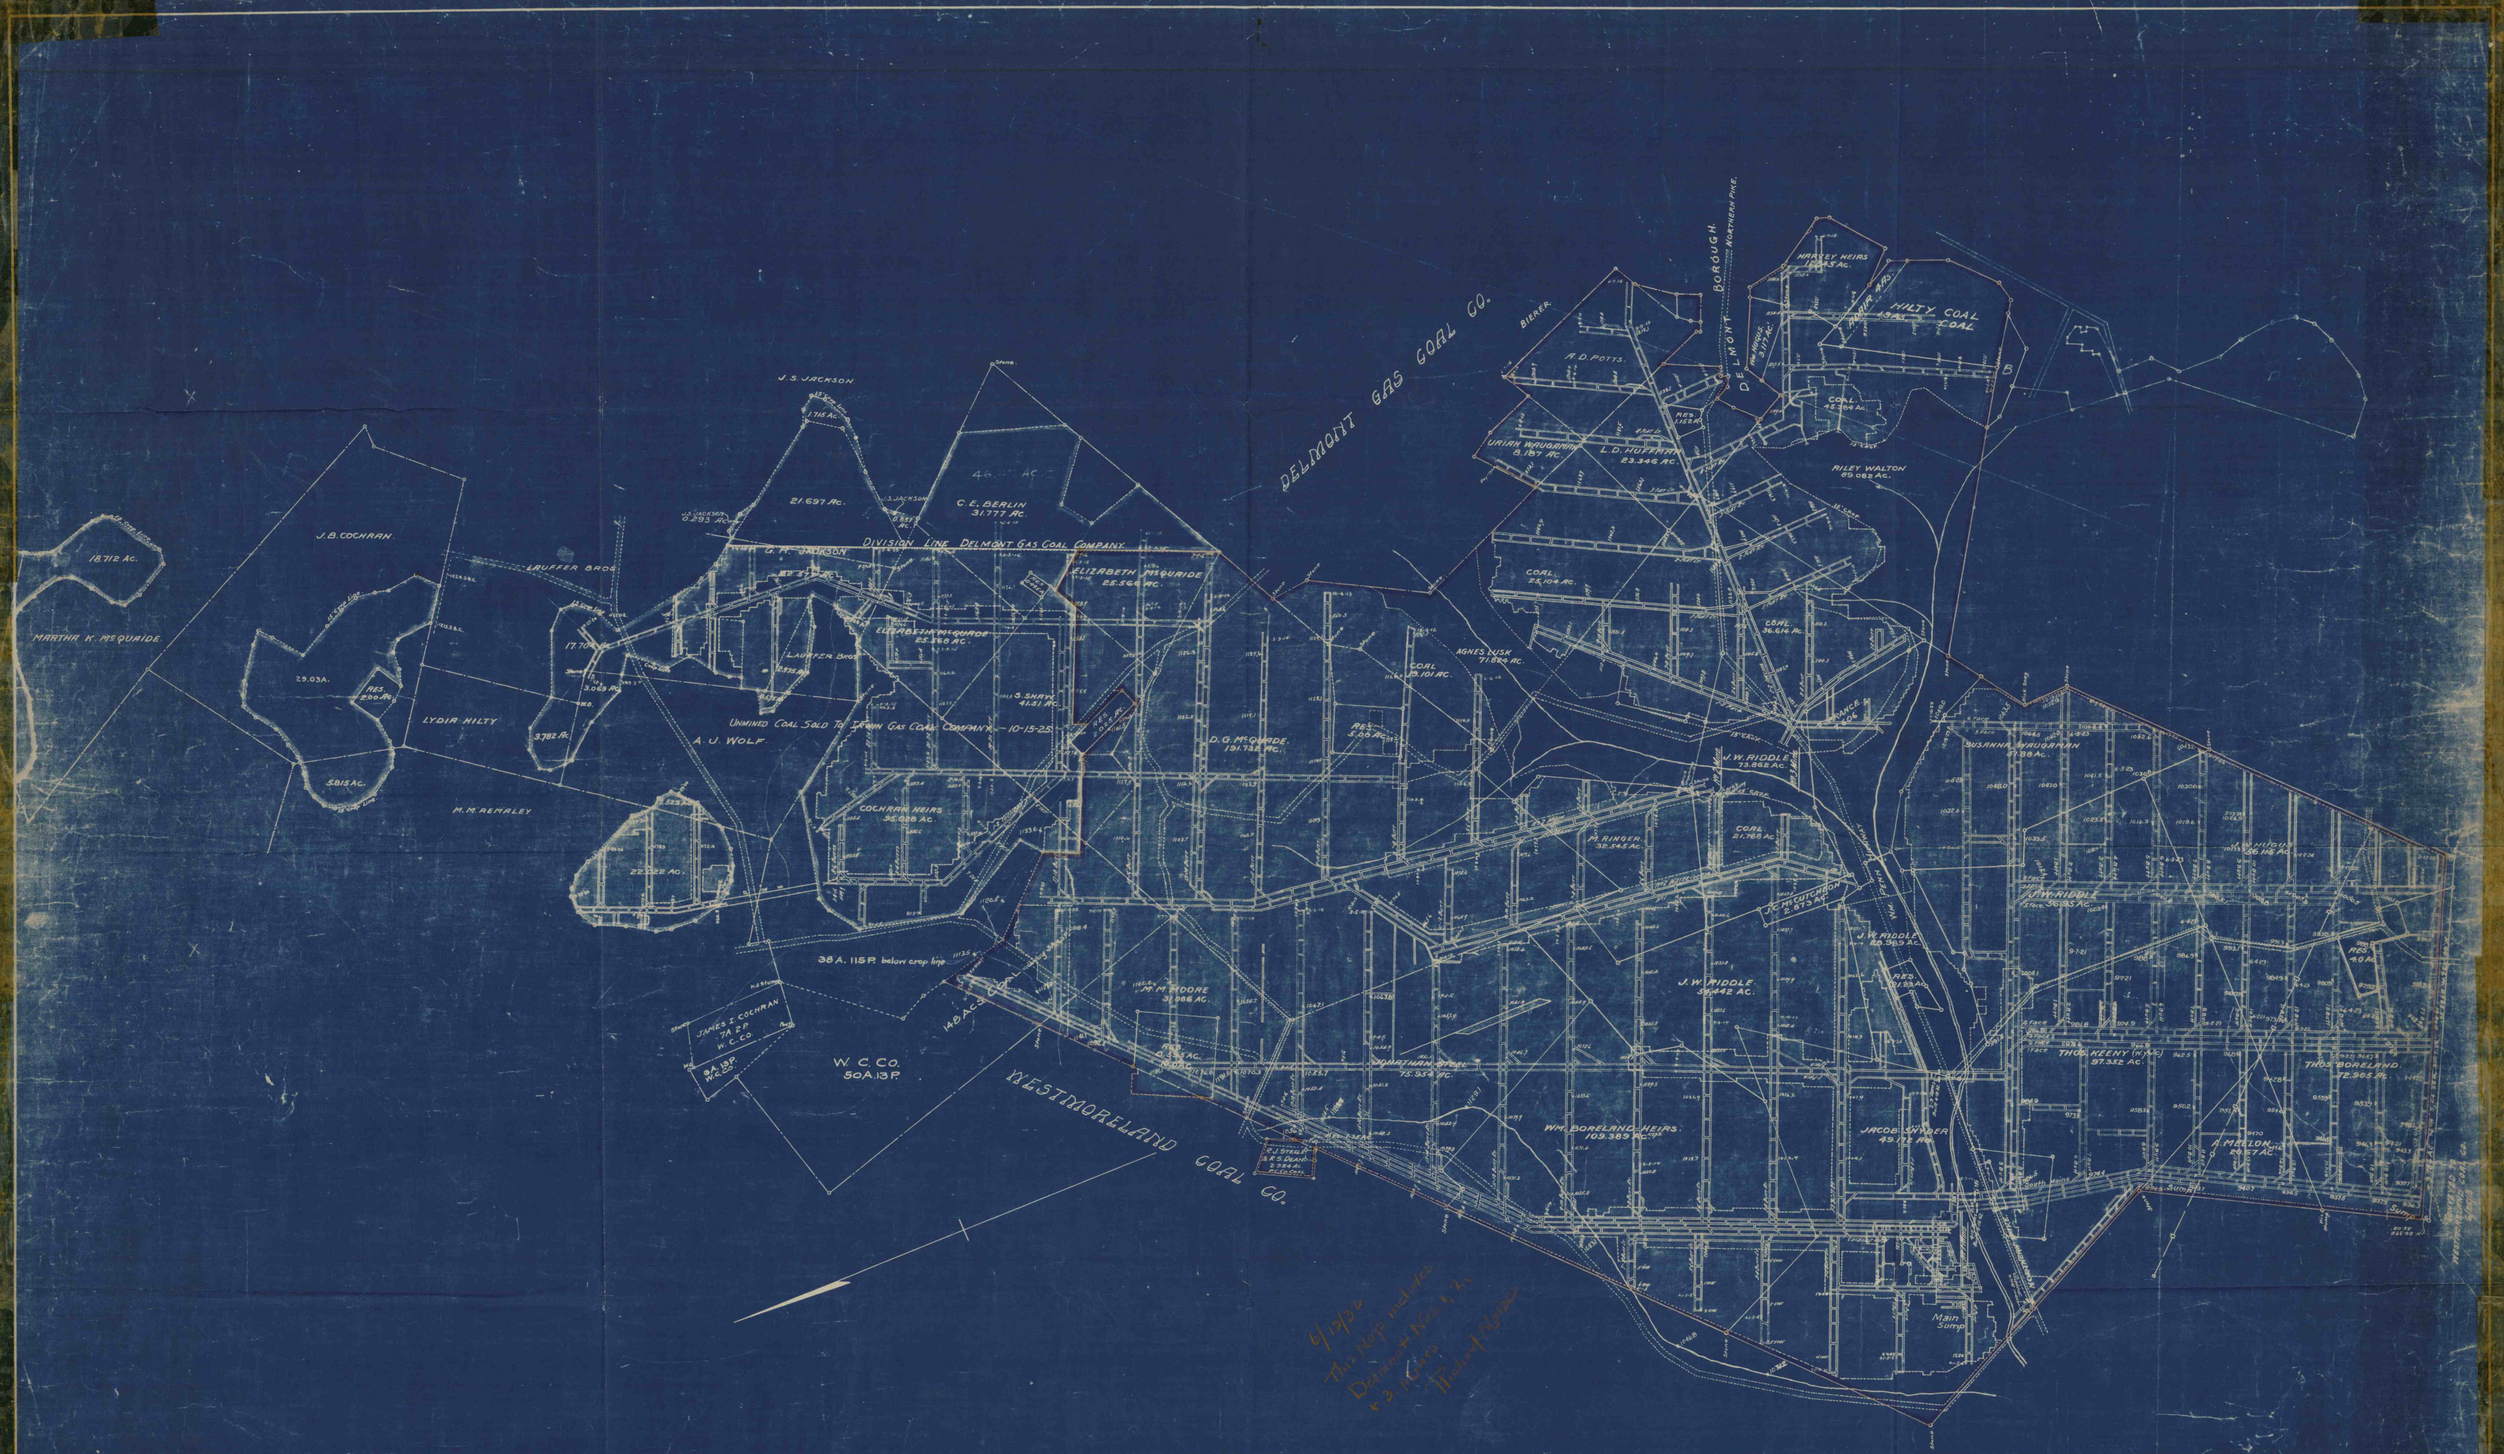

Pittsburgh Coal Company

Plan showing Delmont Mines

Situated in Franklin and Salem Townships

Westmoreland Co.-Penna.

Scale. 1 in.-400 ft.

I hereby certify this is a true and correct copy of the mine workings as of March 26, 1932.

E.W. Taylor

CHIEF ENGINEER