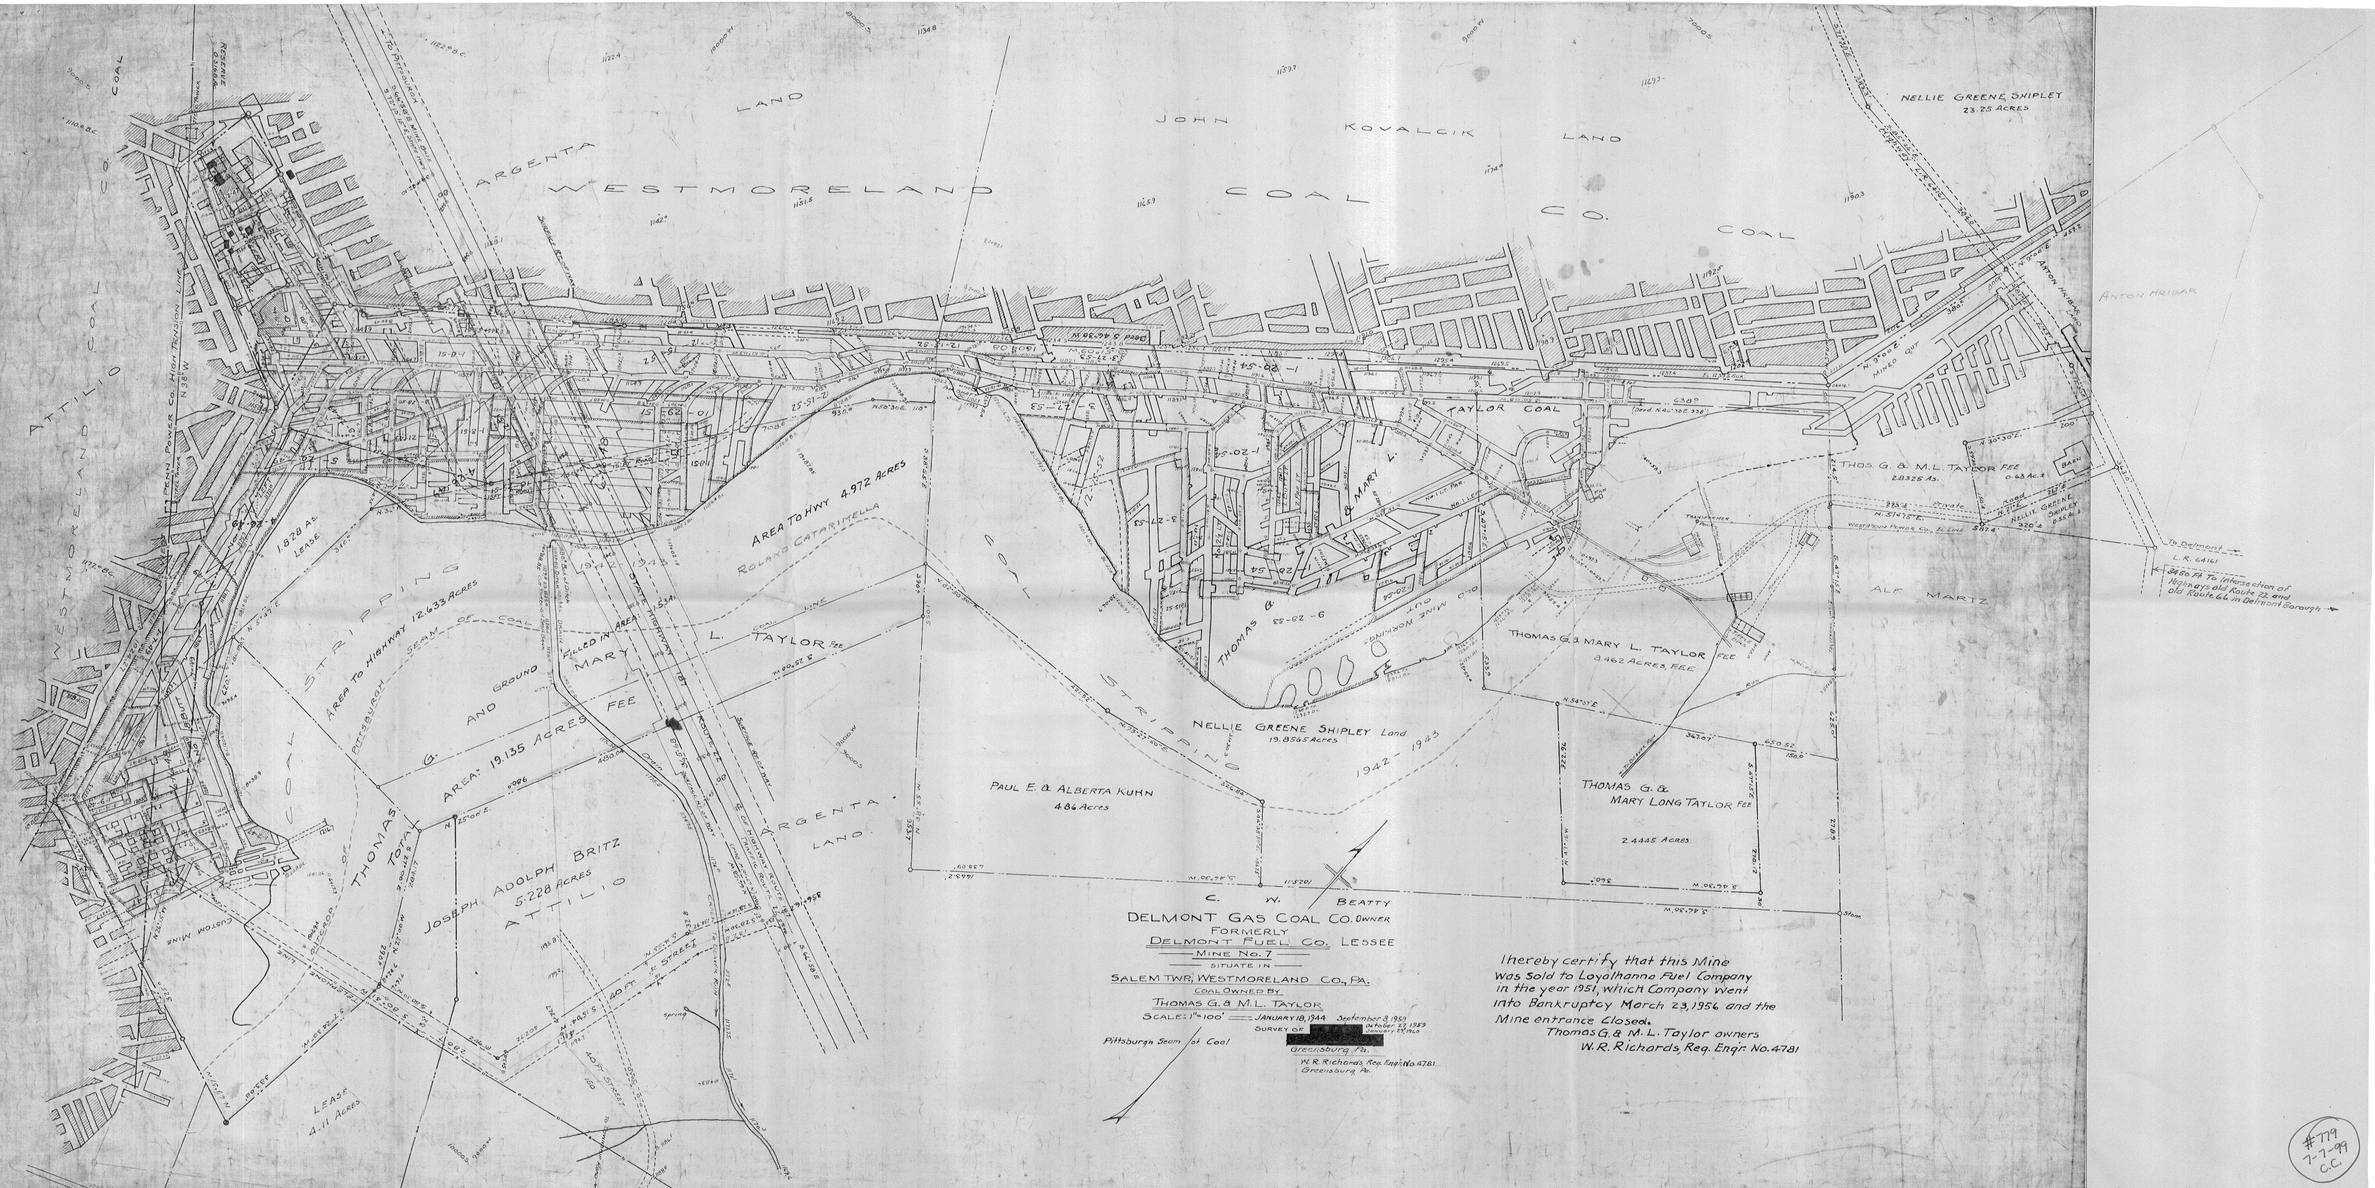

WESTMORELAND COAL CO.
ATTILIO LAND
ARGENTA LAND
JOHN KOVALCIK LAND
NELLIE GREENE SHIPLEY 23.25 ACRES
ANTON HRIBAR
ALF MARTZ
TO ARGENTA
TO ATTILIO
PENN POWER CO. HIGH TENSION LINE N.S.W.
STATE HIGHWAY ROUTE 22
OLD ROUTE 22
AREA TO HIGHWAY 12.633 ACRES
Pittsburgh SEAM OF COAL
AREA TO HWY 4.972 ACRES
ROLAND CATARINELLA
FILLED IN AREA
COAL STRIPPING
1942 - 1943
MARY L. TAYLOR FEE
AREA: 19.135 ACRES FEE
G. AND
1.020 AS. LEASE
THOMAS G. & MARY L. TAYLOR
NELLIE GREENE SHIPLEY Land 19.858 Acres
PAUL E. & ALBERTA KUHN 4.84 Acres
THOMAS G. & MARY L. TAYLOR FEE 3.462 ACRES. FEE.
THOMAS G. & MARY LONG TAYLOR FEE 2.4445 ACRES
THOS. G. & M.L. TAYLOR FEE 2.8326 As.
0.63 Ac.±
NELLIE GREENE SHIPLEY 0.58 Ac.±
TAYLOR COAL
THOMAS & MARY L. TAYLOR FEE
THOMAS G. & MARY L. TAYLOR FEE
THOMAS TOTAL
JOSEPH ADOLPH BRITZ 5.228 ACRES
ATTILIO
LEASE 4.11 ACRES
CUSTOM MINE
OLD MINE WORKINGS
MINED OUT
BARN
HOUSE
To Belmont
L. R. 64141
3600 Ft. To Intersection of Highways old Route 22 and old Route 66 in Belmont Borough
C. N. BEATTY
DELMONT GAS COAL CO. OWNER
FORMERLY
DELMONT FUEL CO. LESSEE
MINE No. 7
SITUATE IN
SALEM TWP, WESTMORELAND CO., PA.
COAL OWNED BY
THOMAS G. & M.L. TAYLOR
SCALE: 1" = 100'
JANUARY 18, 1944 September 8 1949
SURVEY OF [redacted] October 27 1949 January 19 1950
Greensburg Pa.
W.R. Richards Reg. Engr. No. 4781 Greensburg Pa.
Pittsburgh Seam of Coal
I hereby certify that this Mine Was Sold to Loyalhanna Fuel Company in the year 1951, which Company Went into Bankruptcy March 23, 1956 and the Mine entrance Closed.
Thomas G. & M. L. Taylor owners
W. R. Richards, Reg. Engr. No. 4781

#779
7-7-99
C.C.