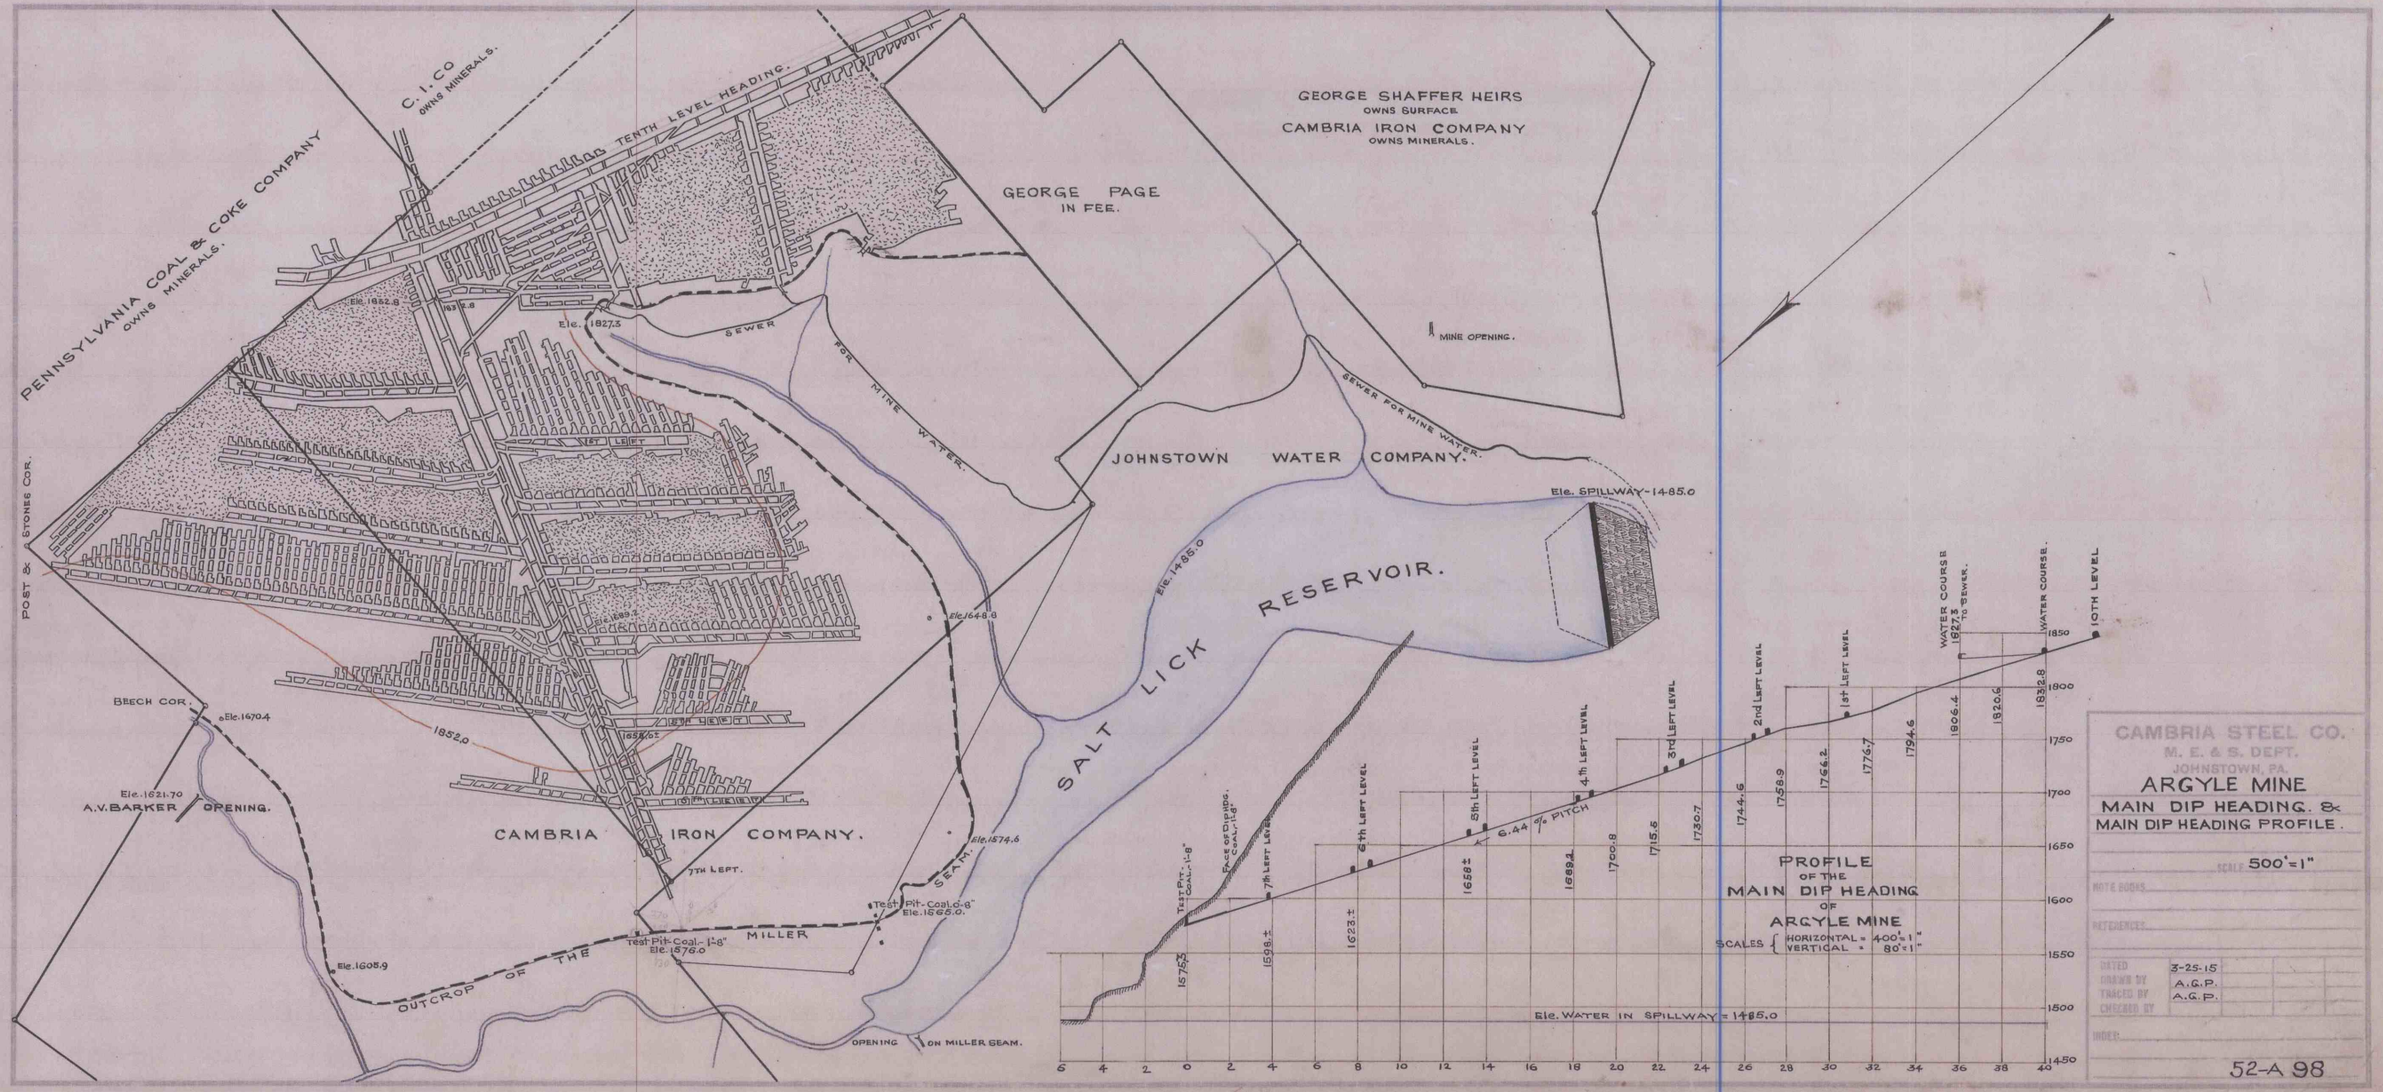
PENNSYLVANIA COAL & COKE COMPANY
OWNS MINERALS.
C. I. CO
OWNS MINERALS.
TENTH LEVEL HEADING.
GEORGE SHAFFER HEIRS
OWNS SURFACE
CAMBRIA IRON COMPANY
OWNS MINERALS.
GEORGE PAGE
IN FEE.
MINE OPENING.
SEWER FOR MINE WATER.
SEWER FOR MINE WATER.
JOHNSTOWN WATER COMPANY.
Ele. SPILLWAY-1485.0
SALT LICK RESERVOIR.
Ele. 1485.0
POST & STONES COR.
BEECH COR.
Ele. 1670.4
Ele. 1621.70
A.V. BARKER OPENING.
Ele. 1605.9
OUTCROP OF THE MILLER SEAM.
CAMBRIA IRON COMPANY.
7TH LEFT.
Test Pit-Coal-1'-8"
Ele. 1576.0
Test Pit-Coal-0'-8"
Ele. 1565.0
Ele. 1574.6
Ele. 1648.8
Ele. 1827.3
Ele. 1852.8
1852.0
OPENING ON MILLER SEAM.
PROFILE
OF THE
MAIN DIP HEADING
OF
ARGYLE MINE
SCALES { HORIZONTAL = 400'=1"
VERTICAL = 80'=1"
6.44 % PITCH
Ele. WATER IN SPILLWAY = 1485.0
10TH LEVEL
WATER COURSE.
WATER COURSE TO SEWER.
1st LEFT LEVEL.
2nd LEFT LEVEL
3rd LEFT LEVEL
4th LEFT LEVEL
5th LEFT LEVEL
6th LEFT LEVEL
7th LEFT LEVEL
Face of Dip Hdg. Coal-1'-8"
Test Pit-Coal-1'-8"
1575.3
1598.±
1623.±
1658.±
1689.2
1700.8
1715.5
1730.7
1744.6
1758.9
1766.2
1776.7
1794.6
1806.4
1826.6
1832.8
1850
1800
1750
1700
1650
1600
1550
1500
1450
6 4 2 0 2 4 6 8 10 12 14 16 18 20 22 24 26 28 30 32 34 36 38 40
CAMBRIA STEEL CO.
M. E. & S. DEPT.
JOHNSTOWN, PA.
ARGYLE MINE
MAIN DIP HEADING &
MAIN DIP HEADING PROFILE.
SCALE 500'=1"
NOTE BOOKS
REFERENCES
DATED 3-25-15
DRAWN BY A.G.P.
TRACED BY A.G.P.
CHECKED BY
INDEX
52-A 98
0-9