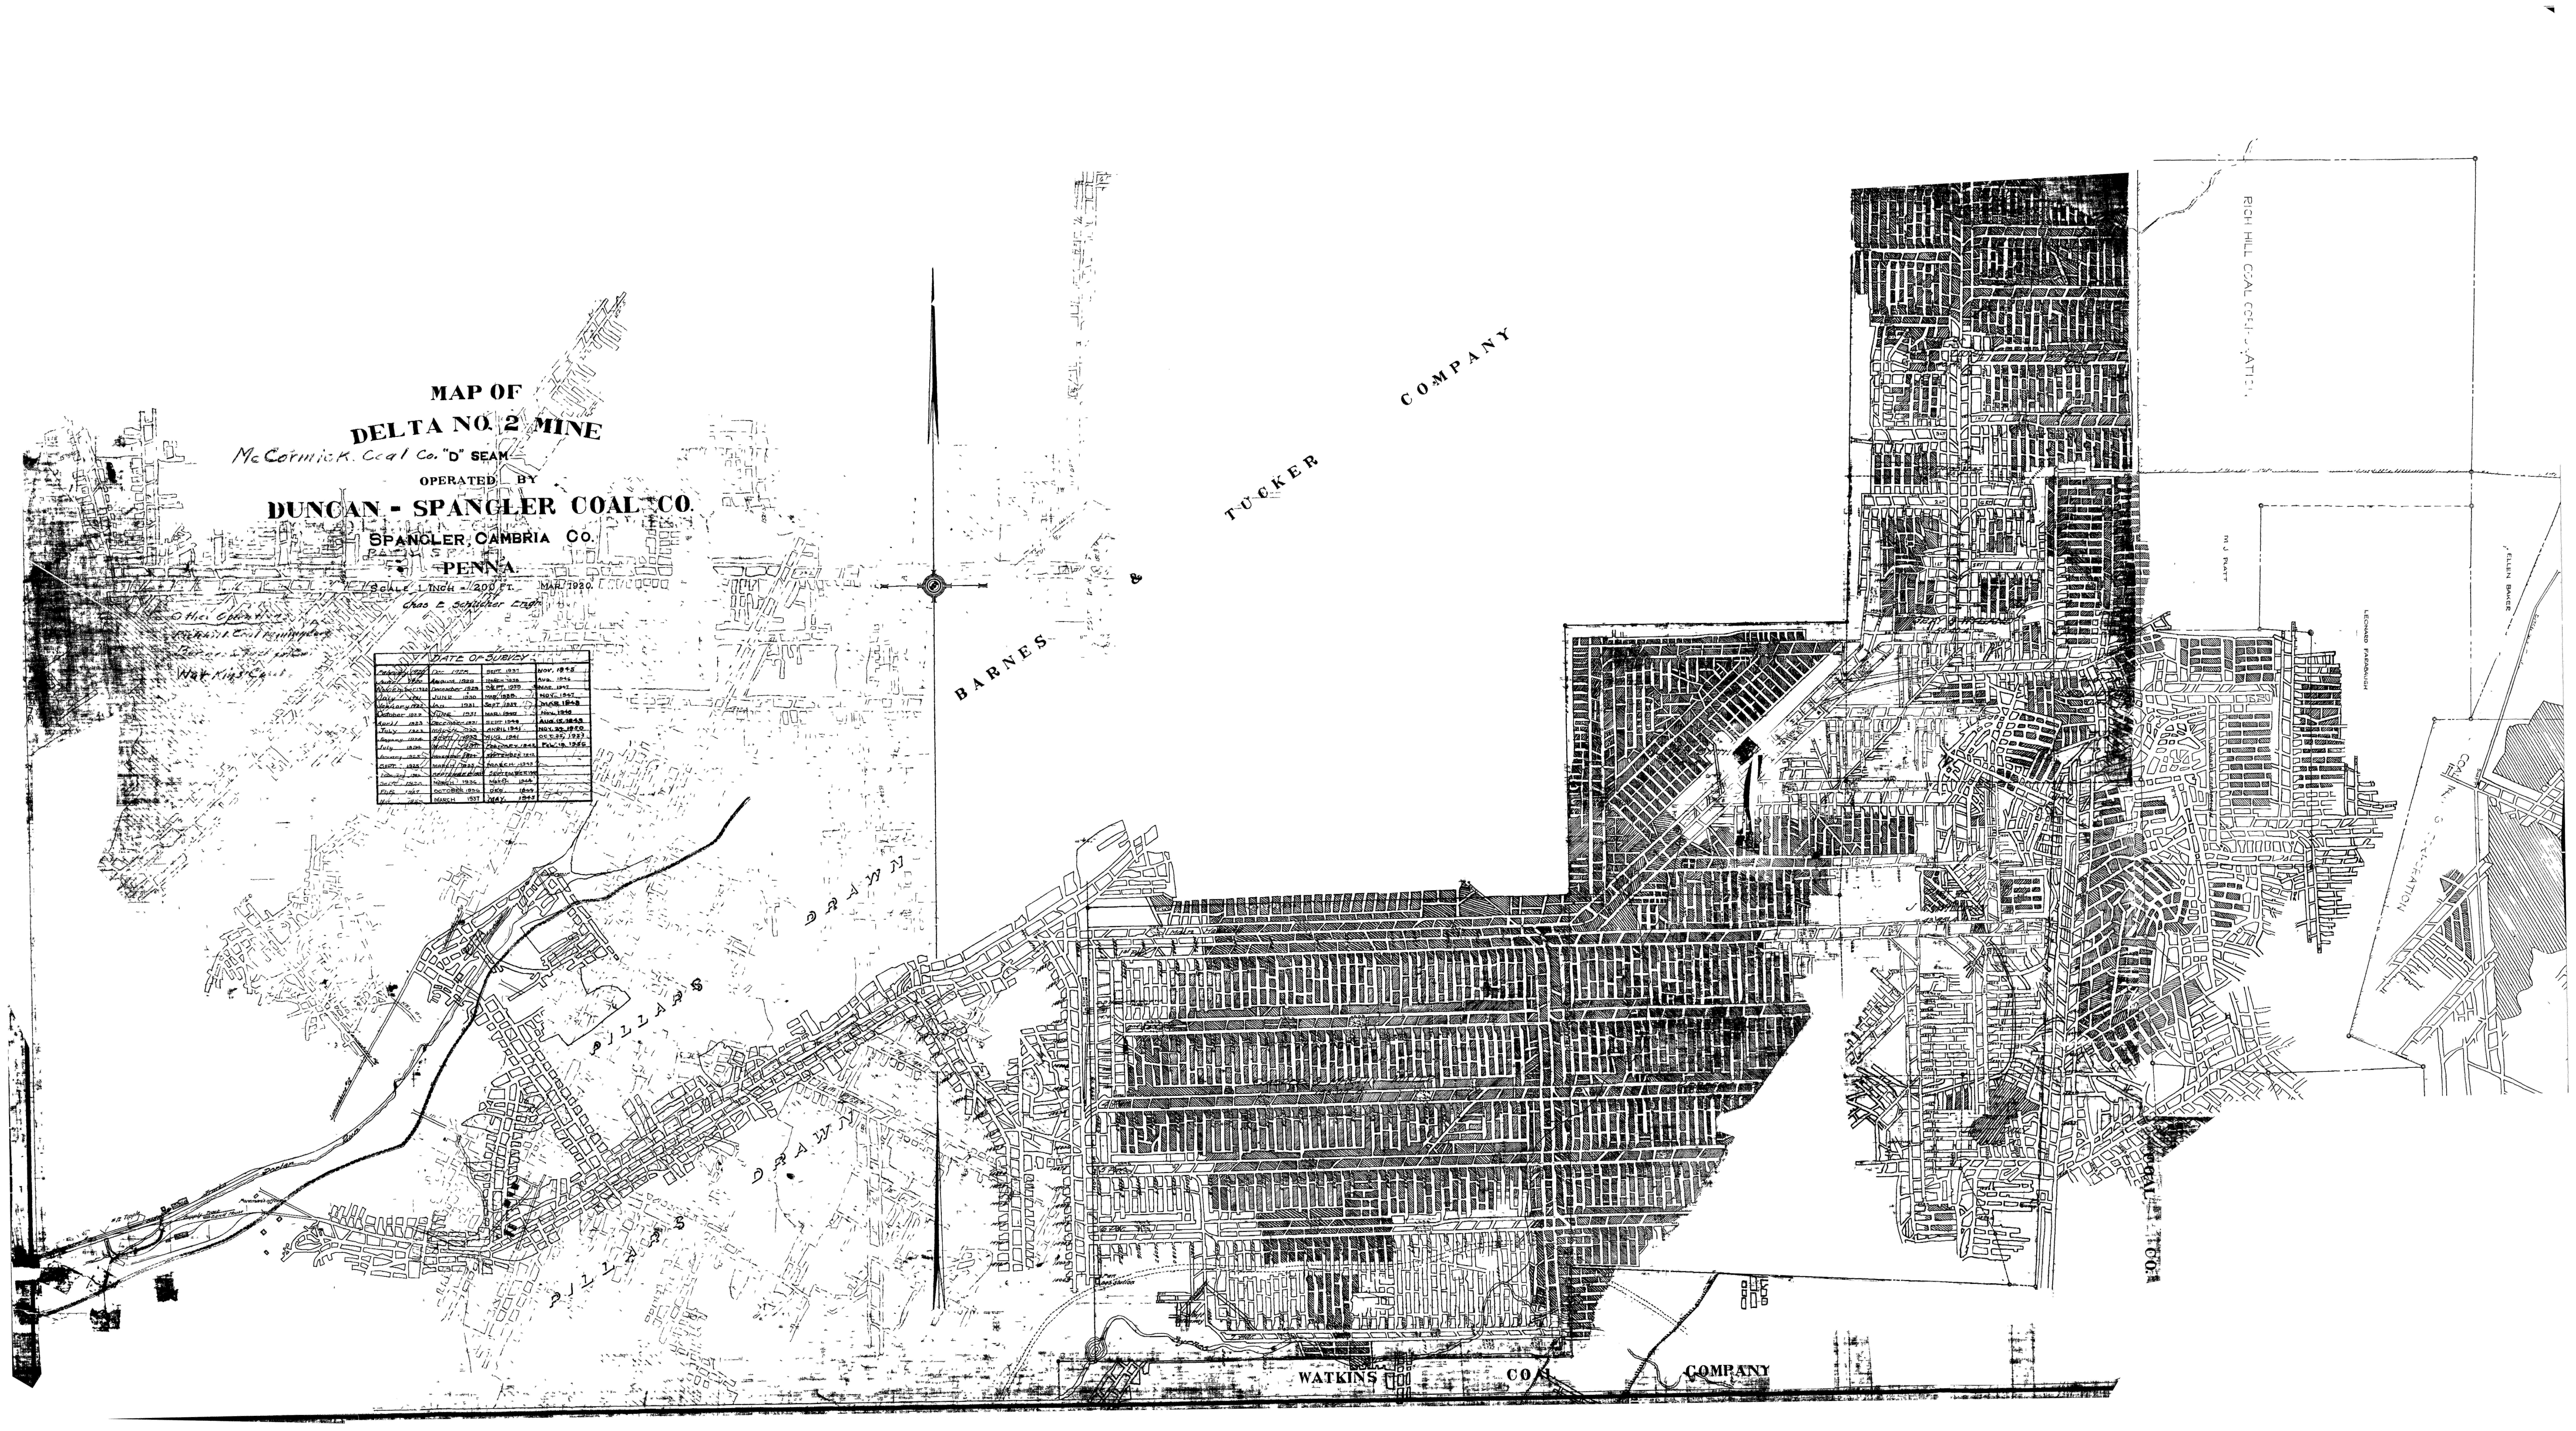

MAP OF

DELTA NO. 2 MINE

McCormick Coal Co. "D" SEAM

OPERATED BY

DUNCAN - SPANGLER COAL CO.

SPANGLER, CAMBRIA CO.

PENNA.

SCALE 1 INCH = 200 FT. MAR. 1920.

Chas E Schlicher Engr.

Other Operations
Rich Hill Coal Co.
Barnes & Tucker
Watkins Coal

DATE OF SURVEY			
February 1920	Dec 1928	SEPT. 1937	NOV. 1945
June 1920	August 1929	MARCH 1938	AUG. 1946
November 1920	December 1929	SEPT. 1938	MAR. 1947
July 1921	JUNE 1930	MAR. 1939	NOV. 1947
January 1922	JAN. 1931	SEPT 1939	MAR. 1948
October 1922	JUNE 1931	MAR. 1940	NOV. 1948
April 1923	December 1931	SEPT 1940	AUG. 15, 1949
July 1923	MARCH 1932	APRIL 1941	NOV. 29, 1950
February 1924	SEPT. 1933	AUG. 1941	OCT. 25, 1951
July 1924	MAY 1934	FEBRUARY 1942	FEB. 15, 1956
January 1925	November 1934	SEPTEMBER 1942	
SEPT. 1925	MARCH 1935	MARCH 1943	
February 1926	SEPTEMBER 1935	SEPTEMBER 1943	
Sept. 1926	MARCH 1936	MARCH 1944	
Feb. 1927	OCTOBER 1936	DEC. 1944	
May [illegible]	MARCH 1937	MAY 1945	

BARNES & TUCKER COMPANY
PILLARS DRAWN
PILLARS DRAWN
WATKINS COAL COMPANY
RICH HILL COAL CORPORATION
M J PLATT
LEONARD FARABAUGH
ELLEN BAKER
COAL CORPORATION
COAL CO.