DEC 1 1982

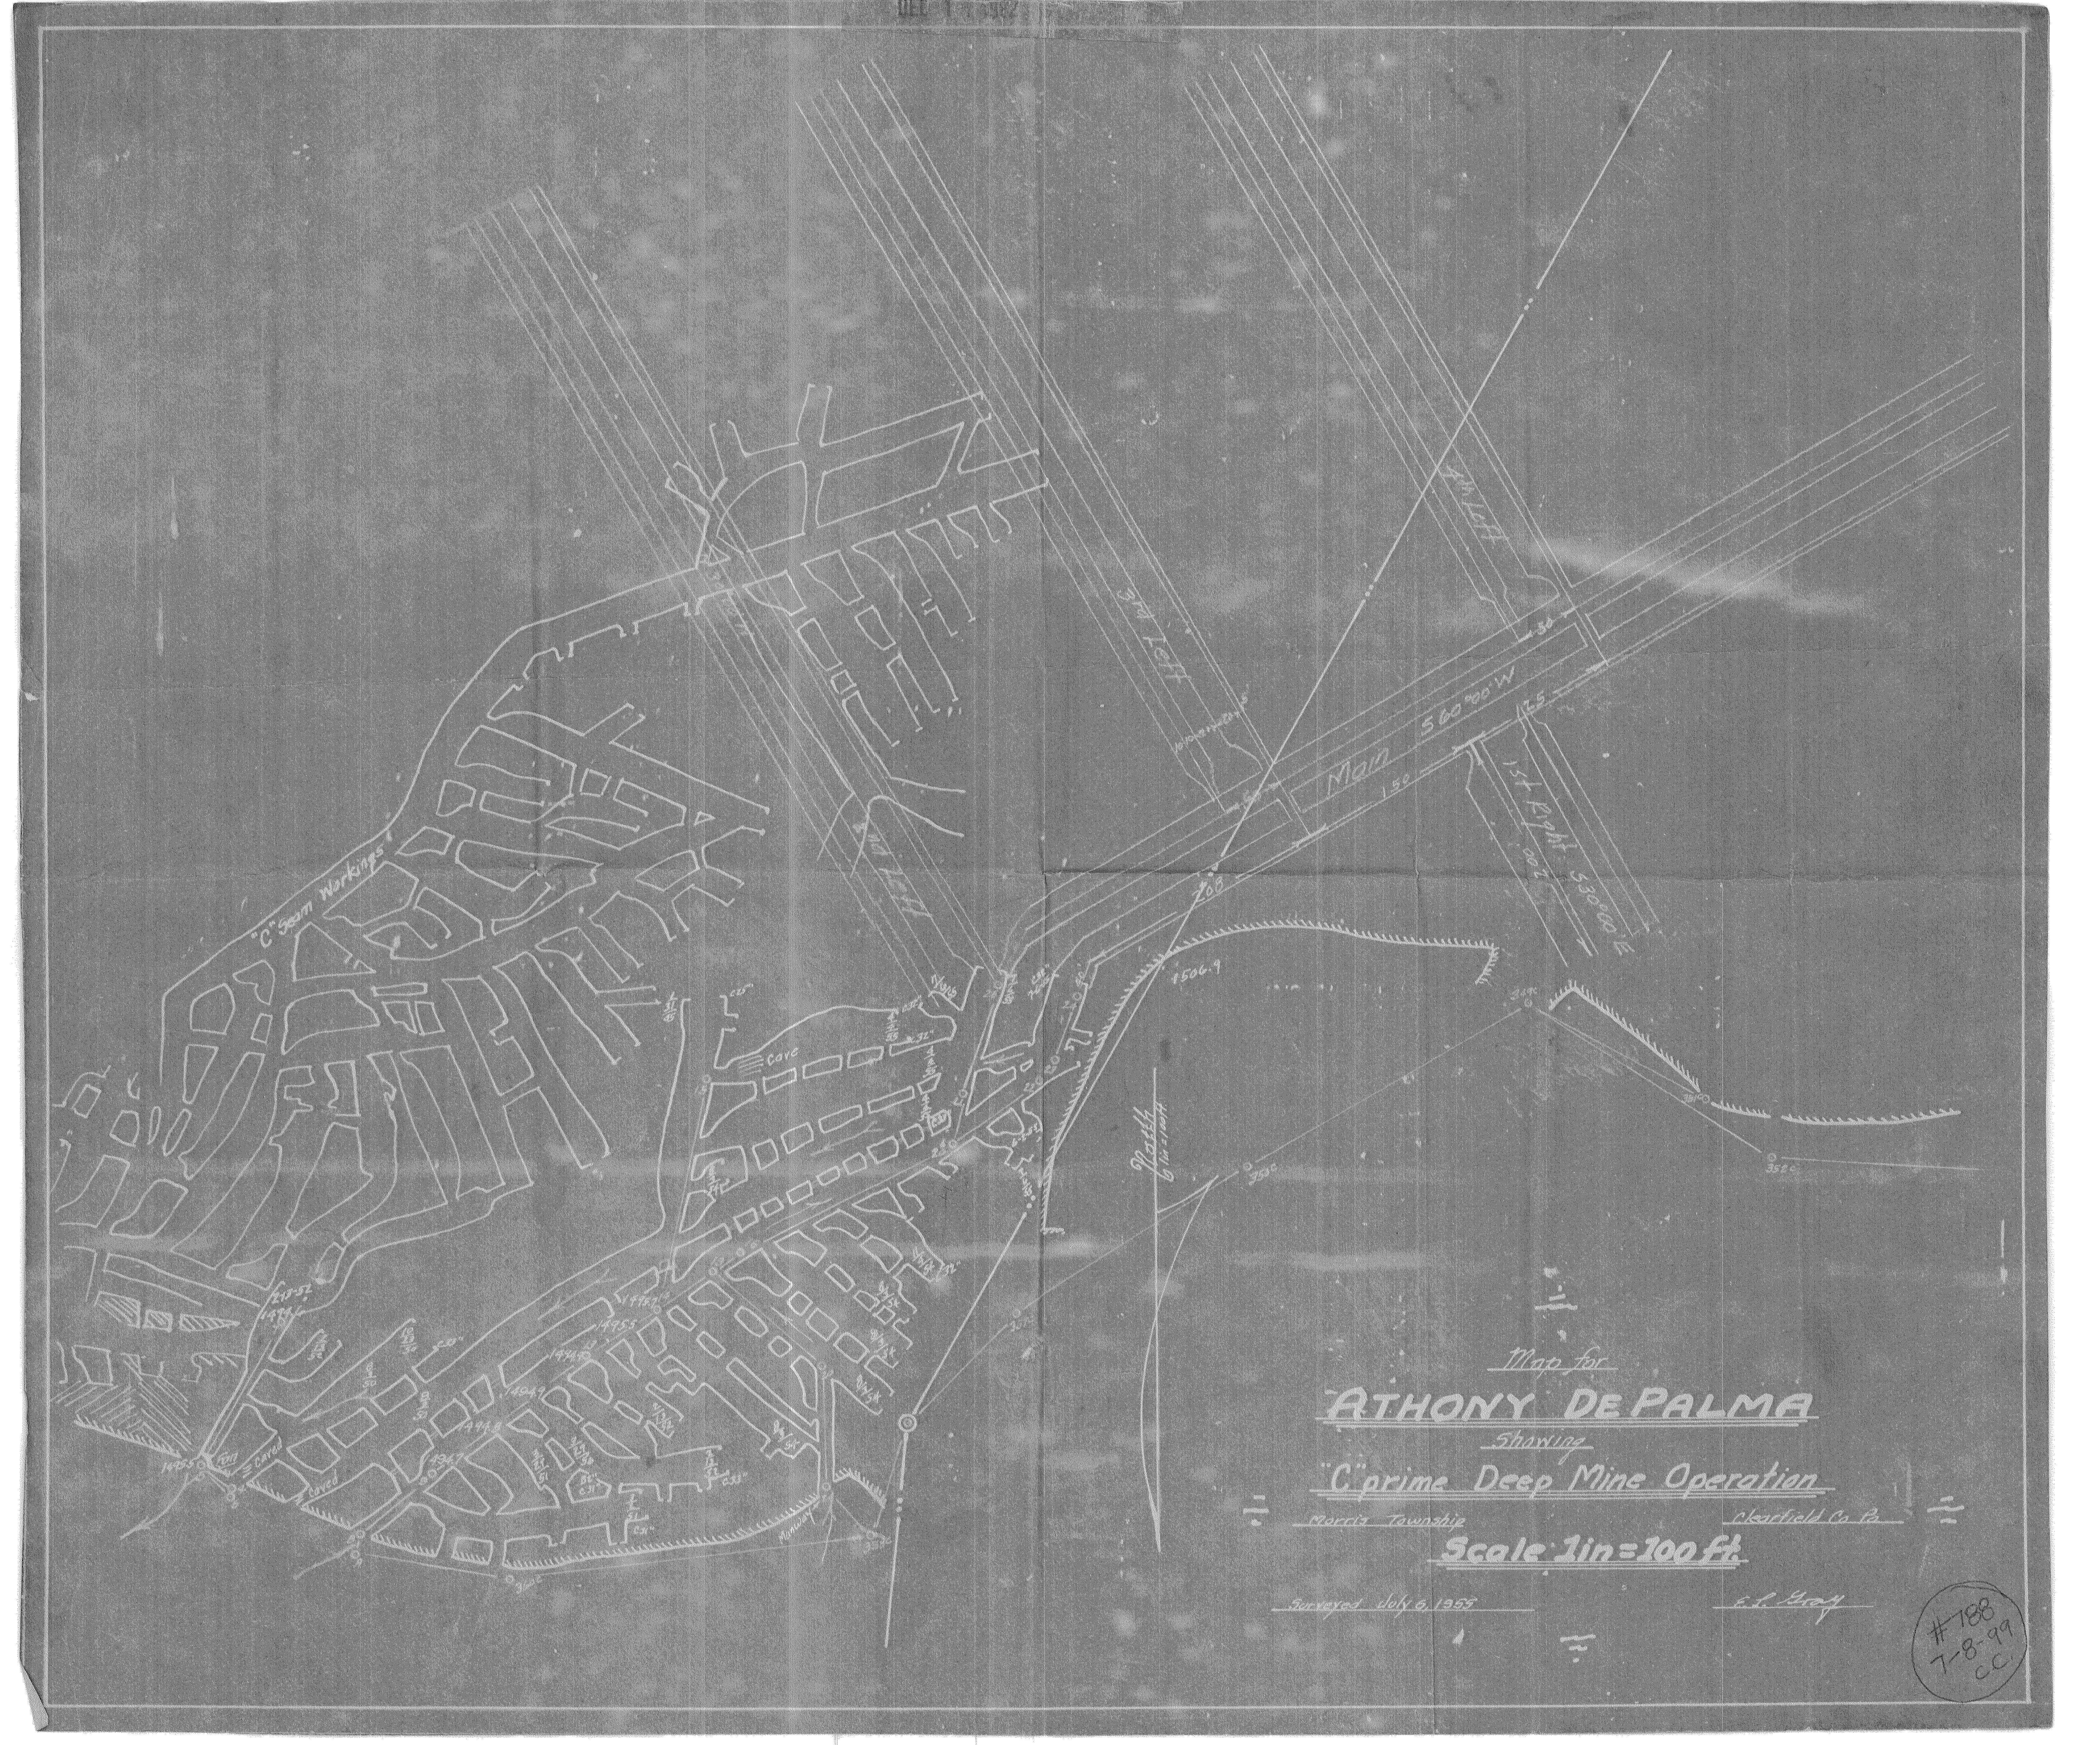
"C" Seam Workings
3rd Left
4th Left
2nd Left
Main S60°00'W
1st Right S30°00'E
150
200
Cave
Caved
1506.9
North
352C
351C
Manway

Map for

# ATHONY DE PALMA

Showing

## "C" prime Deep Mine Operation

Morris Township
Clearfield Co. Pa

**Scale 1in=100 ft.**

Surveyed July 6, 1955
E. L. Gray

#788
7-8-99
C.C.