


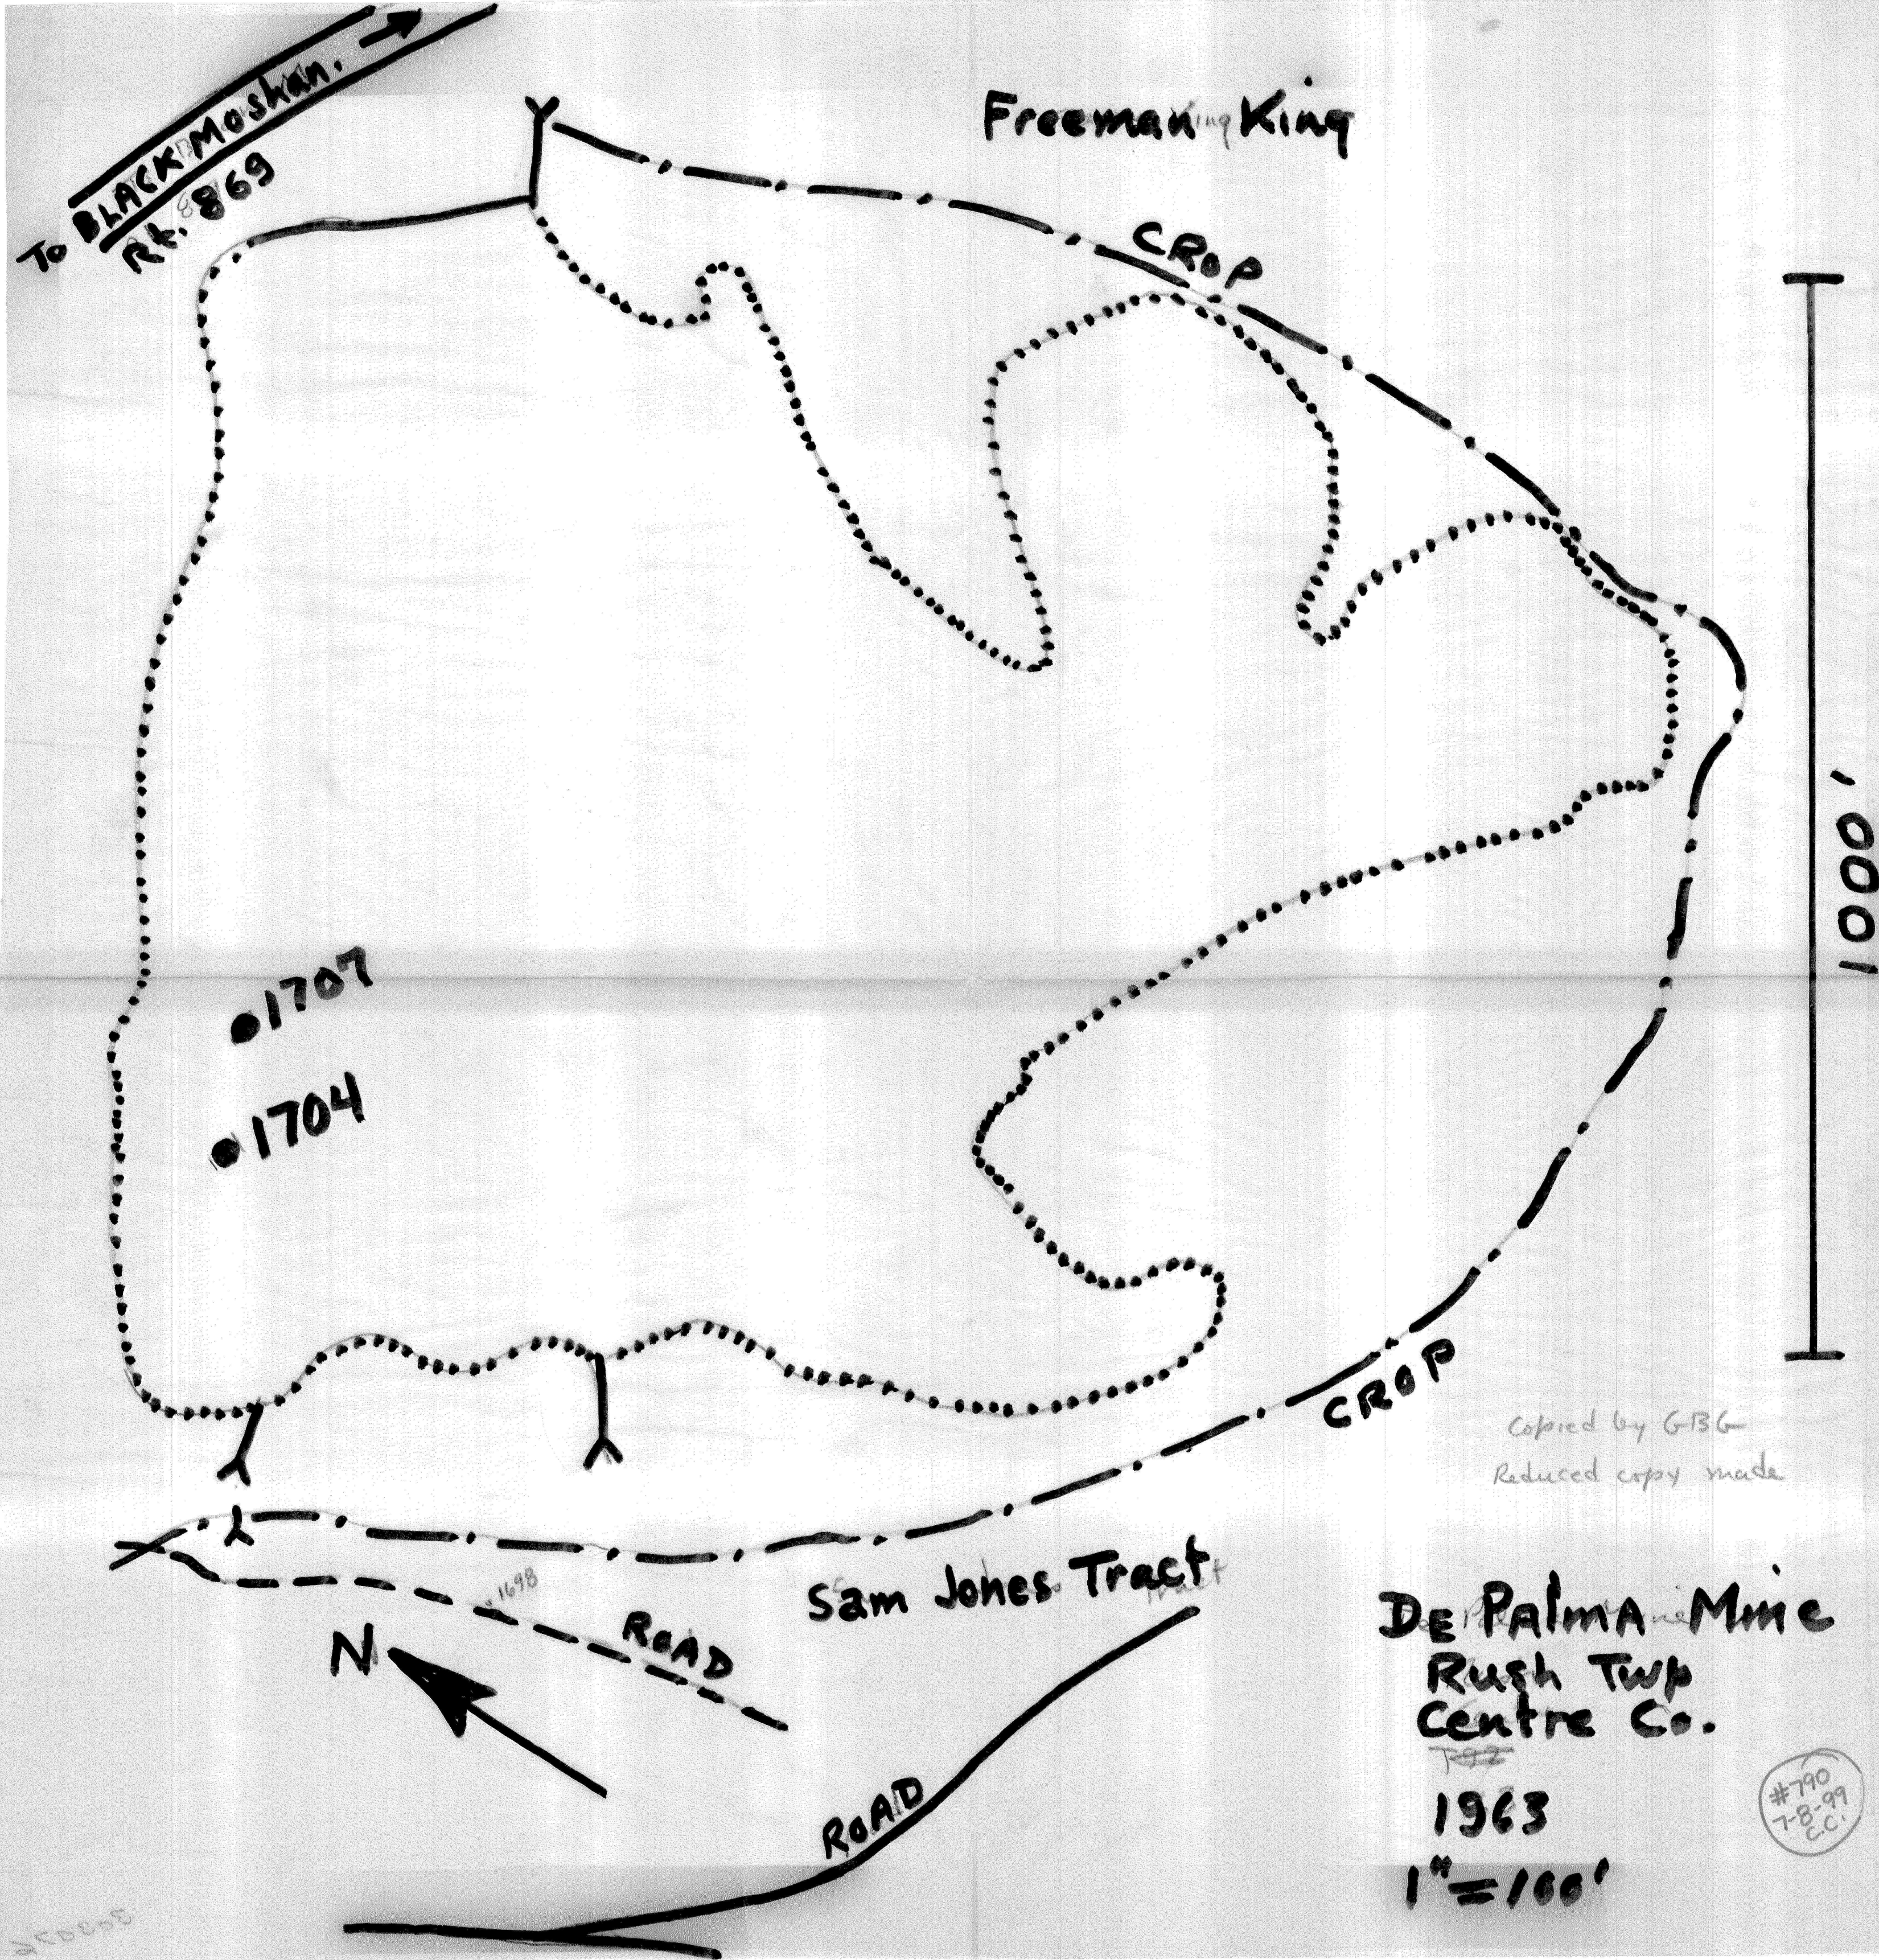

Copied by G-B-G
Reduced copy made

De Palma Mine
Rush Twp
Centre Co.

1963
1" = 100'

#790
7-8-99
C.C.