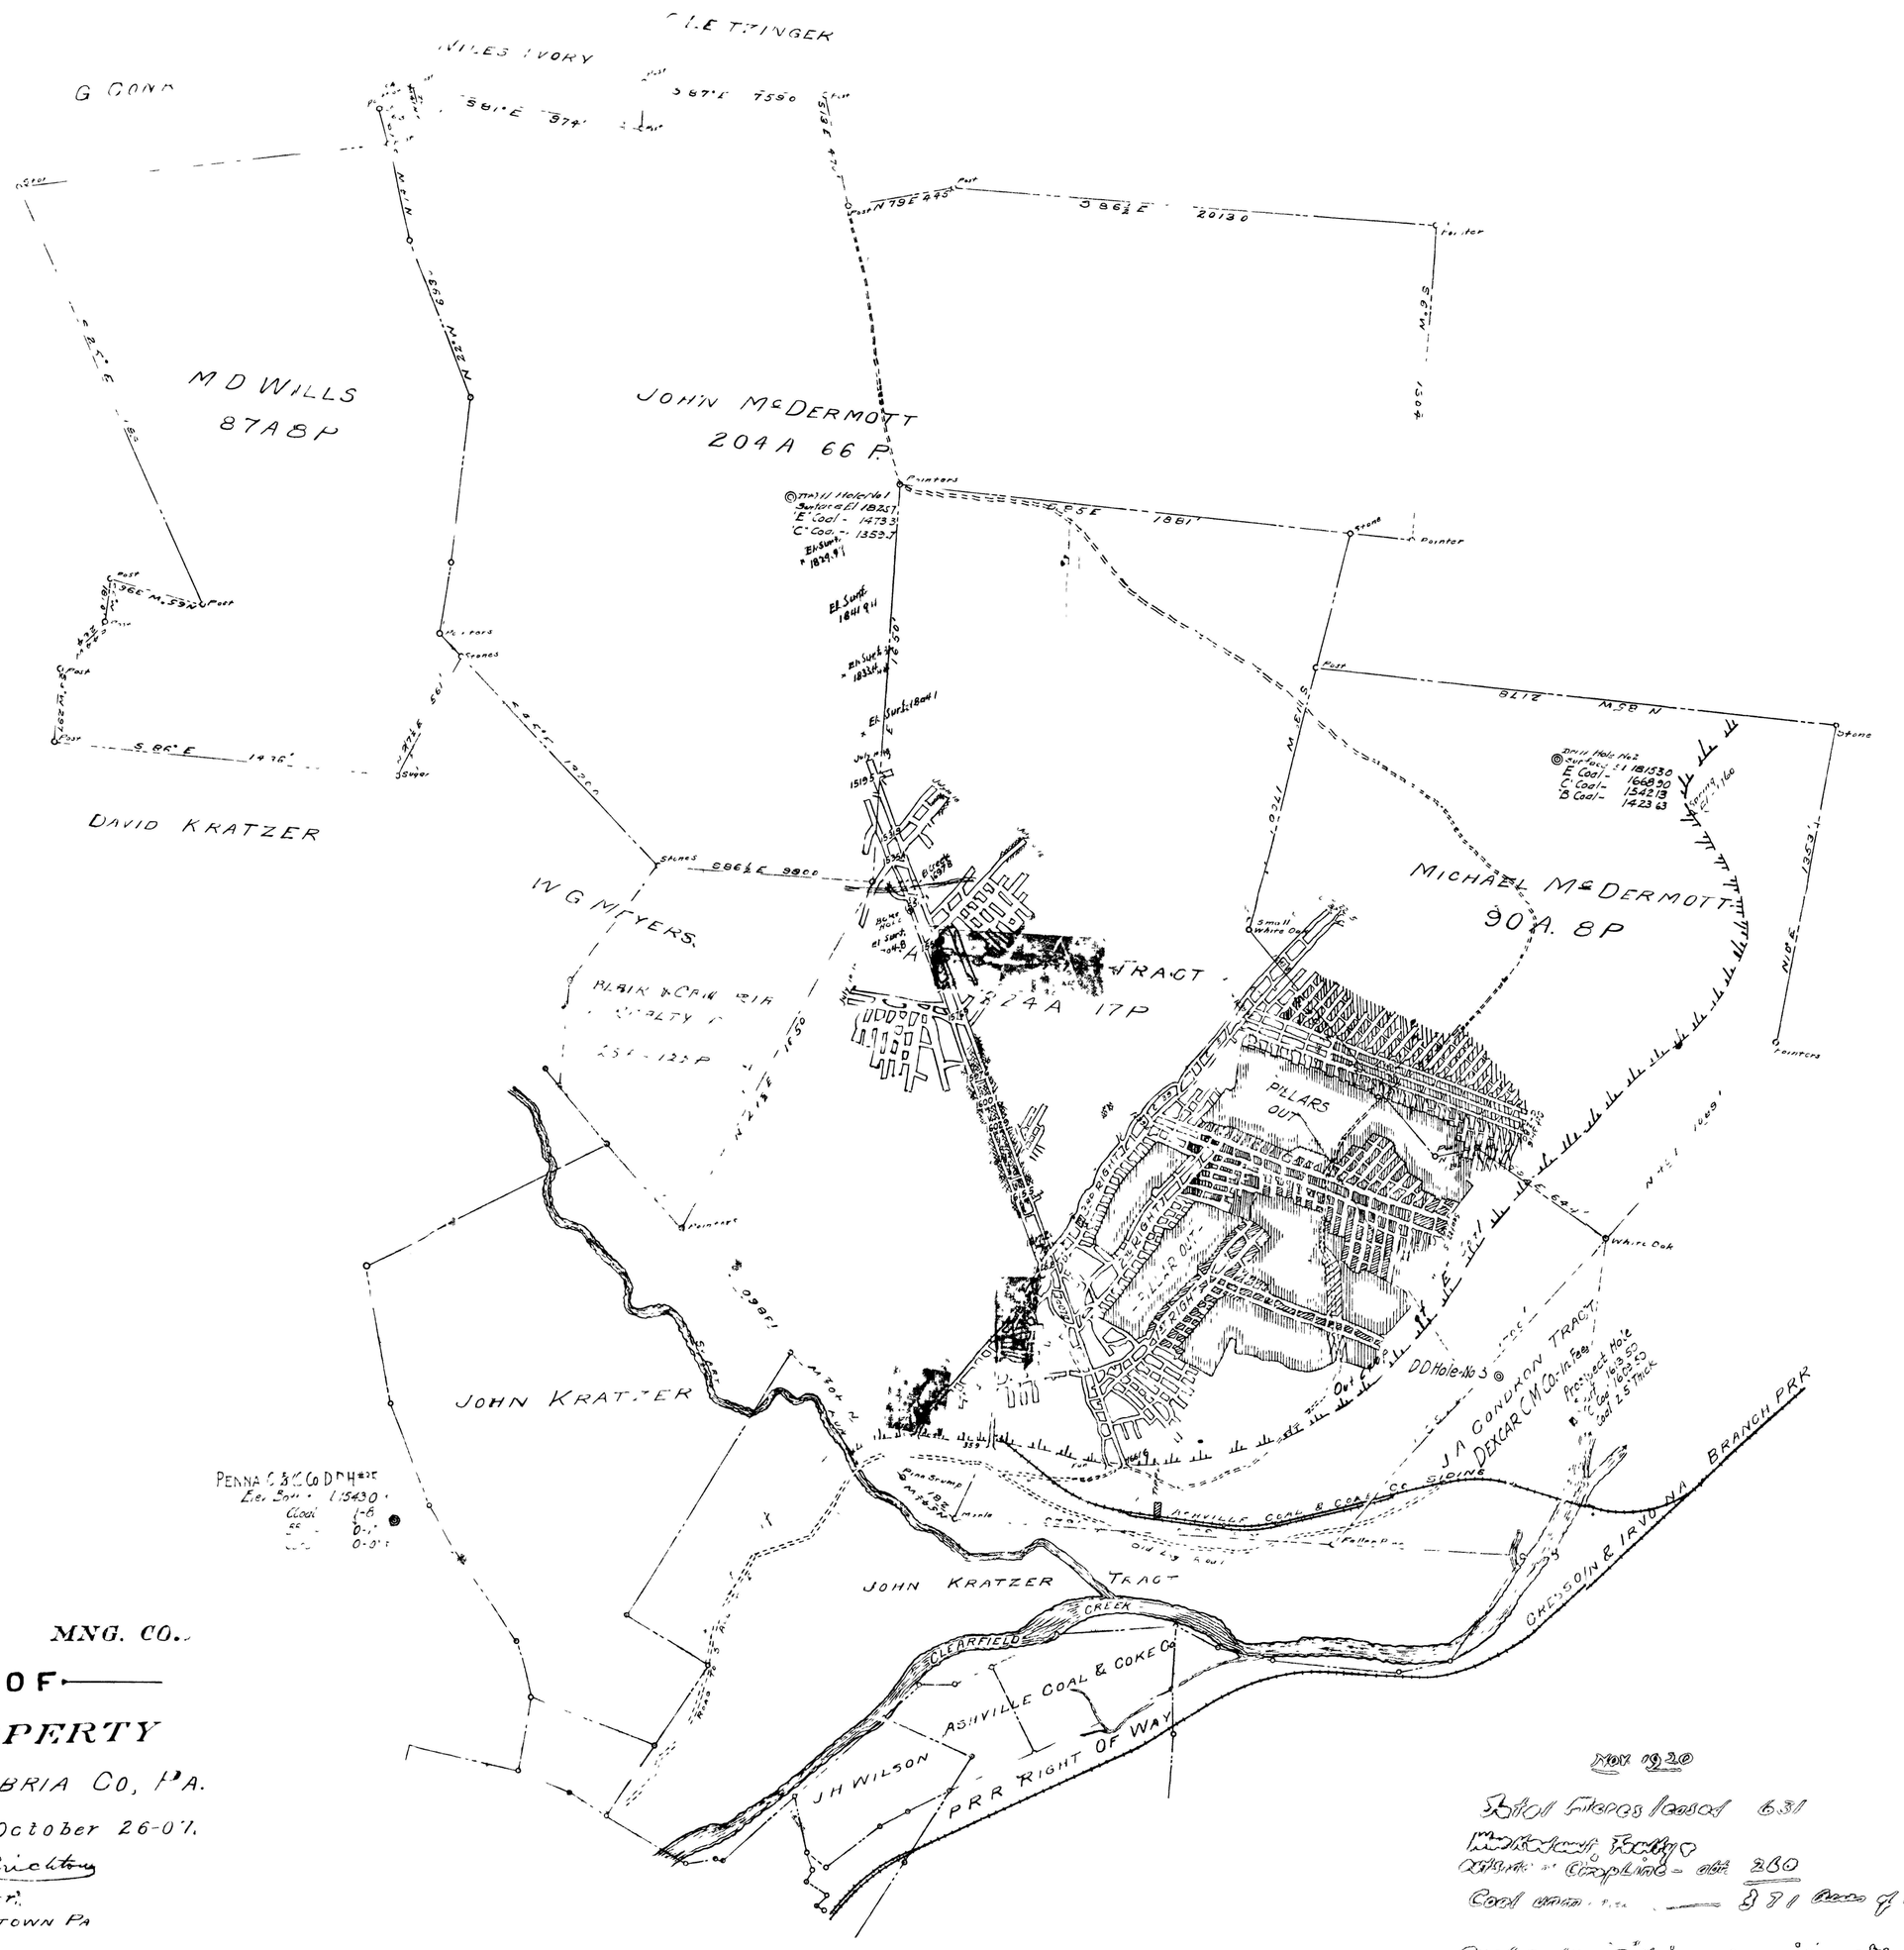

DEXCAR COAL MNG. CO.

MAP OF

Nº 1 PROPERTY

ASHVILLE, CAMBRIA Co, PA.

Scale 400'=1" October 26-07.

Andrew J. Crichton
Engineer,
JOHNSTOWN PA

Nov 1920

Total Acreage leased 631

Mining Facility

Estimate of Coal Line - abt 280

Coal area - 371 Acres of "E" Coal.

Coal under "E" Vein not considered workable

See 100' map for Development to date.