


COUNTY OF WESTMORELAND)
STATE OF PENNSYLVANIA.) S.S.

On this day of *October 6th* A. D. 1925 personally
appeared before me *Robert McInnes*, who being duly sworn according
to law, says that he is the Engineer for the Ligonier Diamond Coal
and Coke Company. He further says that this map is a true and correct
survey of the workings of the abandoned Diamond No. 1 mine of said
Company to the best of his knowledge and belief.

Sworn to and subscribed before me.

Robert McInnes Engineer.

W. S. Schuchert
Notary Public

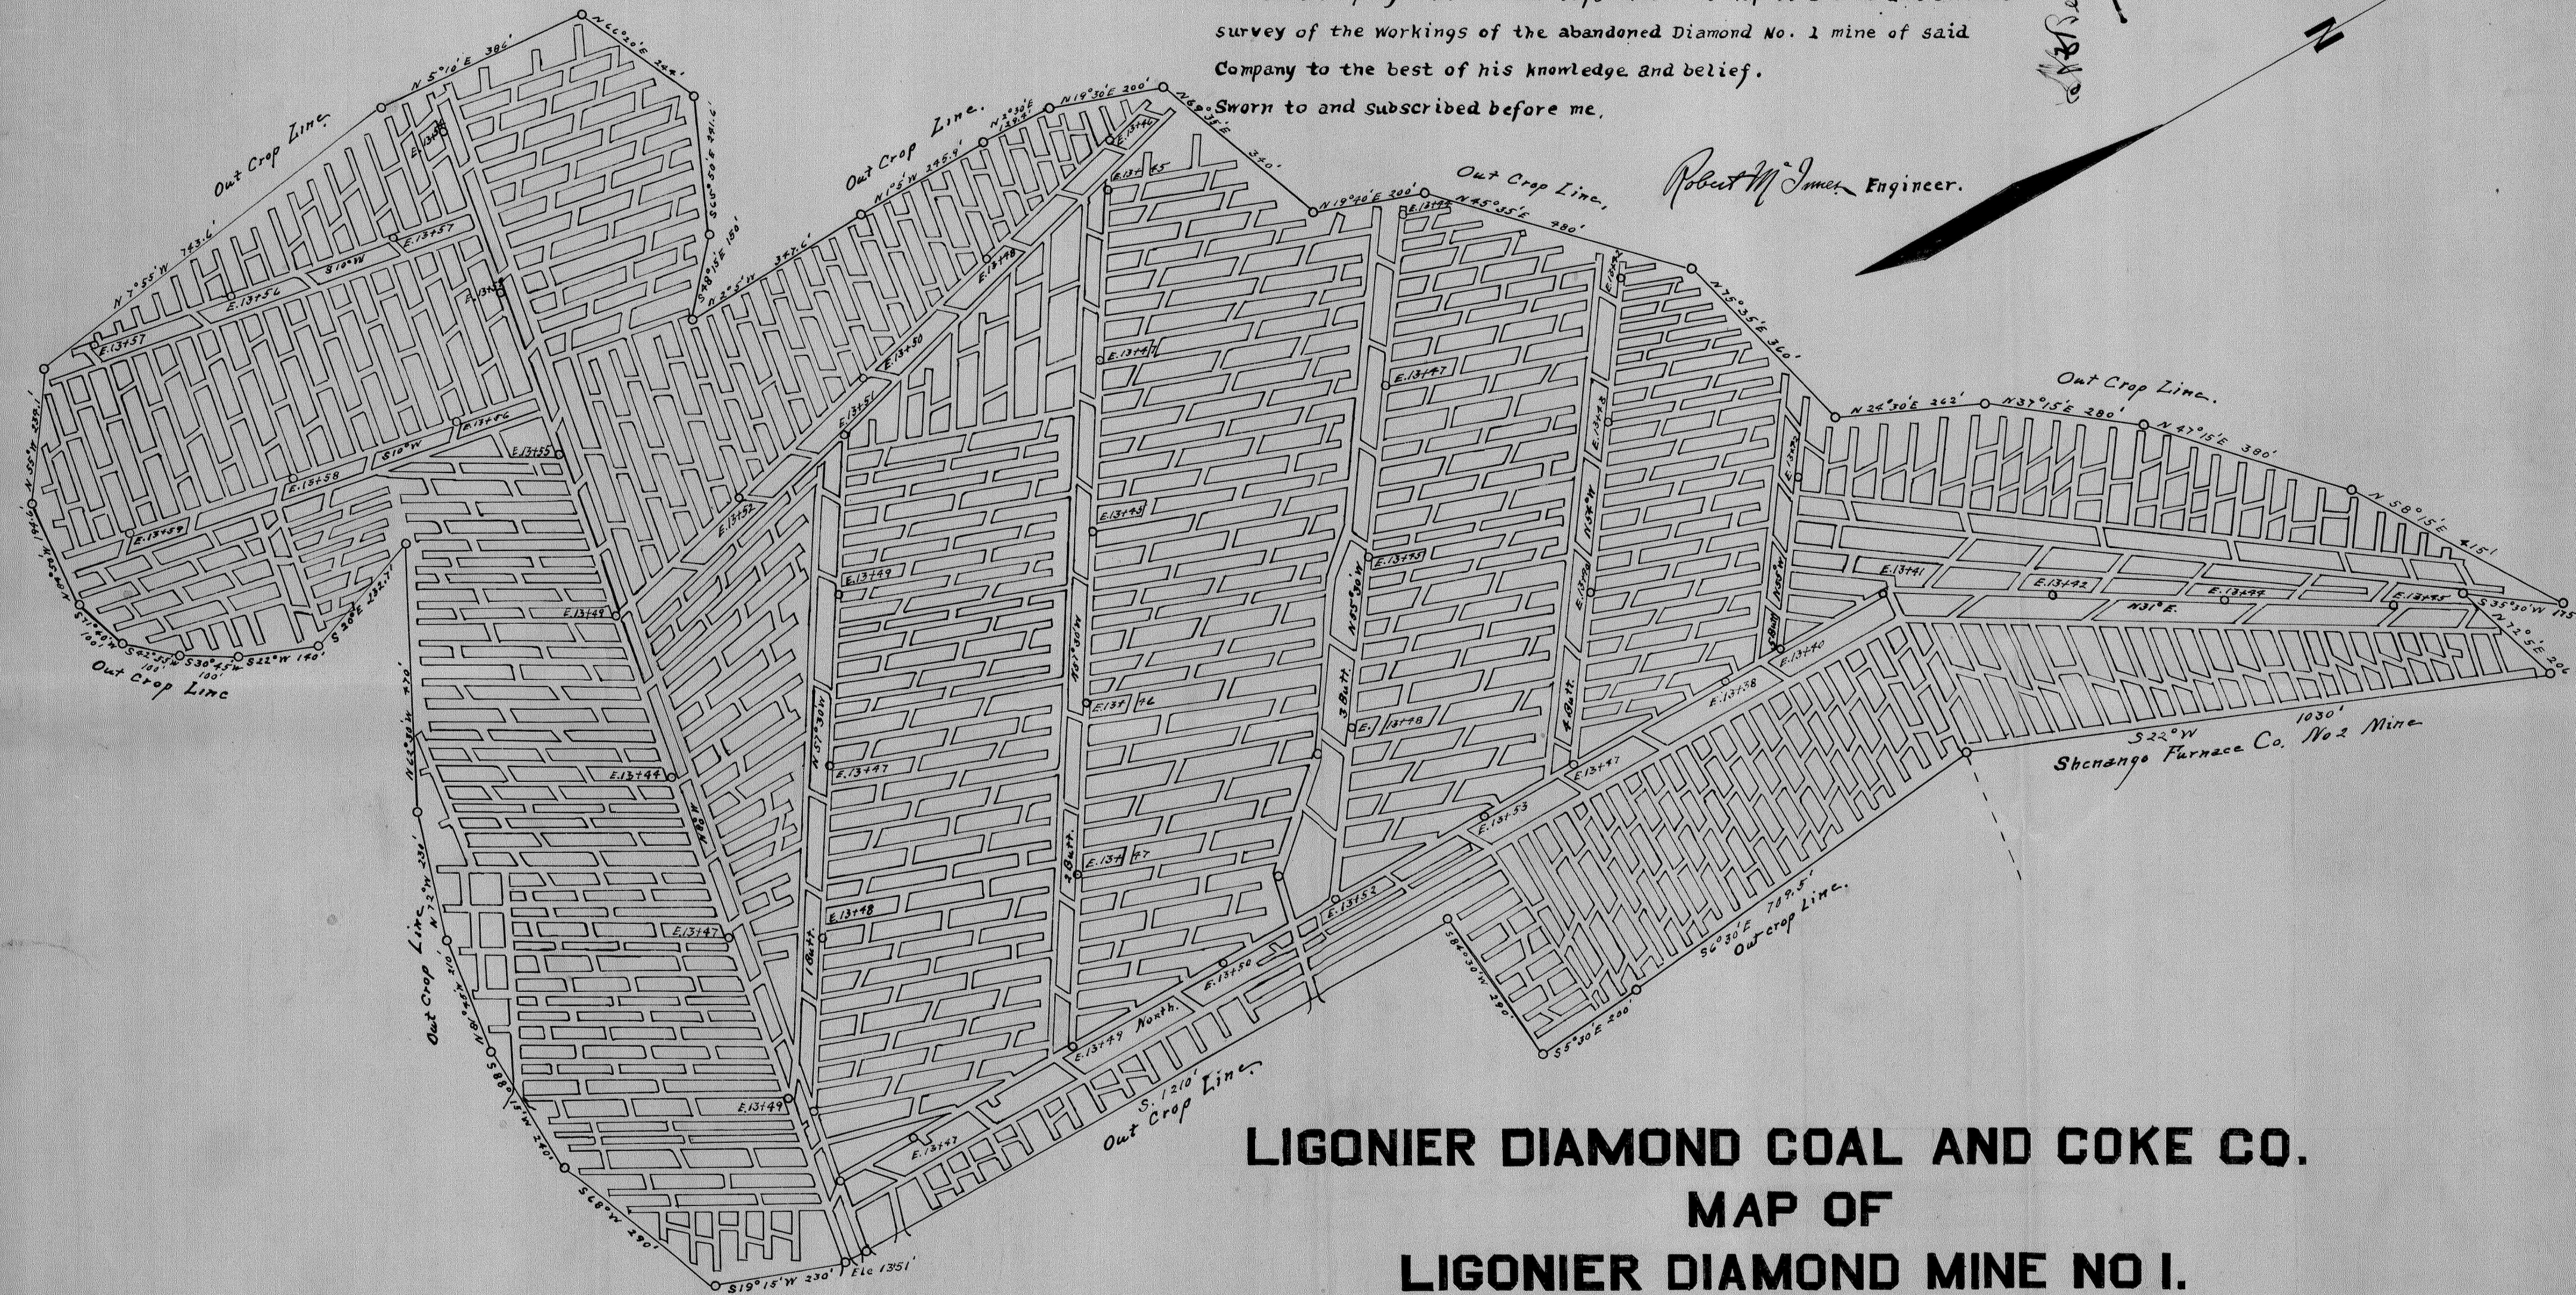

LIGONIER DIAMOND COAL AND COKE CO.
MAP OF
LIGONIER DIAMOND MINE NO. 1.
SHOWING WORKED OUT AND ABANDONED WORKINGS.

Began Operating July 9th 1907. Abandoned March 6th, 1925.

Located in North Ligonier Township, Westmoreland Co. Pa.

Owned by Seeger Bros. Ligonier, Pa.

Scale 1"=200'

March 25th 1925. R. McInnes.