


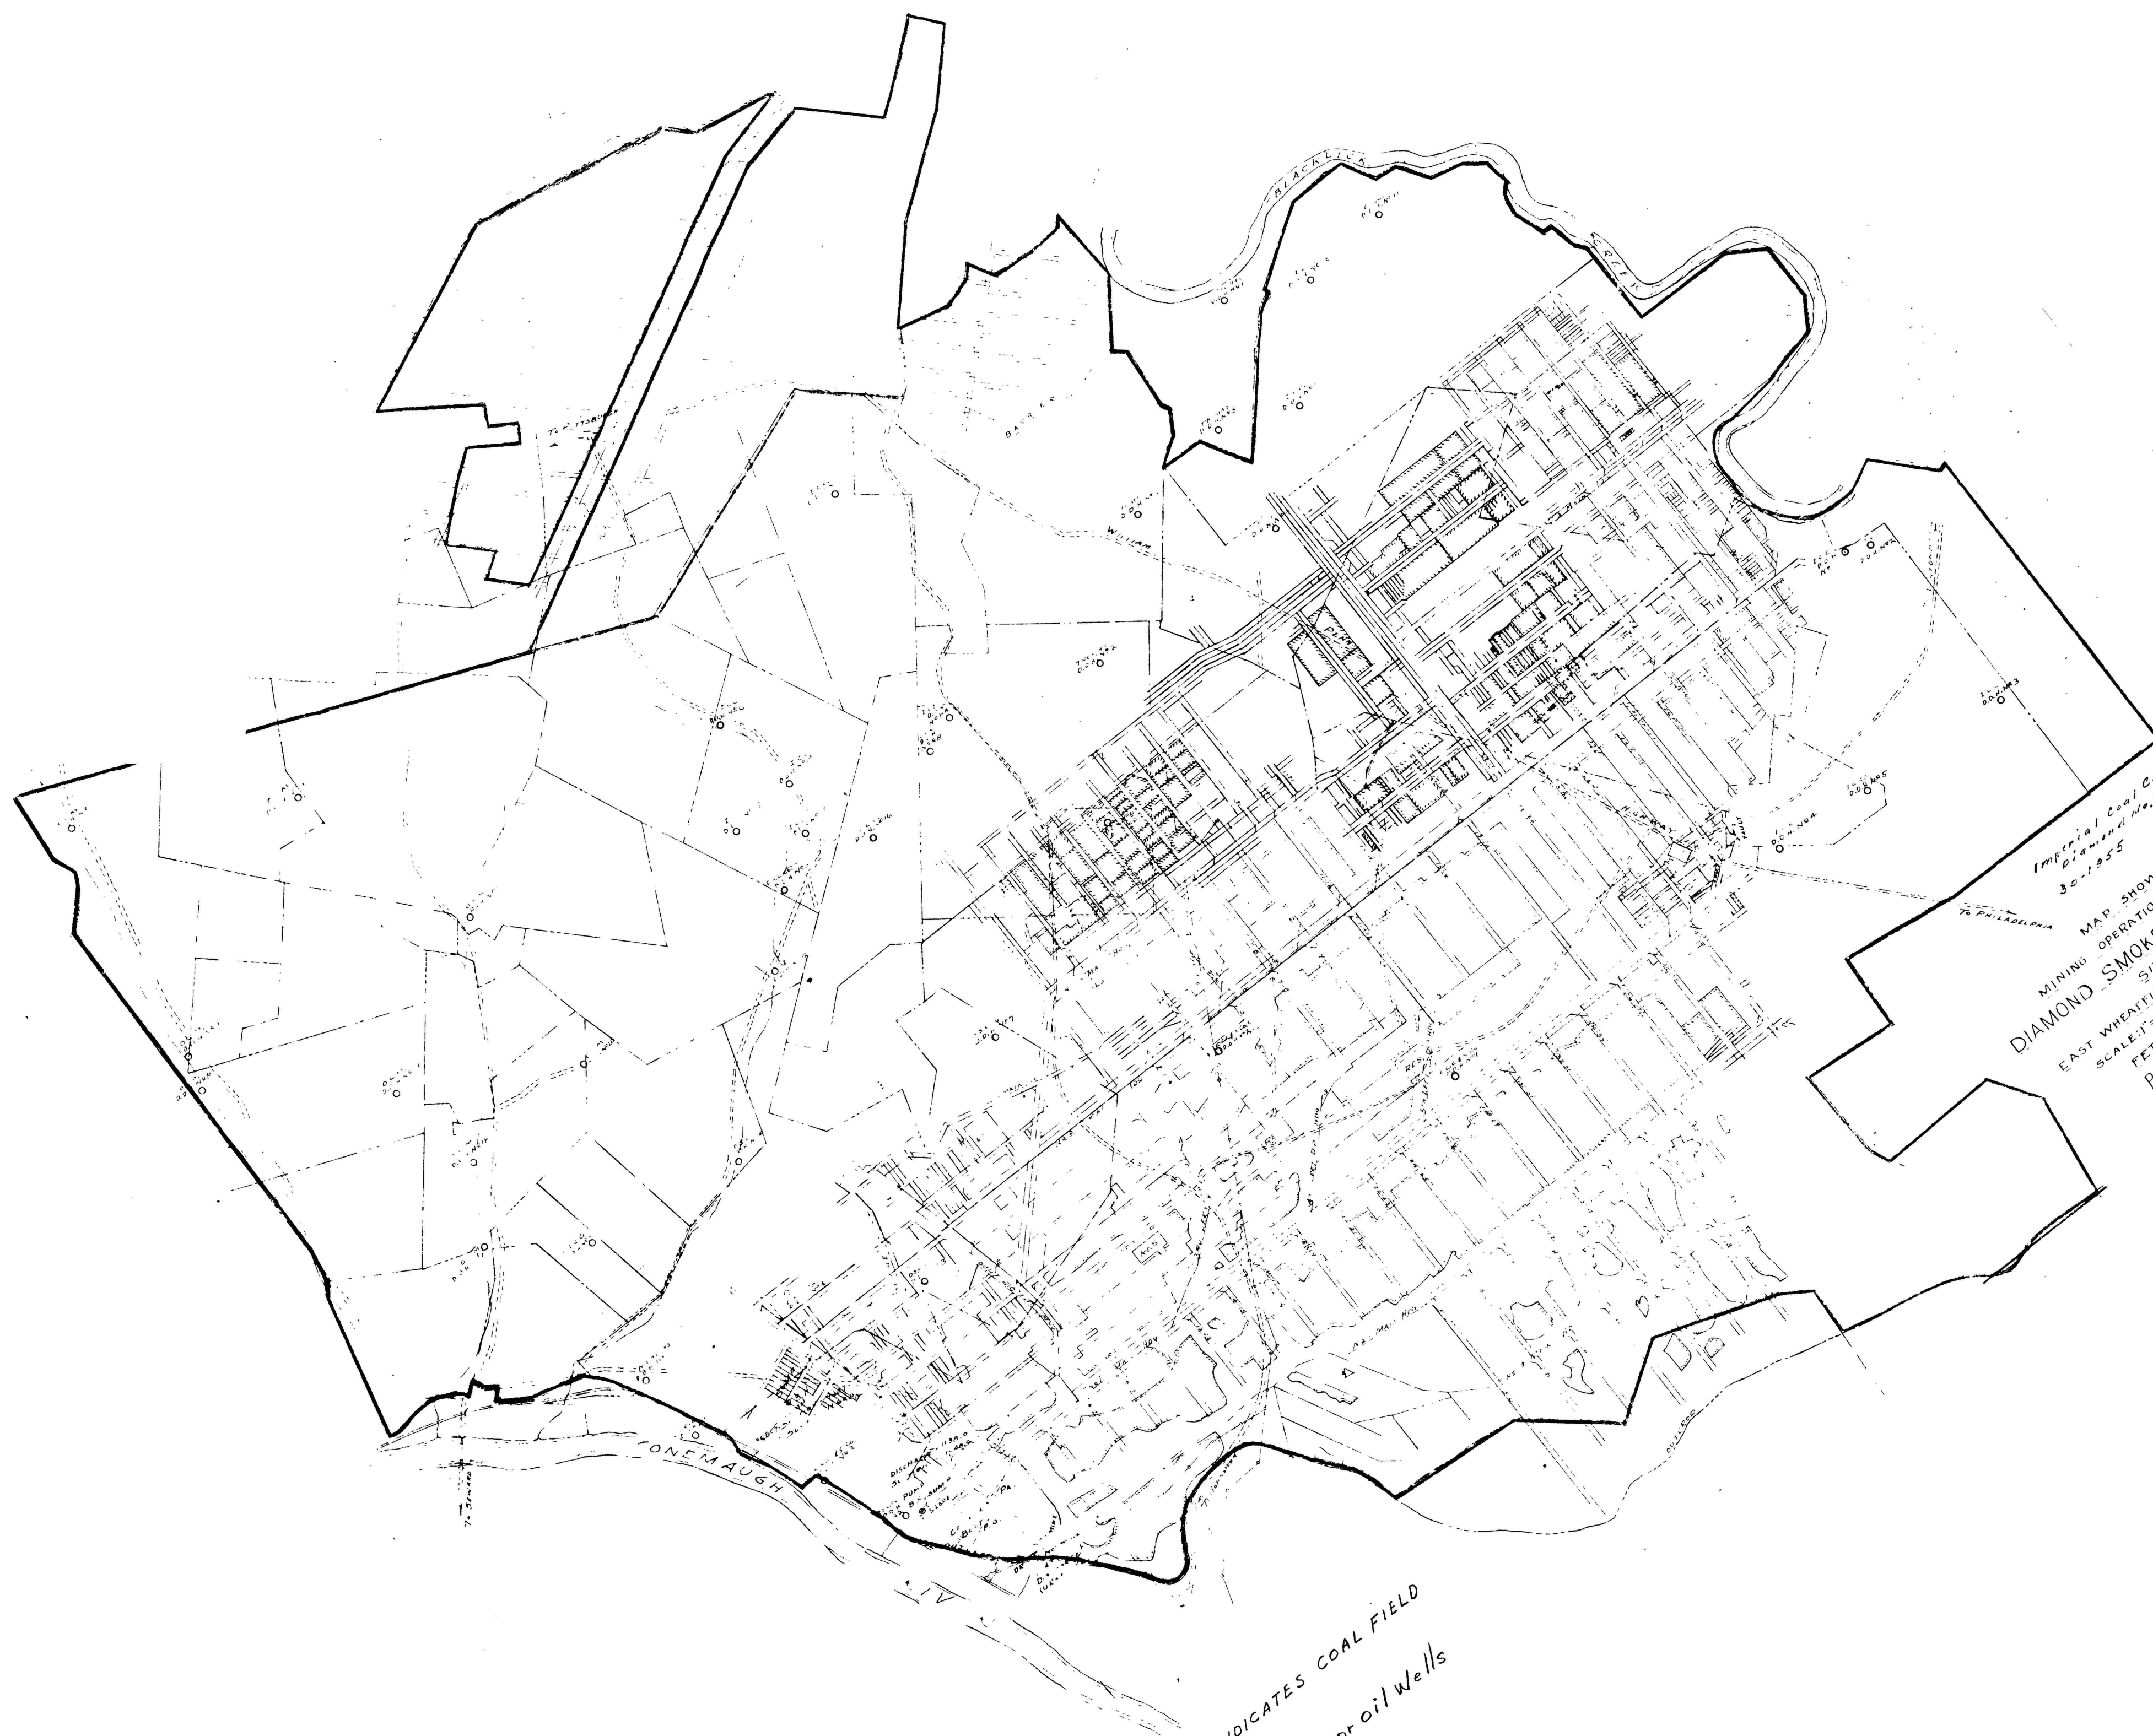

INDICATES COAL FIELD
NOTE: No gas or oil wells

Imperial Coal Corp.
Diamond No. 1
MAP SHOWING OF THE
MINING OPERATIONS OF THE
DIAMOND SMOKELESS COAL CO.
SITUATE IN
EAST WHEATFIELD TWP., INDIANA CO., PA.
SCALE 1"=1000' SEPT. 24, 1948.
PETERMAN ENG. CO.
POSTED TO: 1/1/17

#777
78-99
C.C.