


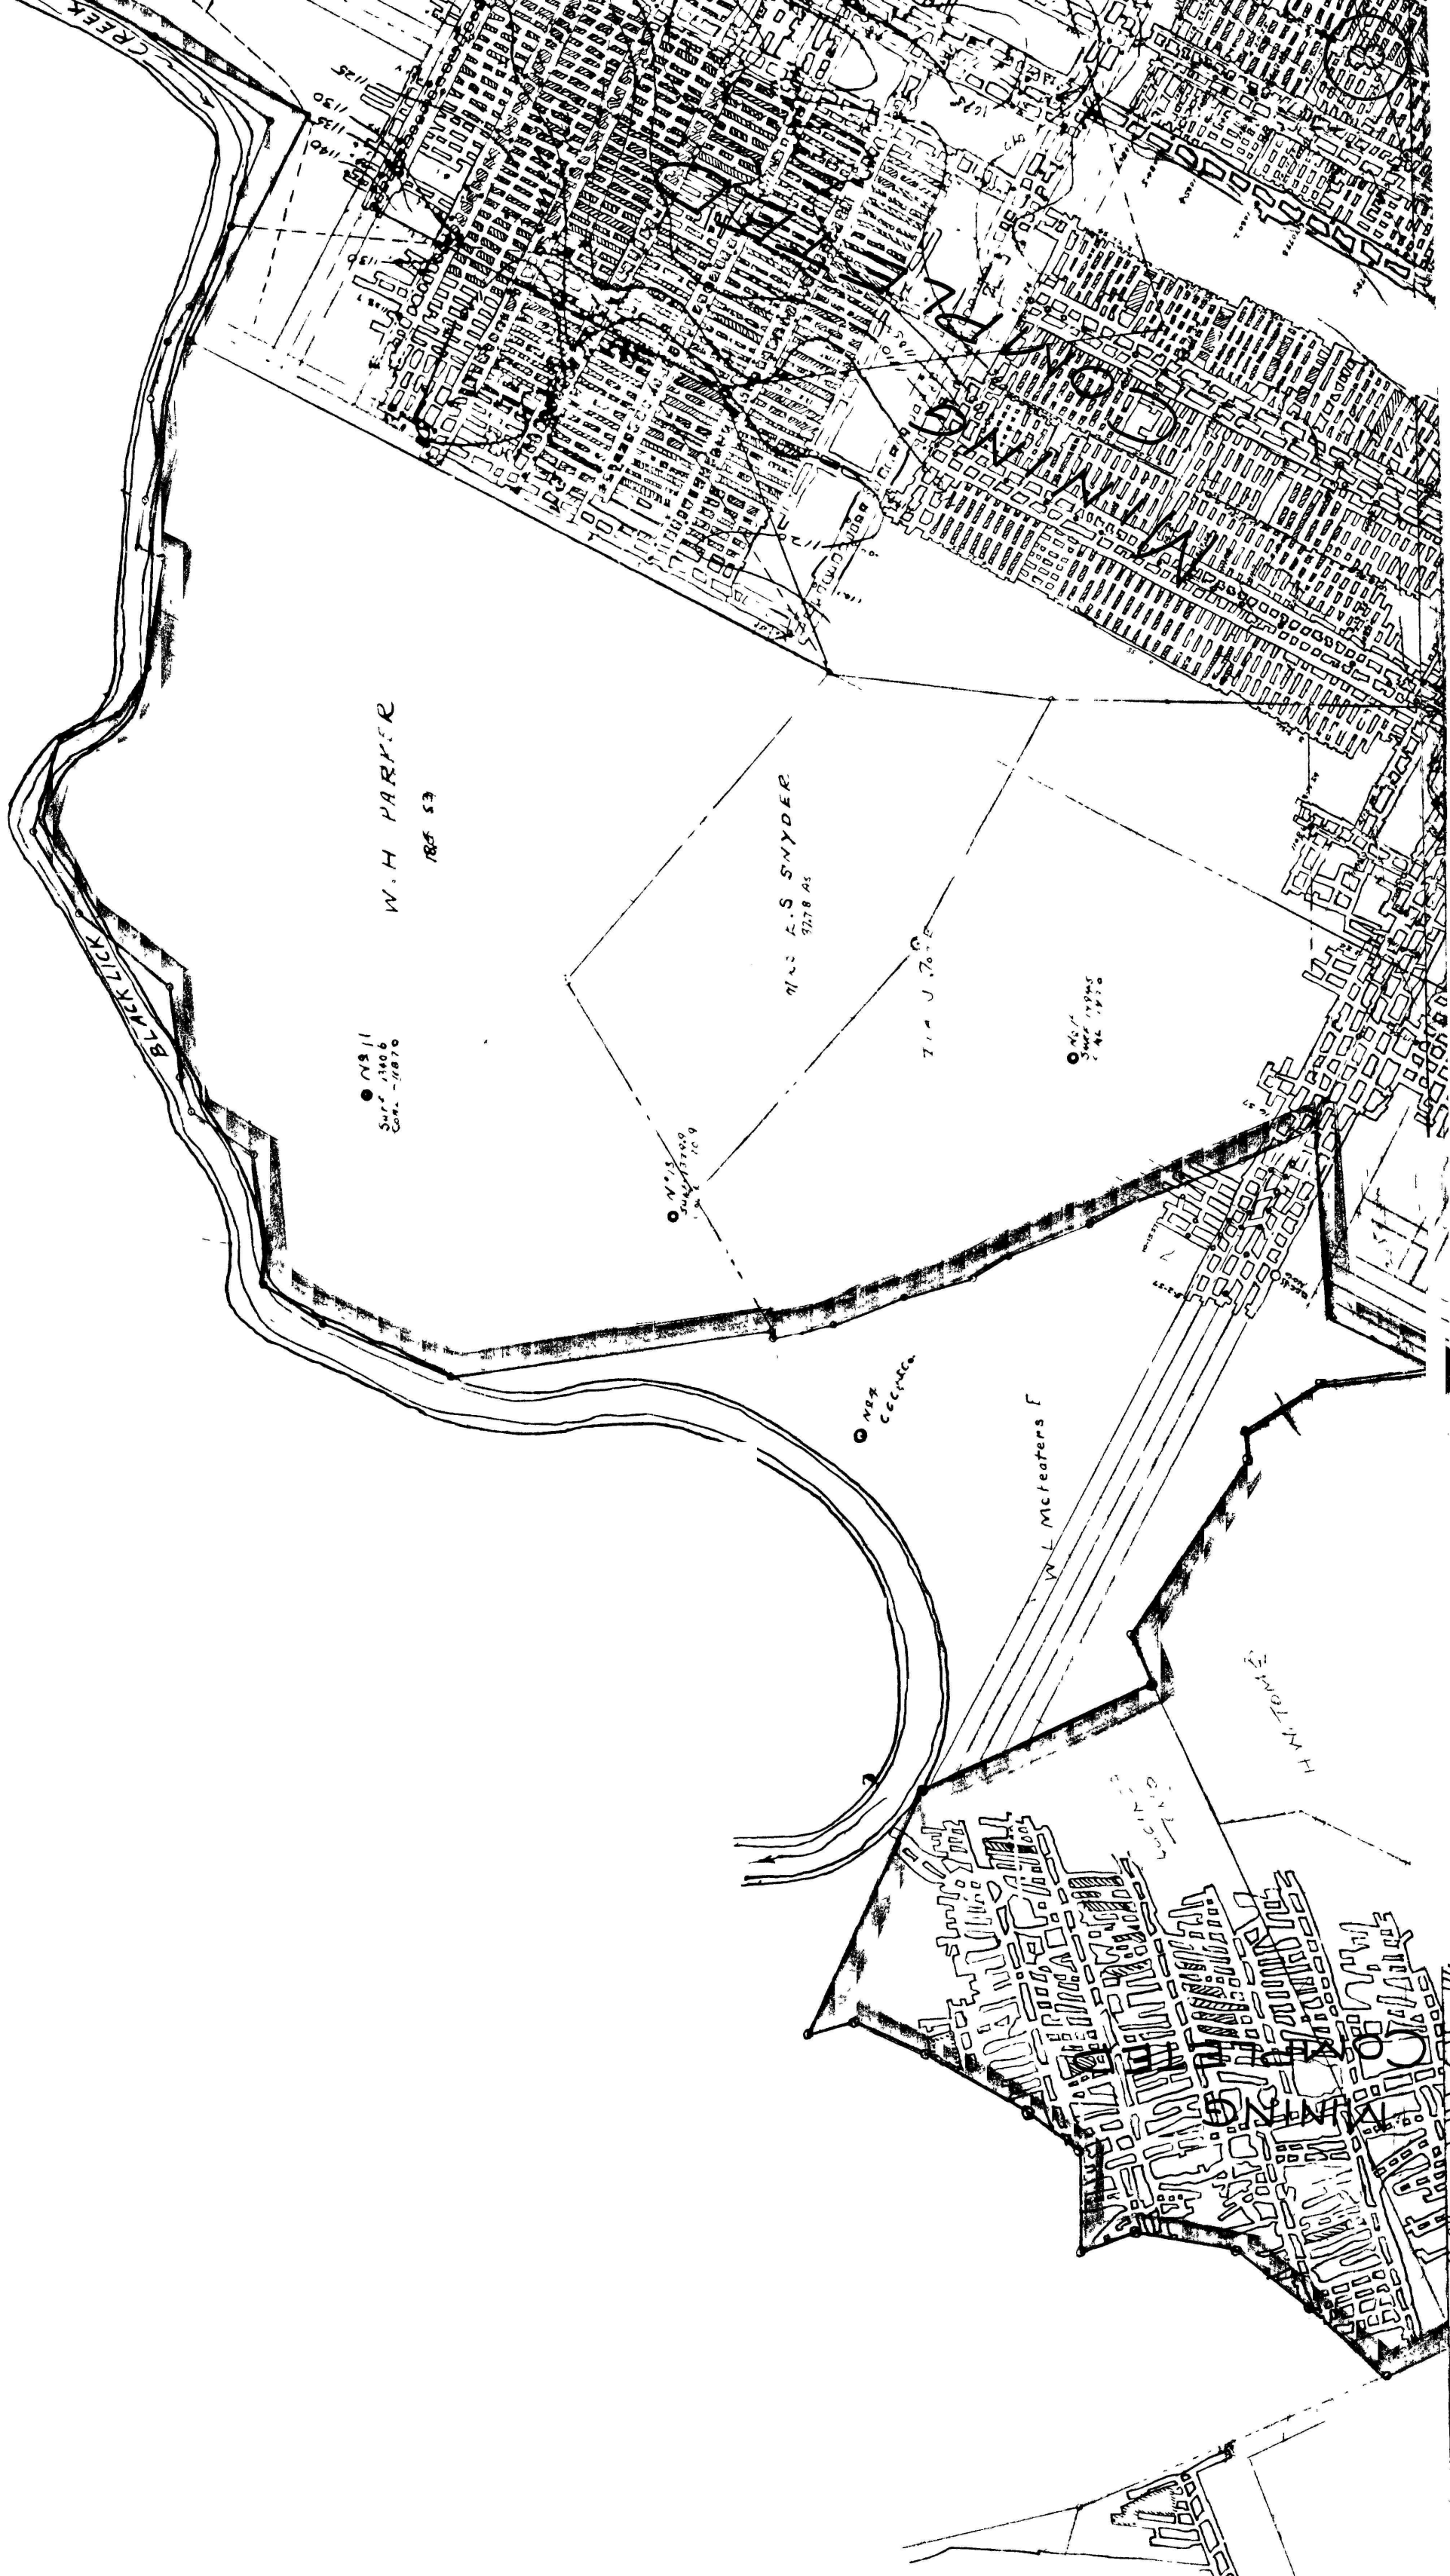

W. H. PARKER
1855 S3

MRS. E. S. SNYDER
9278 AS

N 311
Surf. 13406
Cor. - 11870

N 119
Surf. 13409
Cor. - 11870

N 82
Cecilia

W. L. McTeeters

H. TOWN

