



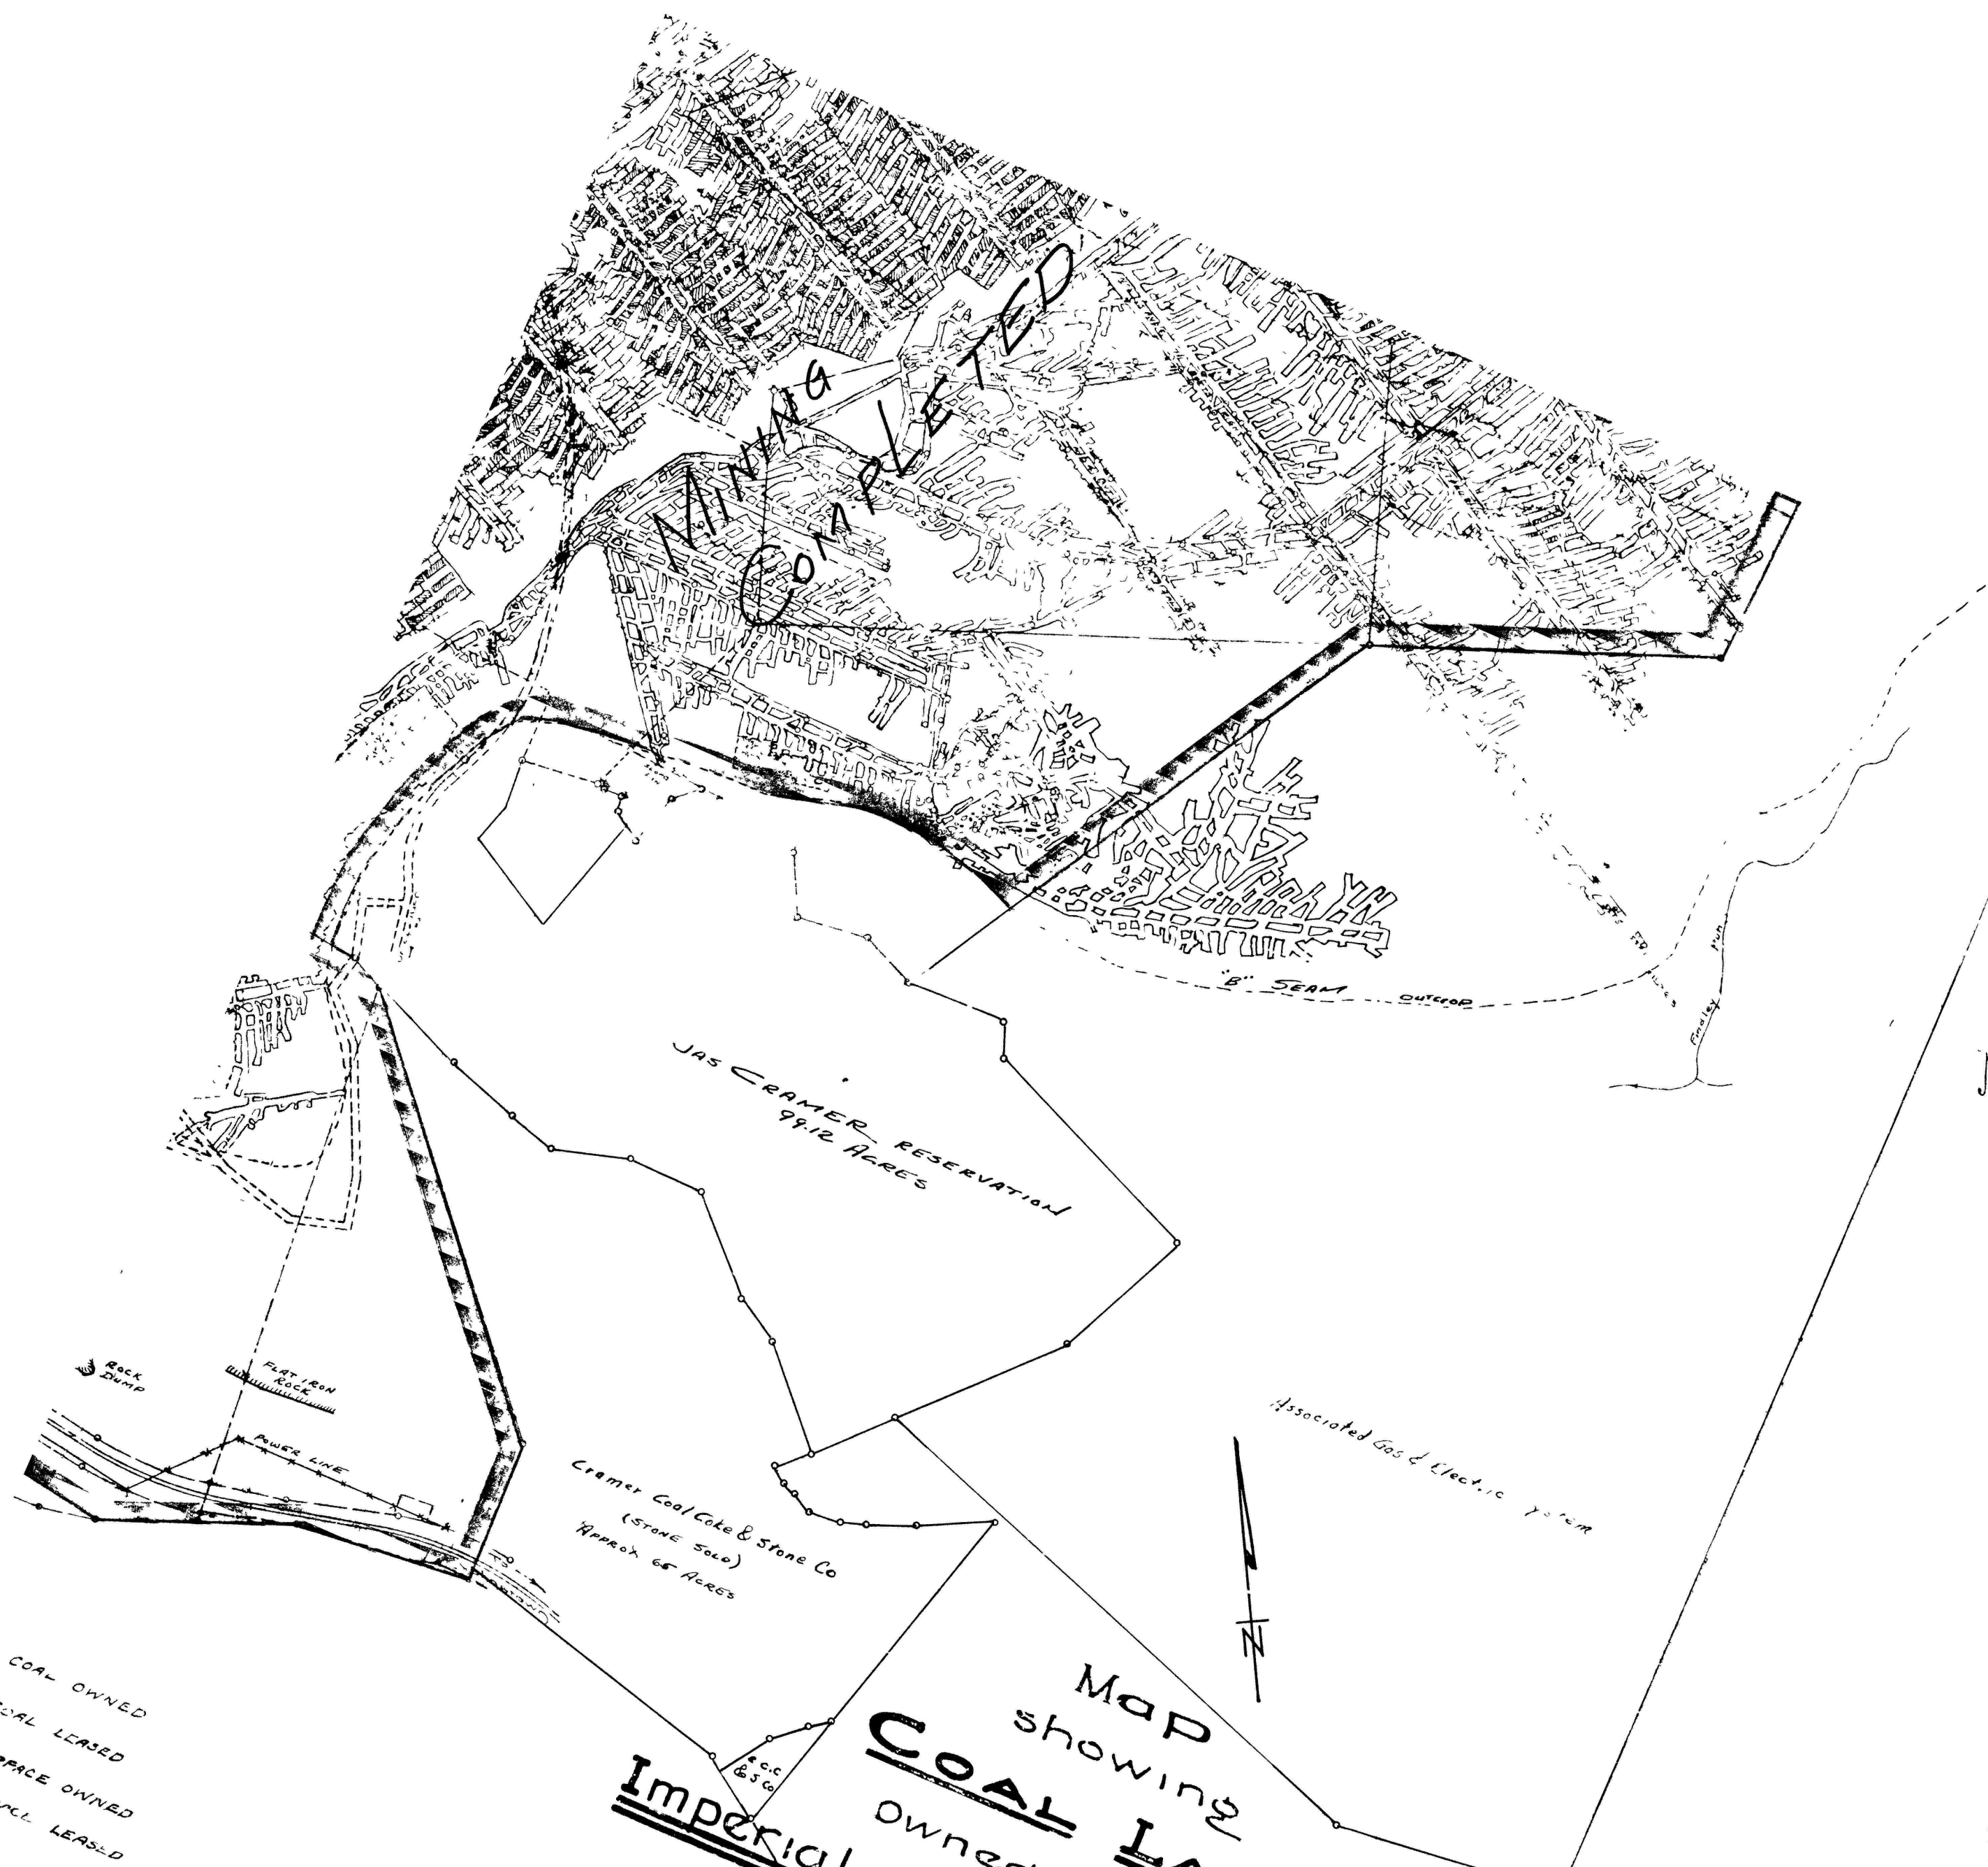

Map showing
COAL LANDS
Owned by the
Imperial Coal Corporation
situate in
East Wheatfield Twp. Indiana Co., Pa.

Scale 1" = 400'

Prepared by Eng'g Co. December 1, 1919

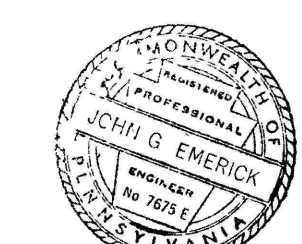

John G. Emerick

LEGEND


COAL OWNED
COAL LEASED
SURFACE OWNED
SURFACE LEASED

POSTED TO: 12-31-65

#802
7-8-99
CC