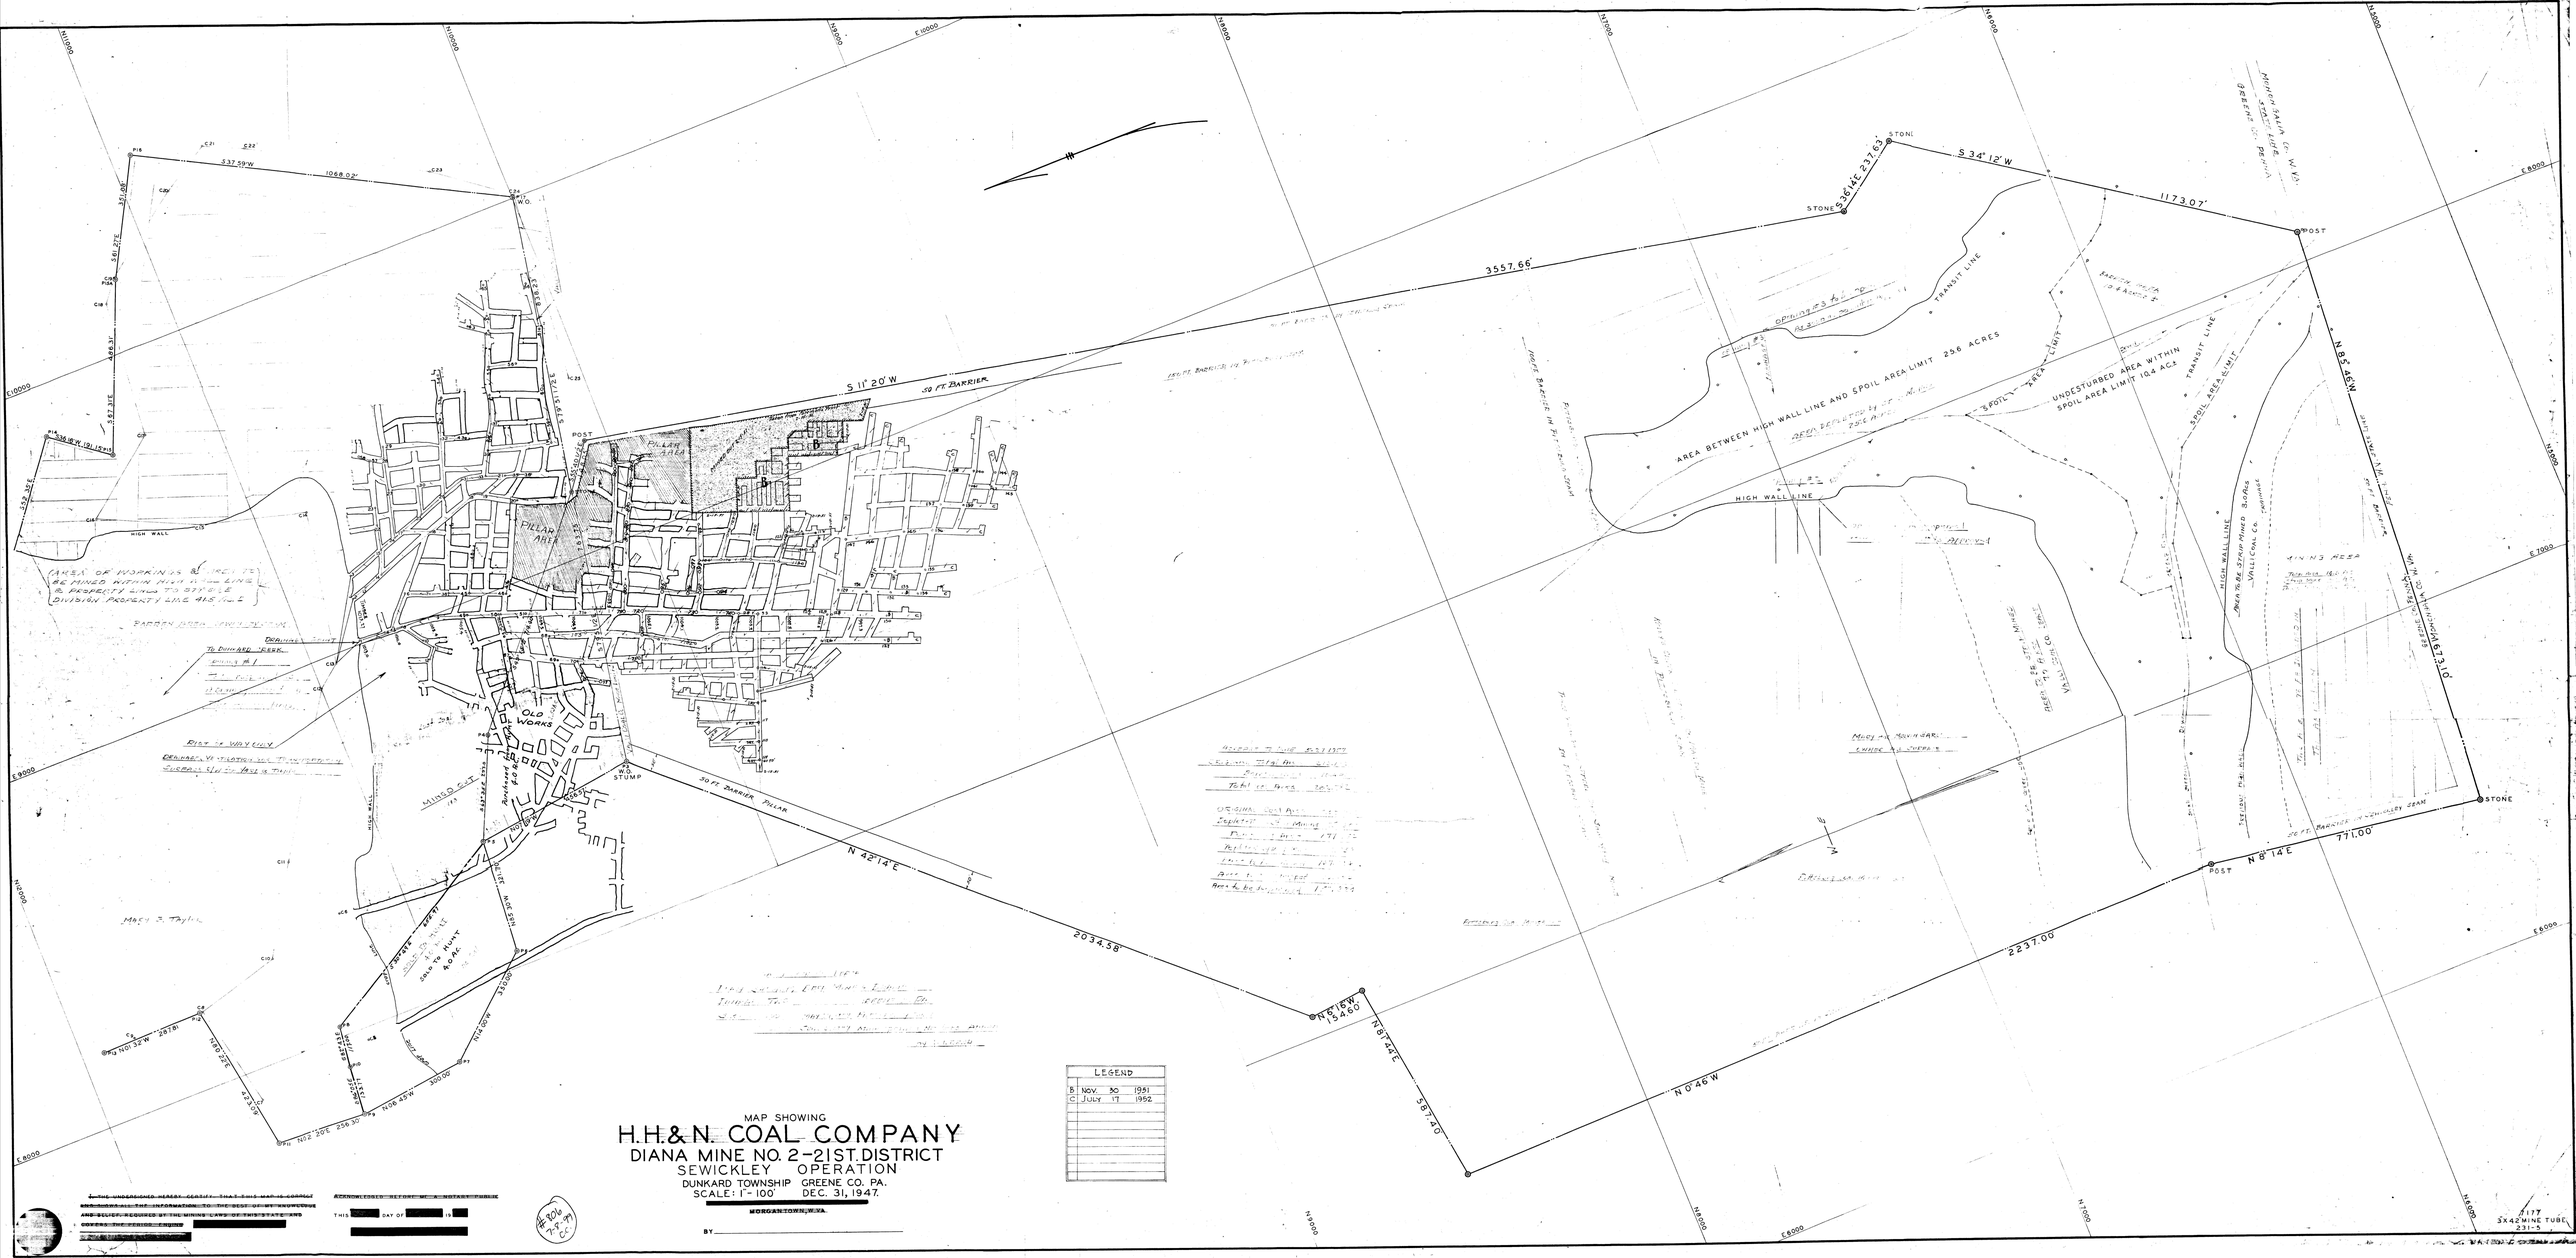
MAP SHOWING
H.H.&N. COAL COMPANY
DIANA MINE NO. 2-21ST. DISTRICT
SEWICKLEY OPERATION
DUNKARD TOWNSHIP GREENE CO. PA.
SCALE: 1"-100' DEC. 31, 1947.
MORGANTOWN, W.VA.
BY
LEGEND
B NOV. 30 1951
C JULY 17 1952
PILLAR AREA
OLD WORKS
MINE SLIT
S 11° 20' W
50 FT. BARRIER
3557.66'
S 34° 12' W
1173.07'
N 85° 45' W
1663.10'
N 8° 14' E
771.00'
2237.00'
N 0° 46' W
587.40'
N 81° 44' E
N 42° 14' E
2034.58'
50 FT. BARRIER PILLAR
AREA BETWEEN HIGH WALL LINE AND SPOIL AREA LIMIT 256 ACRES
UNDESTURBED AREA WITHIN SPOIL AREA LIMIT 104 ACS
HIGH WALL LINE
TRANSIT LINE
SPOIL AREA LIMIT
POST
STONE
N.W.CORNER 15460
ACKNOWLEDGED BEFORE ME A NOTARY PUBLIC
THIS DAY OF
BY
#806
11-7-71
CC
1177
5X42 MINE TUBE
231-5