


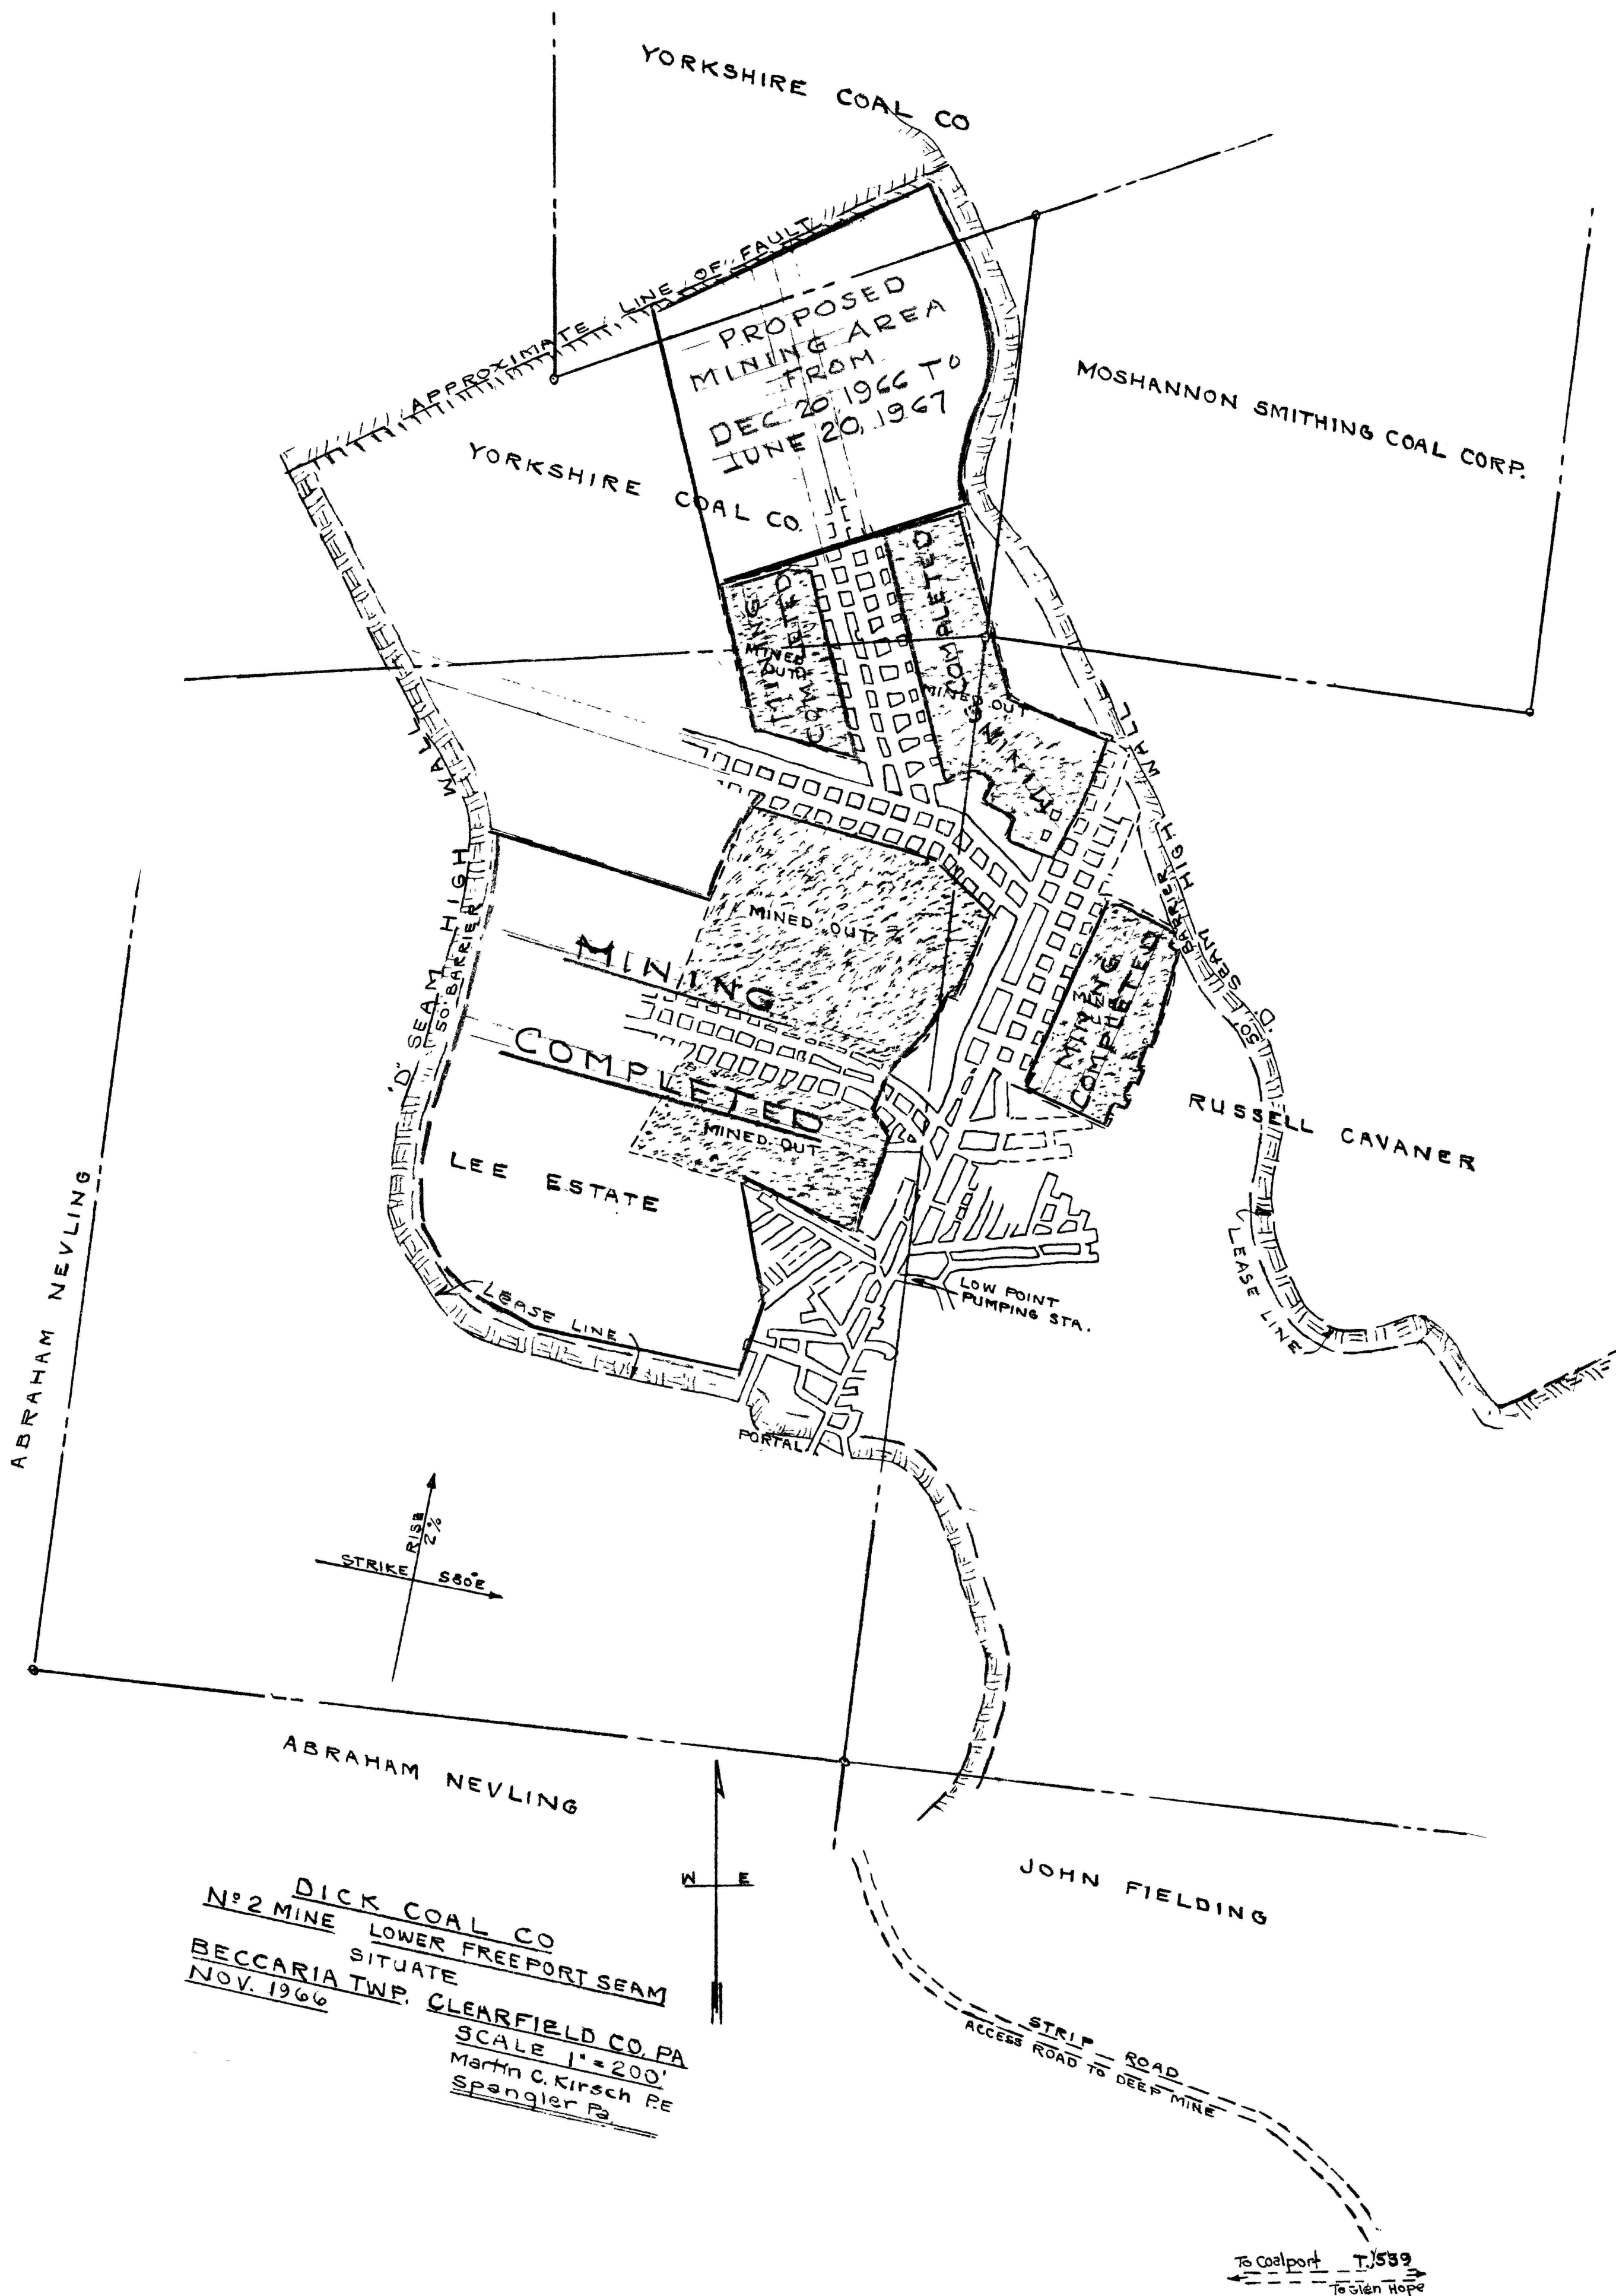

DICK COAL CO
LOWER FREEPORT SEAM
SITUATE
BECCARIA TWP. CLEARFIELD CO. PA
NOV. 1966
SCALE 1" = 200'
Martin C. Kirsch RE
Spangler Pa.

To Coalport T. 539
To Glen Hope