


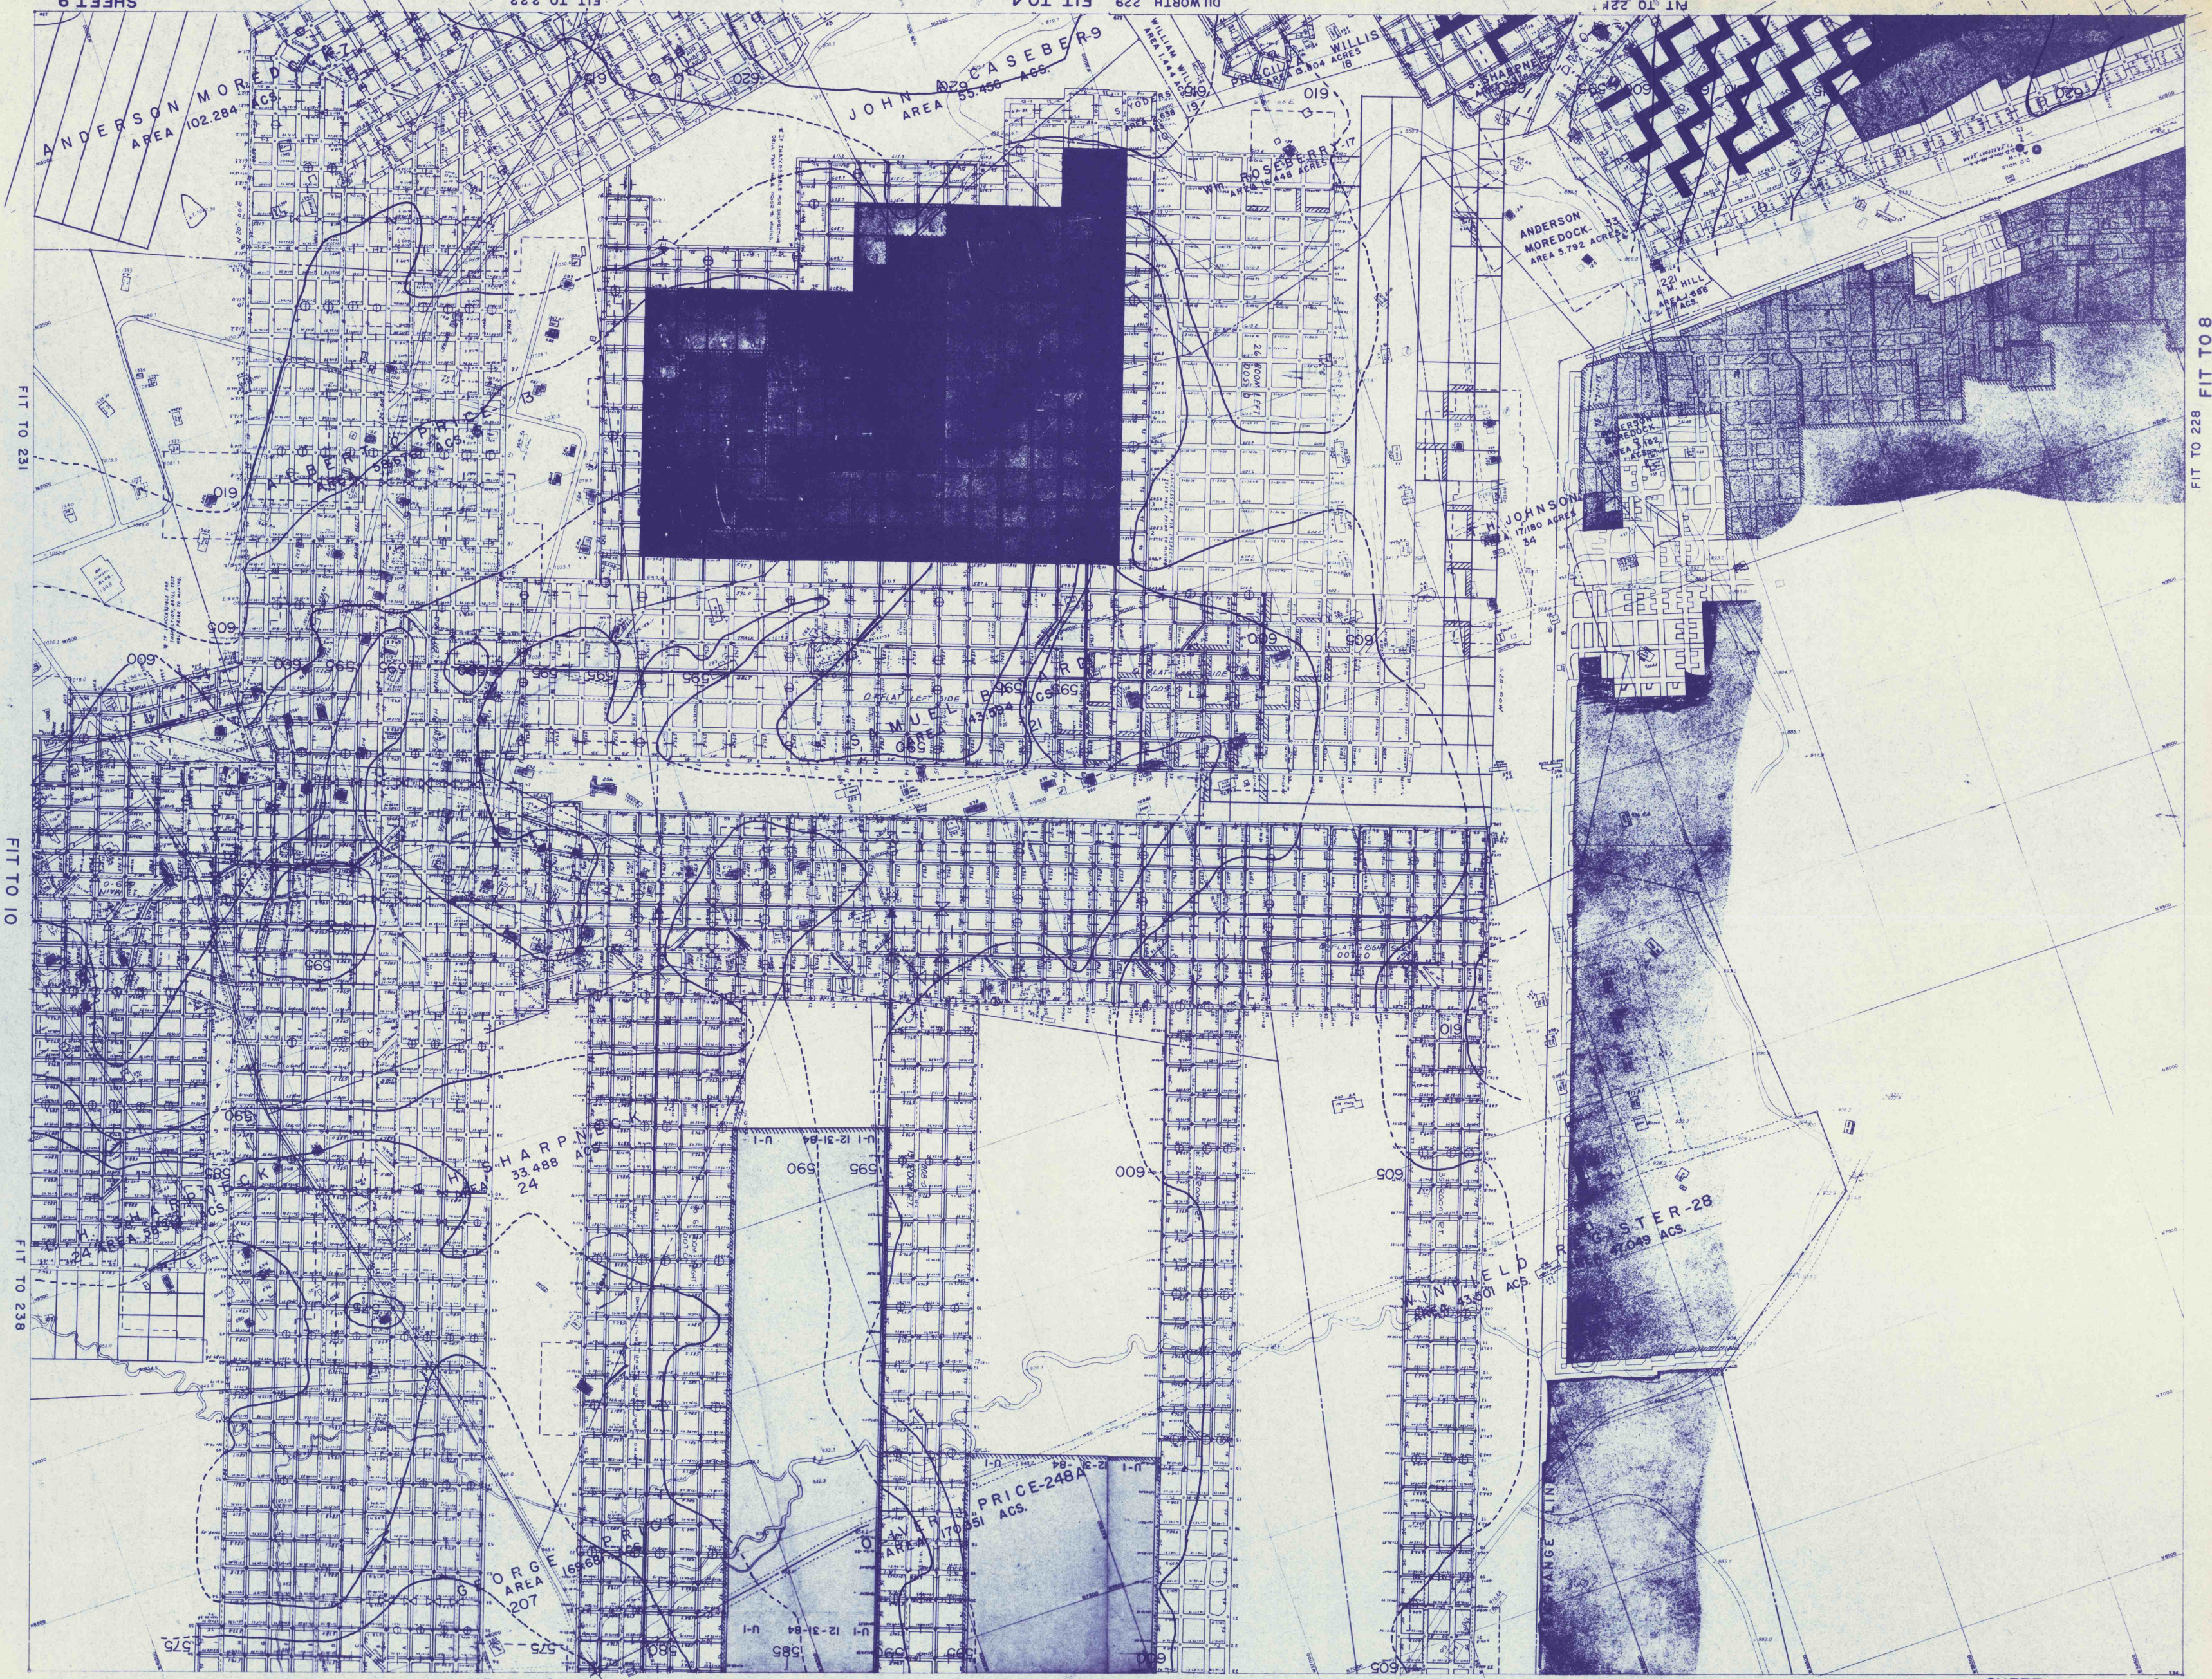

SHEET 9

FIT TO 231

FIT TO 10

FIT TO 238

FIT TO 244

DILWORTH 237 FIT TO 13

FIT TO 243

SHEET 9

FIT TO 228 FIT TO 8