


REED SMITH

YEAGER

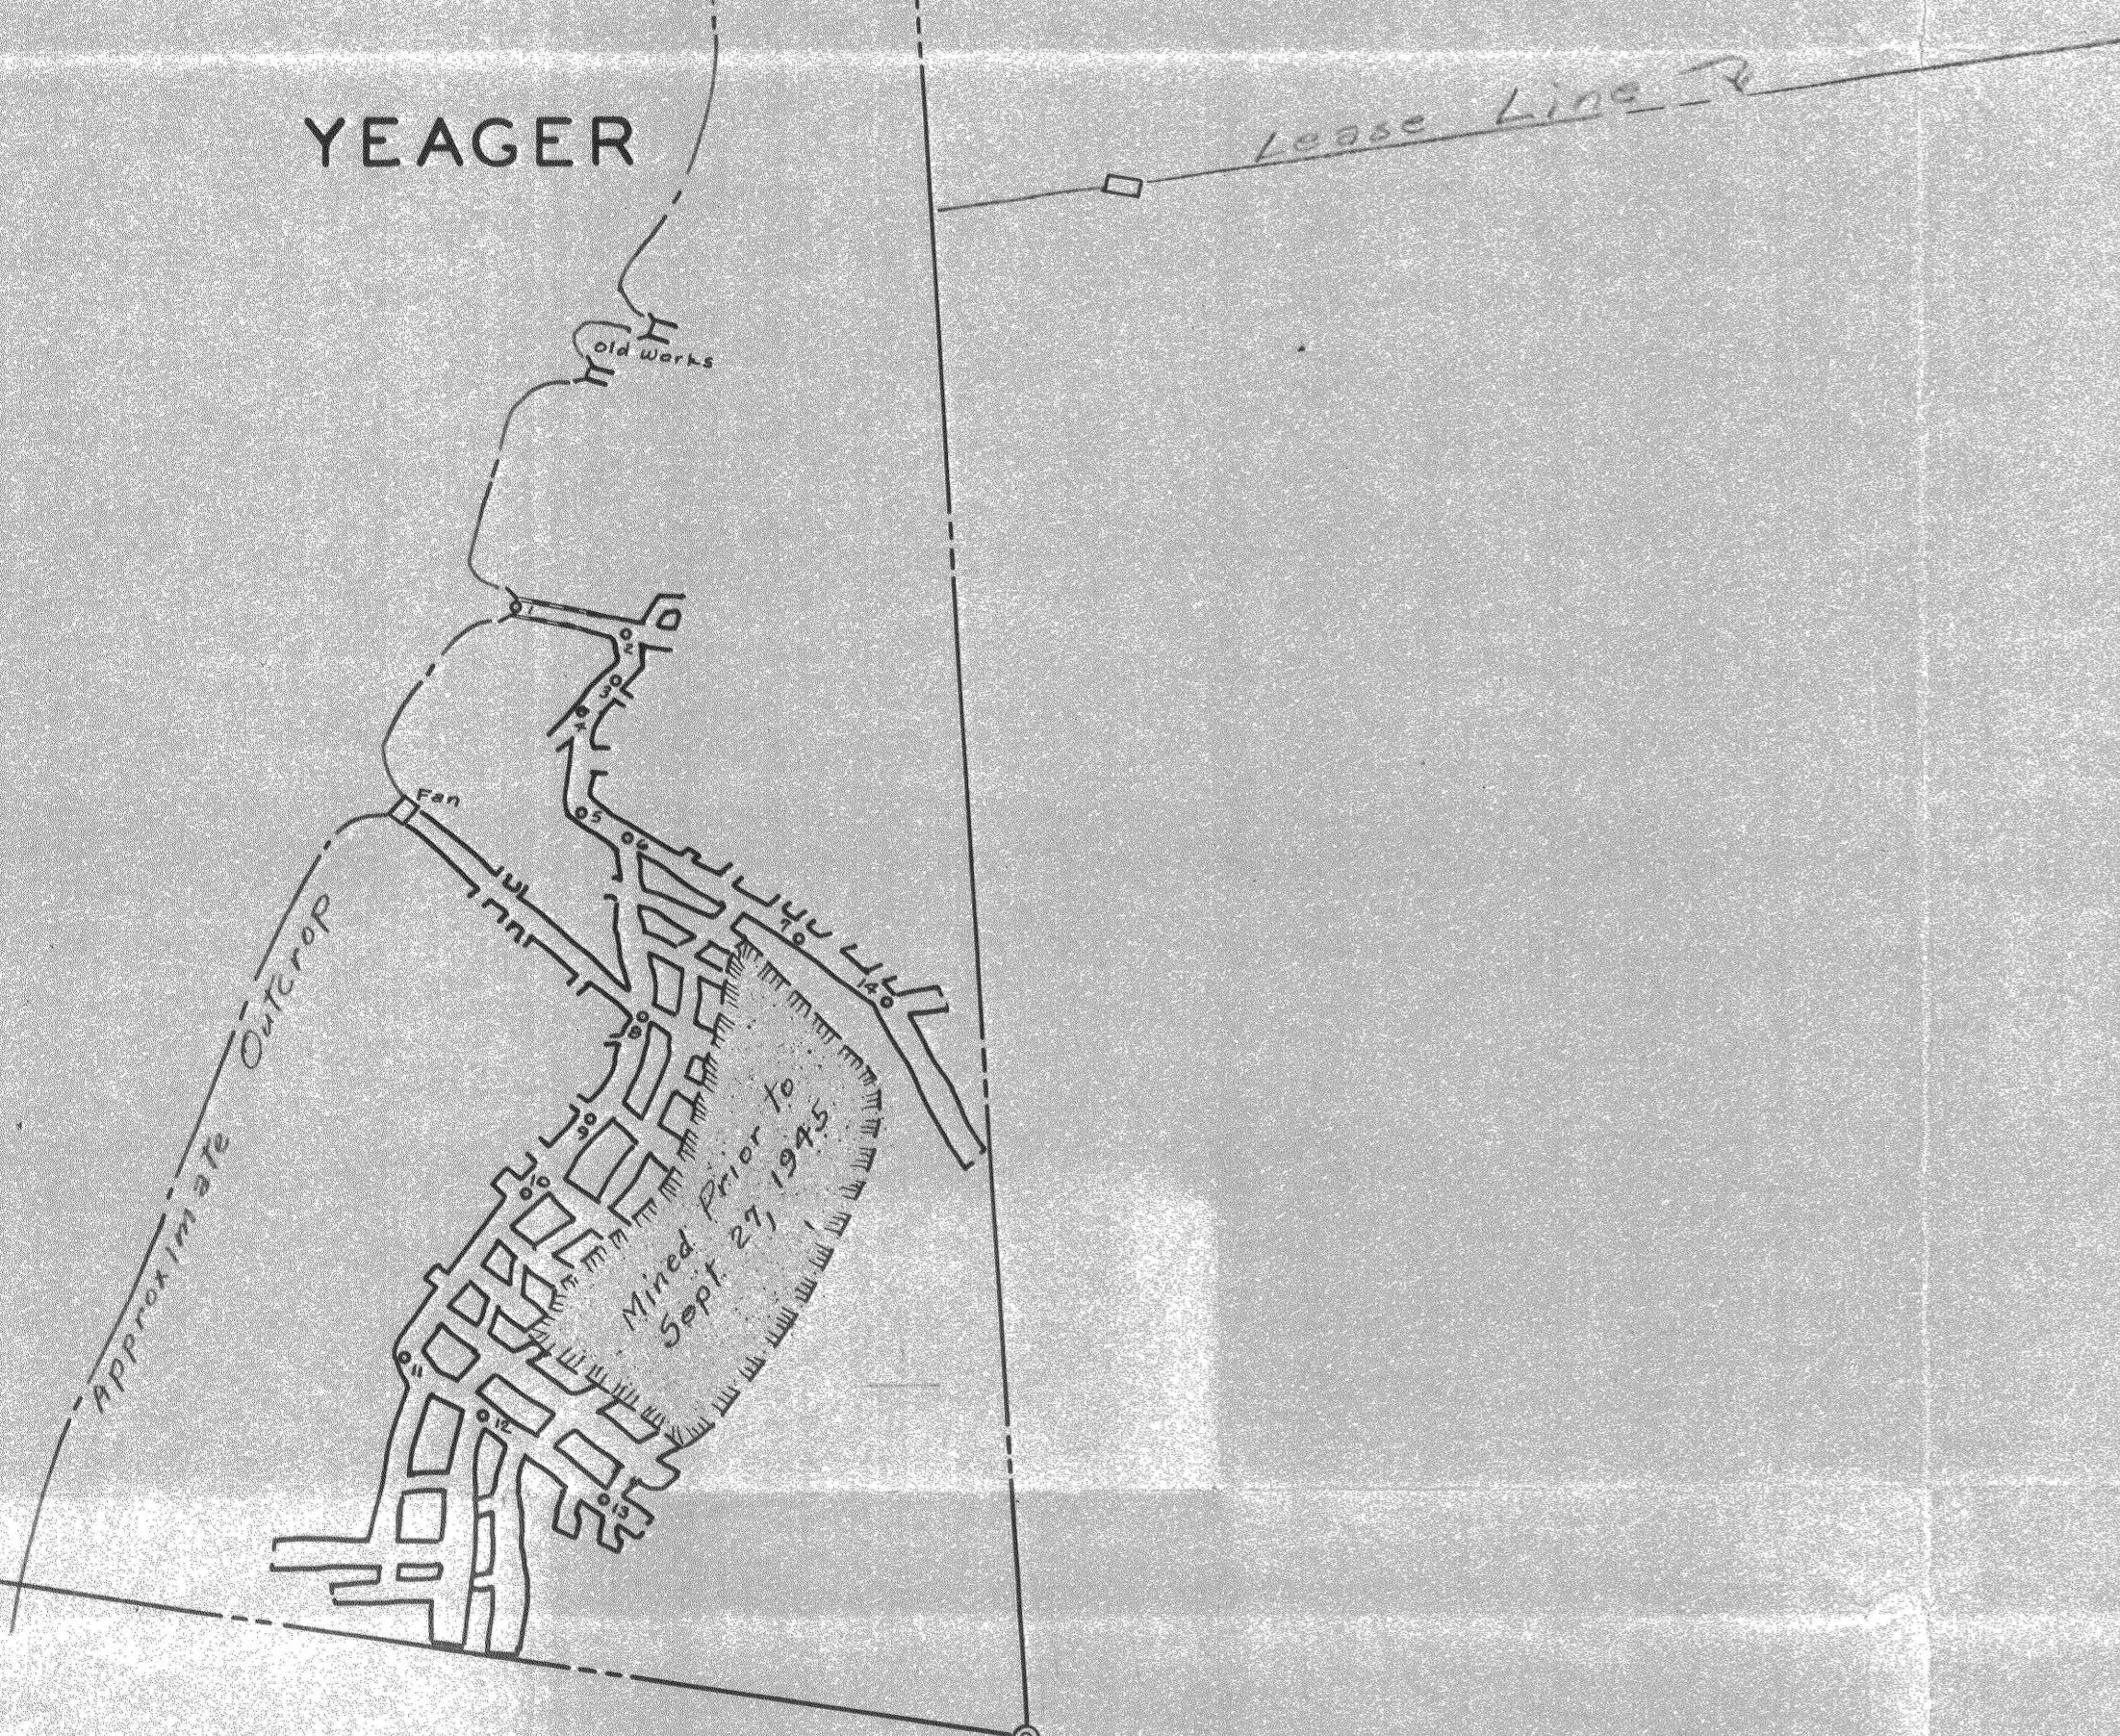

MAURER

TOWNSHIP  
Road  
No. 385

DOBSON

Barn

MINE MAP  
DOBSON COAL CO.,  
MINE

OLIVER TOWNSHIP, JEFFERSON COUNTY, PA.

SCALE 1 IN. = 100 FT. OCT., 1945  
WALTER J. ZIMMERMAN SURVEYOR,  
PUNXSUTAWNEY, PA.

