




MSHA I.D. No. 36-06583 CMAP No. 33841303

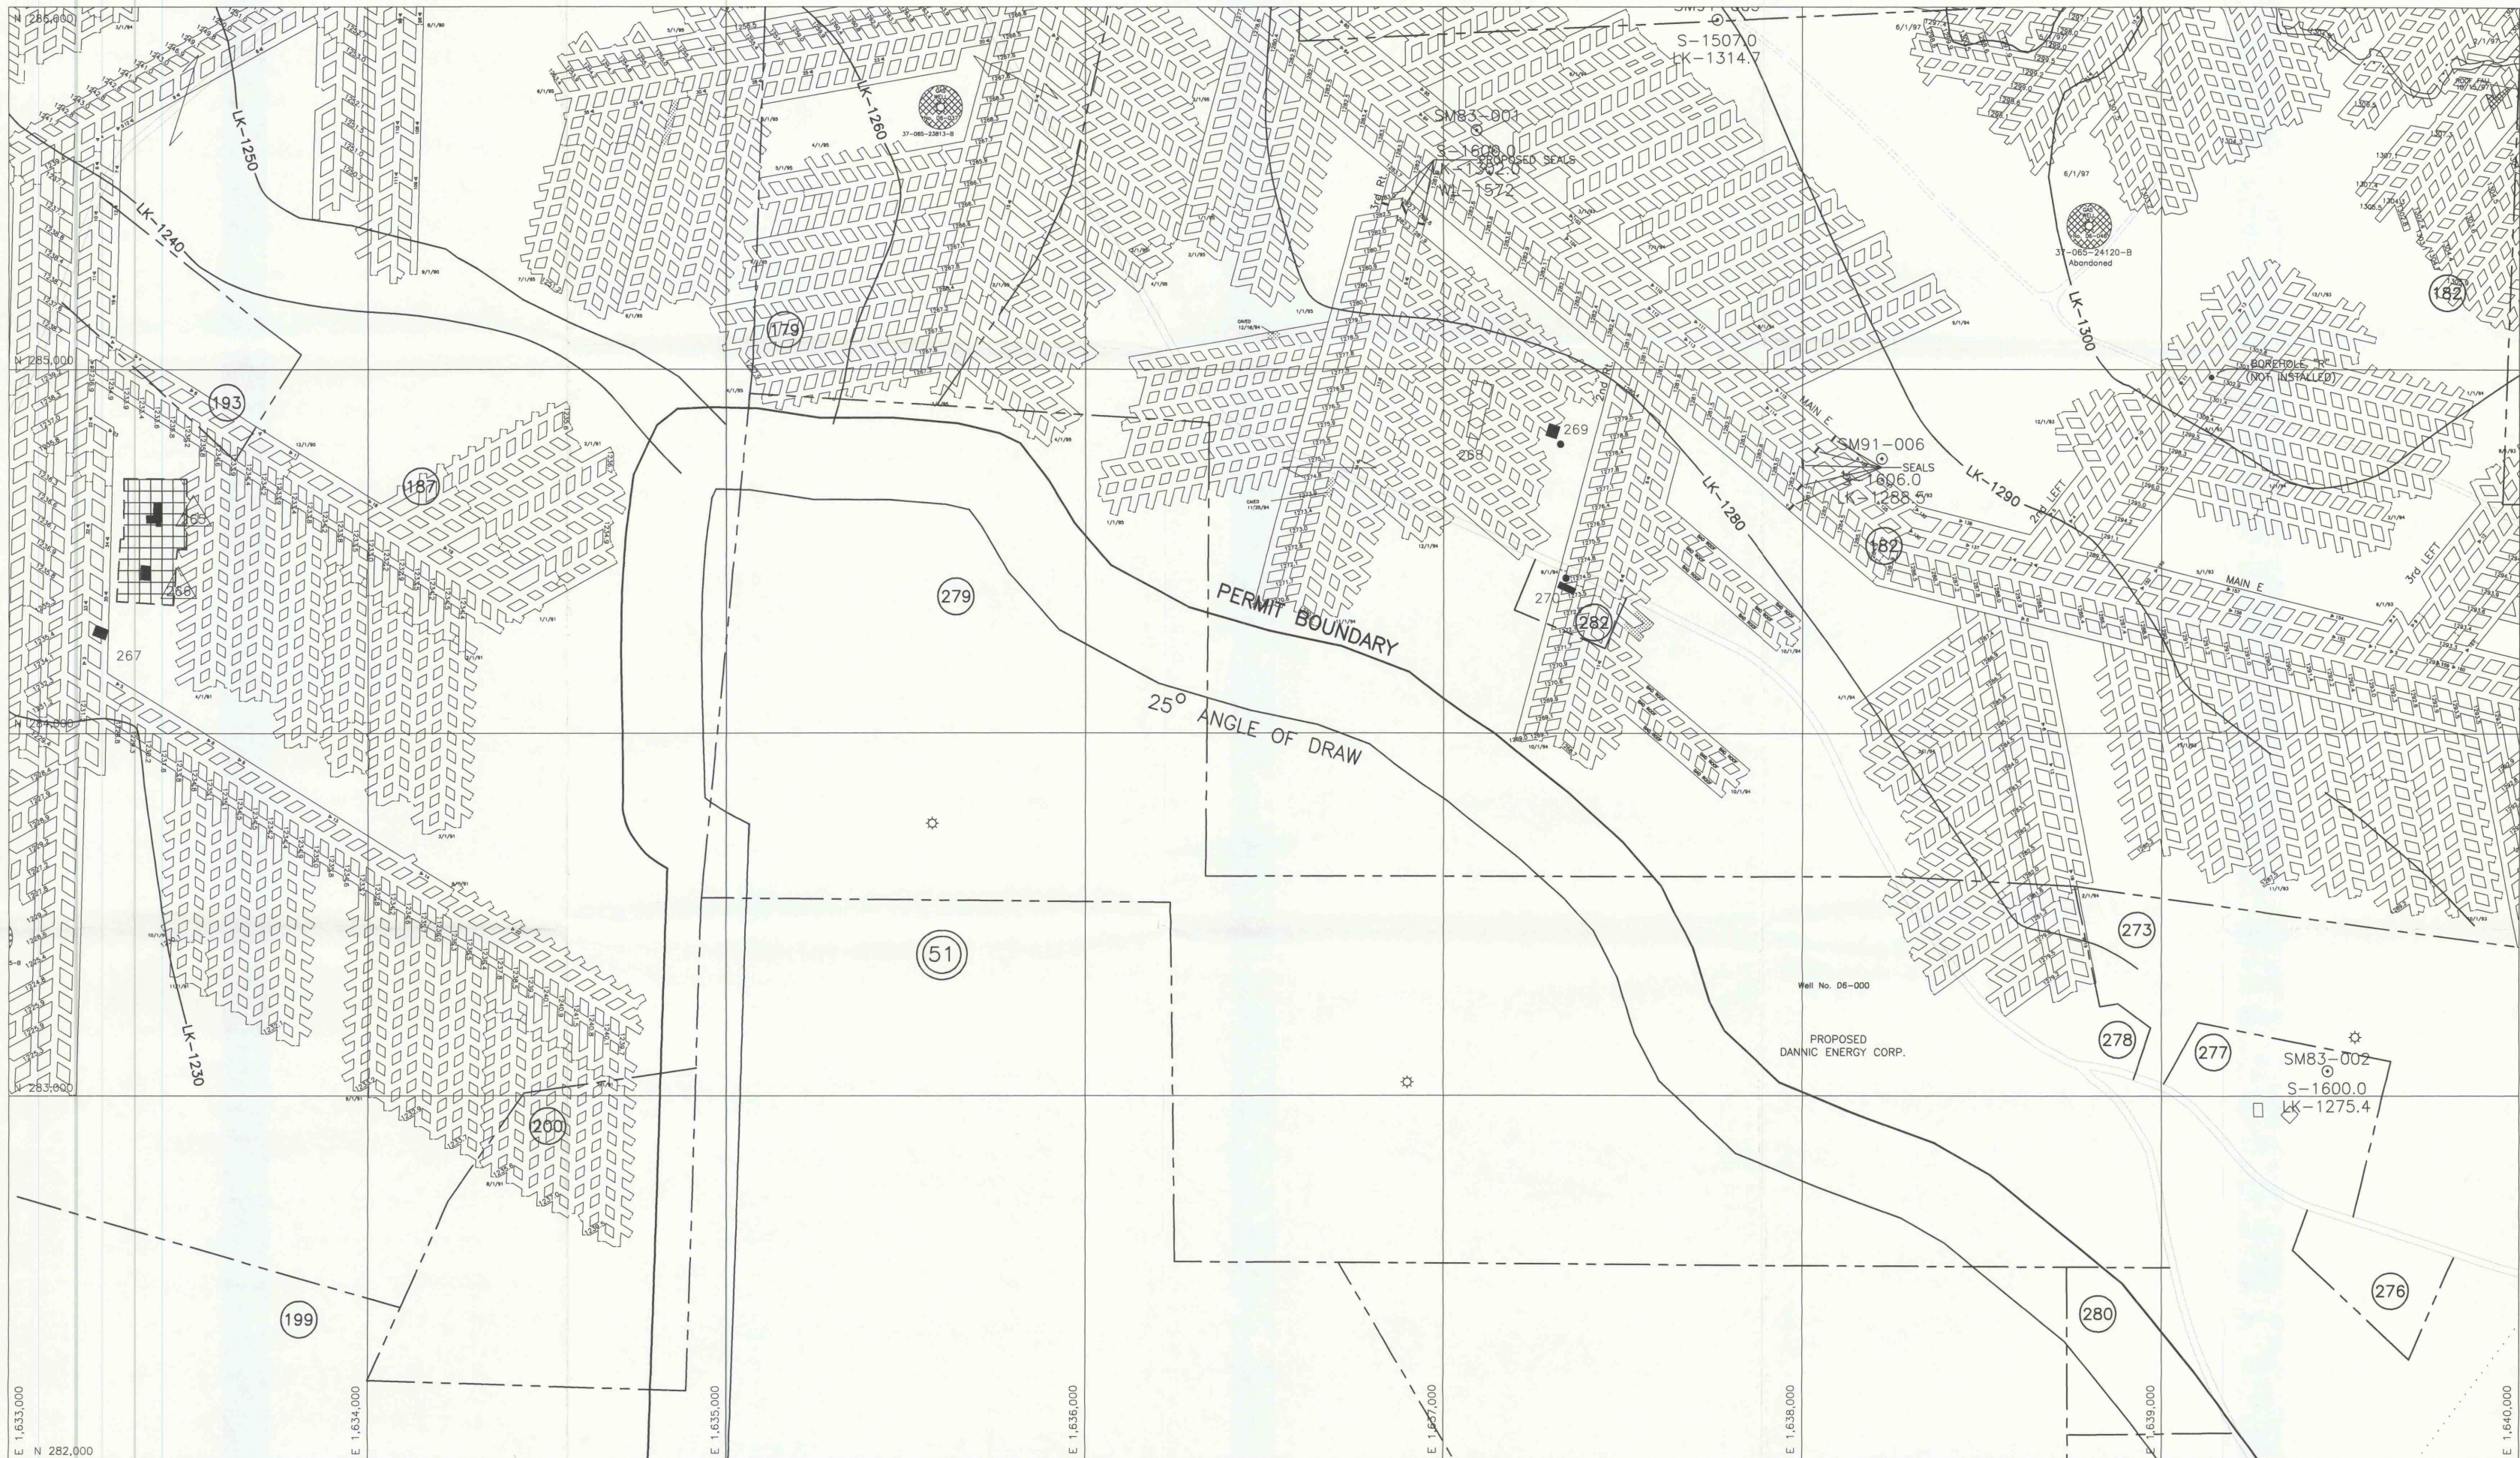

Doverspike Bros. Coal Co.
R.D. #4, Box 271, Punxsutawney, PA 15767
Porter & Perry Twp., Jefferson County

DORA #6 MINE

SCALE: 1" = 200' SHEET 15 of 24

Final Mine Map


- PERMIT AREA
- PROPERTY LINES
- PROPERTY OWNERS
- CONT. PROPERTY OWNERS
- PRE-66 DWELLINGS
- DWELLINGS, STRUCTURES
- PROT. ACT 54 STRUCTURES
- LK-1480 L.K. COAL CONTOURS
- L.K. COAL OUTCROP

- GAS LINE
- GAS WELL
- TELE./ELEC. LINES
- WATER WELL
- SPRING
- DRILL HOLE
- IMPOUNDMENT
- CEMETERY
- MINE OPENINGS, NOT SEALED
- MINE OPENINGS, SEALED
- STREAMS
- SURVEY STATION
- SUPPORT AREA (No Second Mining)
- L.F. DEEP MINE
- ZONE OF POTENTIAL INFLUENCE
- GAS WELL BARRIER (No Mining Within Barrier Unless Approved)

- INTAKE AIR
- RETURN AIR
- BELT LINE
- STOPPING
- STOPPING W/ DOOR
- CHECK CURTAIN
- REGULATOR
- DOUBLE DOORS
- RUN-THROUGH CHECK
- OVERCAST



SURVEY IS CLOSED LOOP; ACCURACY IS 1:10000
INDIVIDUALS RESPONSIBLE FOR INFORMATION:
CHARLES ISHMAN, ENGINEER & CHUCK MARTZ, SUPERINTENDENT
MAP FULFILLS REQUIREMENTS OF 75.372 & 75.1200
NO ADJACENT MINE WORKINGS WITHIN 1000 FEET
NO MINE WORKINGS BELOW MINE PROPERTY

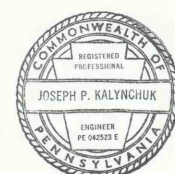

SIGNATURE *Joseph P. Kalynduk*
4-14-99

FINAL MINE MAP