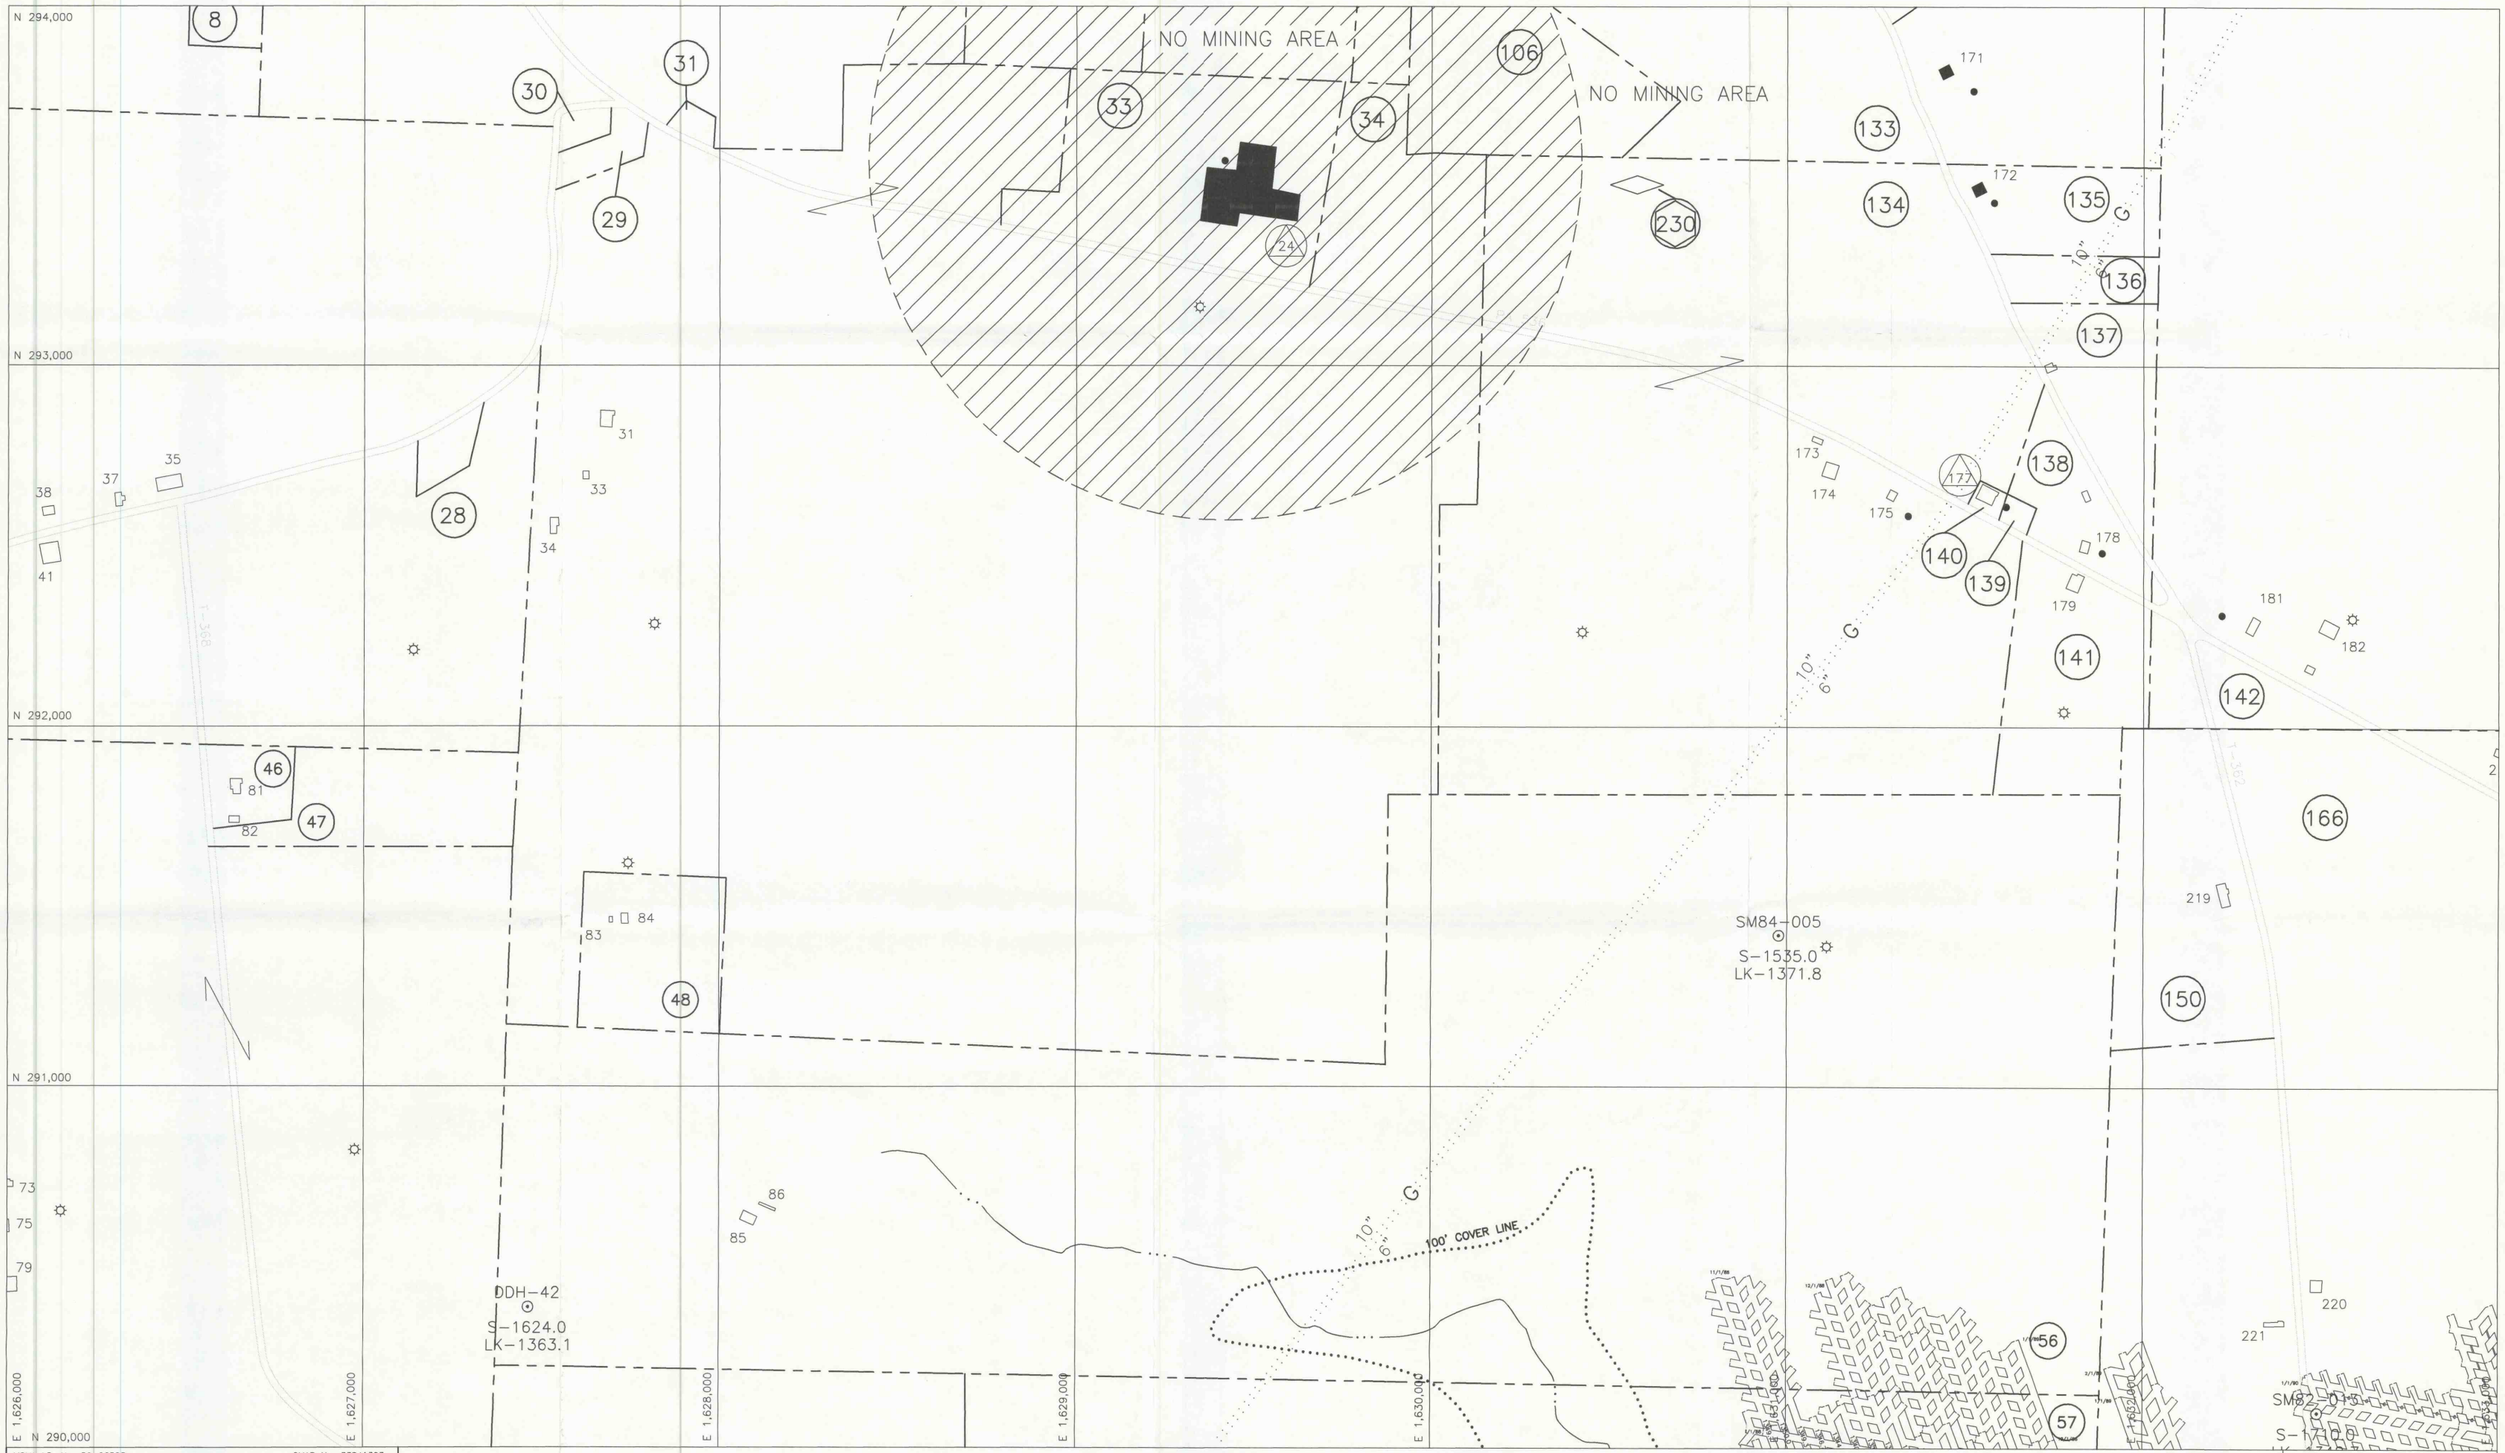

MSHA I.D. No. 36-06583

CMAP No. 33841303

Stanford

Doverspike Bros. Coal Co.
R.D. #4, Box 271, Punxsutawney, PA 15767
Porter & Perry Twps., Jefferson County

DORA #6 MINE

SCALE: 1" = 200'

SHEET 6 of 24

Final Mine Map

PERMIT AREA
PROPERTY LINES
PROPERTY OWNERS
CONT. PROPERTY OWNERS
PRE-66 DWELLINGS
DWELLINGS, STRUCTURES
PROT. ACT 54 STRUCTURES
LK-1480 L.K. COAL CONTOURS
L.K. COAL OUTCROP
GAS LINE
GAS WELL
TELE./ELEC. LINES
WATER WELL
SPRING
DRILL HOLE
IMPOUNDMENT
CEMETERY
MINE OPENINGS, NOT SEALED
MINE OPENINGS, SEALED
STREAMS
SURVEY STATION
SUPPORT AREA(No Second Mining)
L.F. DEEP MINE
ZONE OF POTENTIAL INFLUENCE
GAS WELL BARRIER (No Mining Within Barrier Unless Approved)
INTAKE AIR
RETURN AIR
BELT LINE
STOPPING
STOPPING W/ DOOR
CHECK CURTAIN
REGULATOR
DOUBLE DOORS
RUN-THROUGH CHECK
OVERCAST

N

DIP

SURVEY IS CLOSED LOOP; ACCURACY IS 1:10000
INDIVIDUALS RESPONSIBLE FOR INFORMATION:
CHARLES ISHMAN, ENGINEER & CHUCK MARTZ, SUPERINTENDENT
MAP FULFILLS REQUIREMENTS OF 75.372 & 75.1200
NO ADJACENT MINE WORKINGS WITHIN 1000 FEET
NO MINE WORKINGS BELOW MINE PROPERTY

FINAL MINE MAP

COMMONWEALTH OF PENNSYLVANIA
REGISTERED PROFESSIONAL
JOSEPH P. KALYNCHUK
ENGINEER
PE 042523 E

SIGNATURE Joseph P. Kalynchuk

DATE 4-14-99