




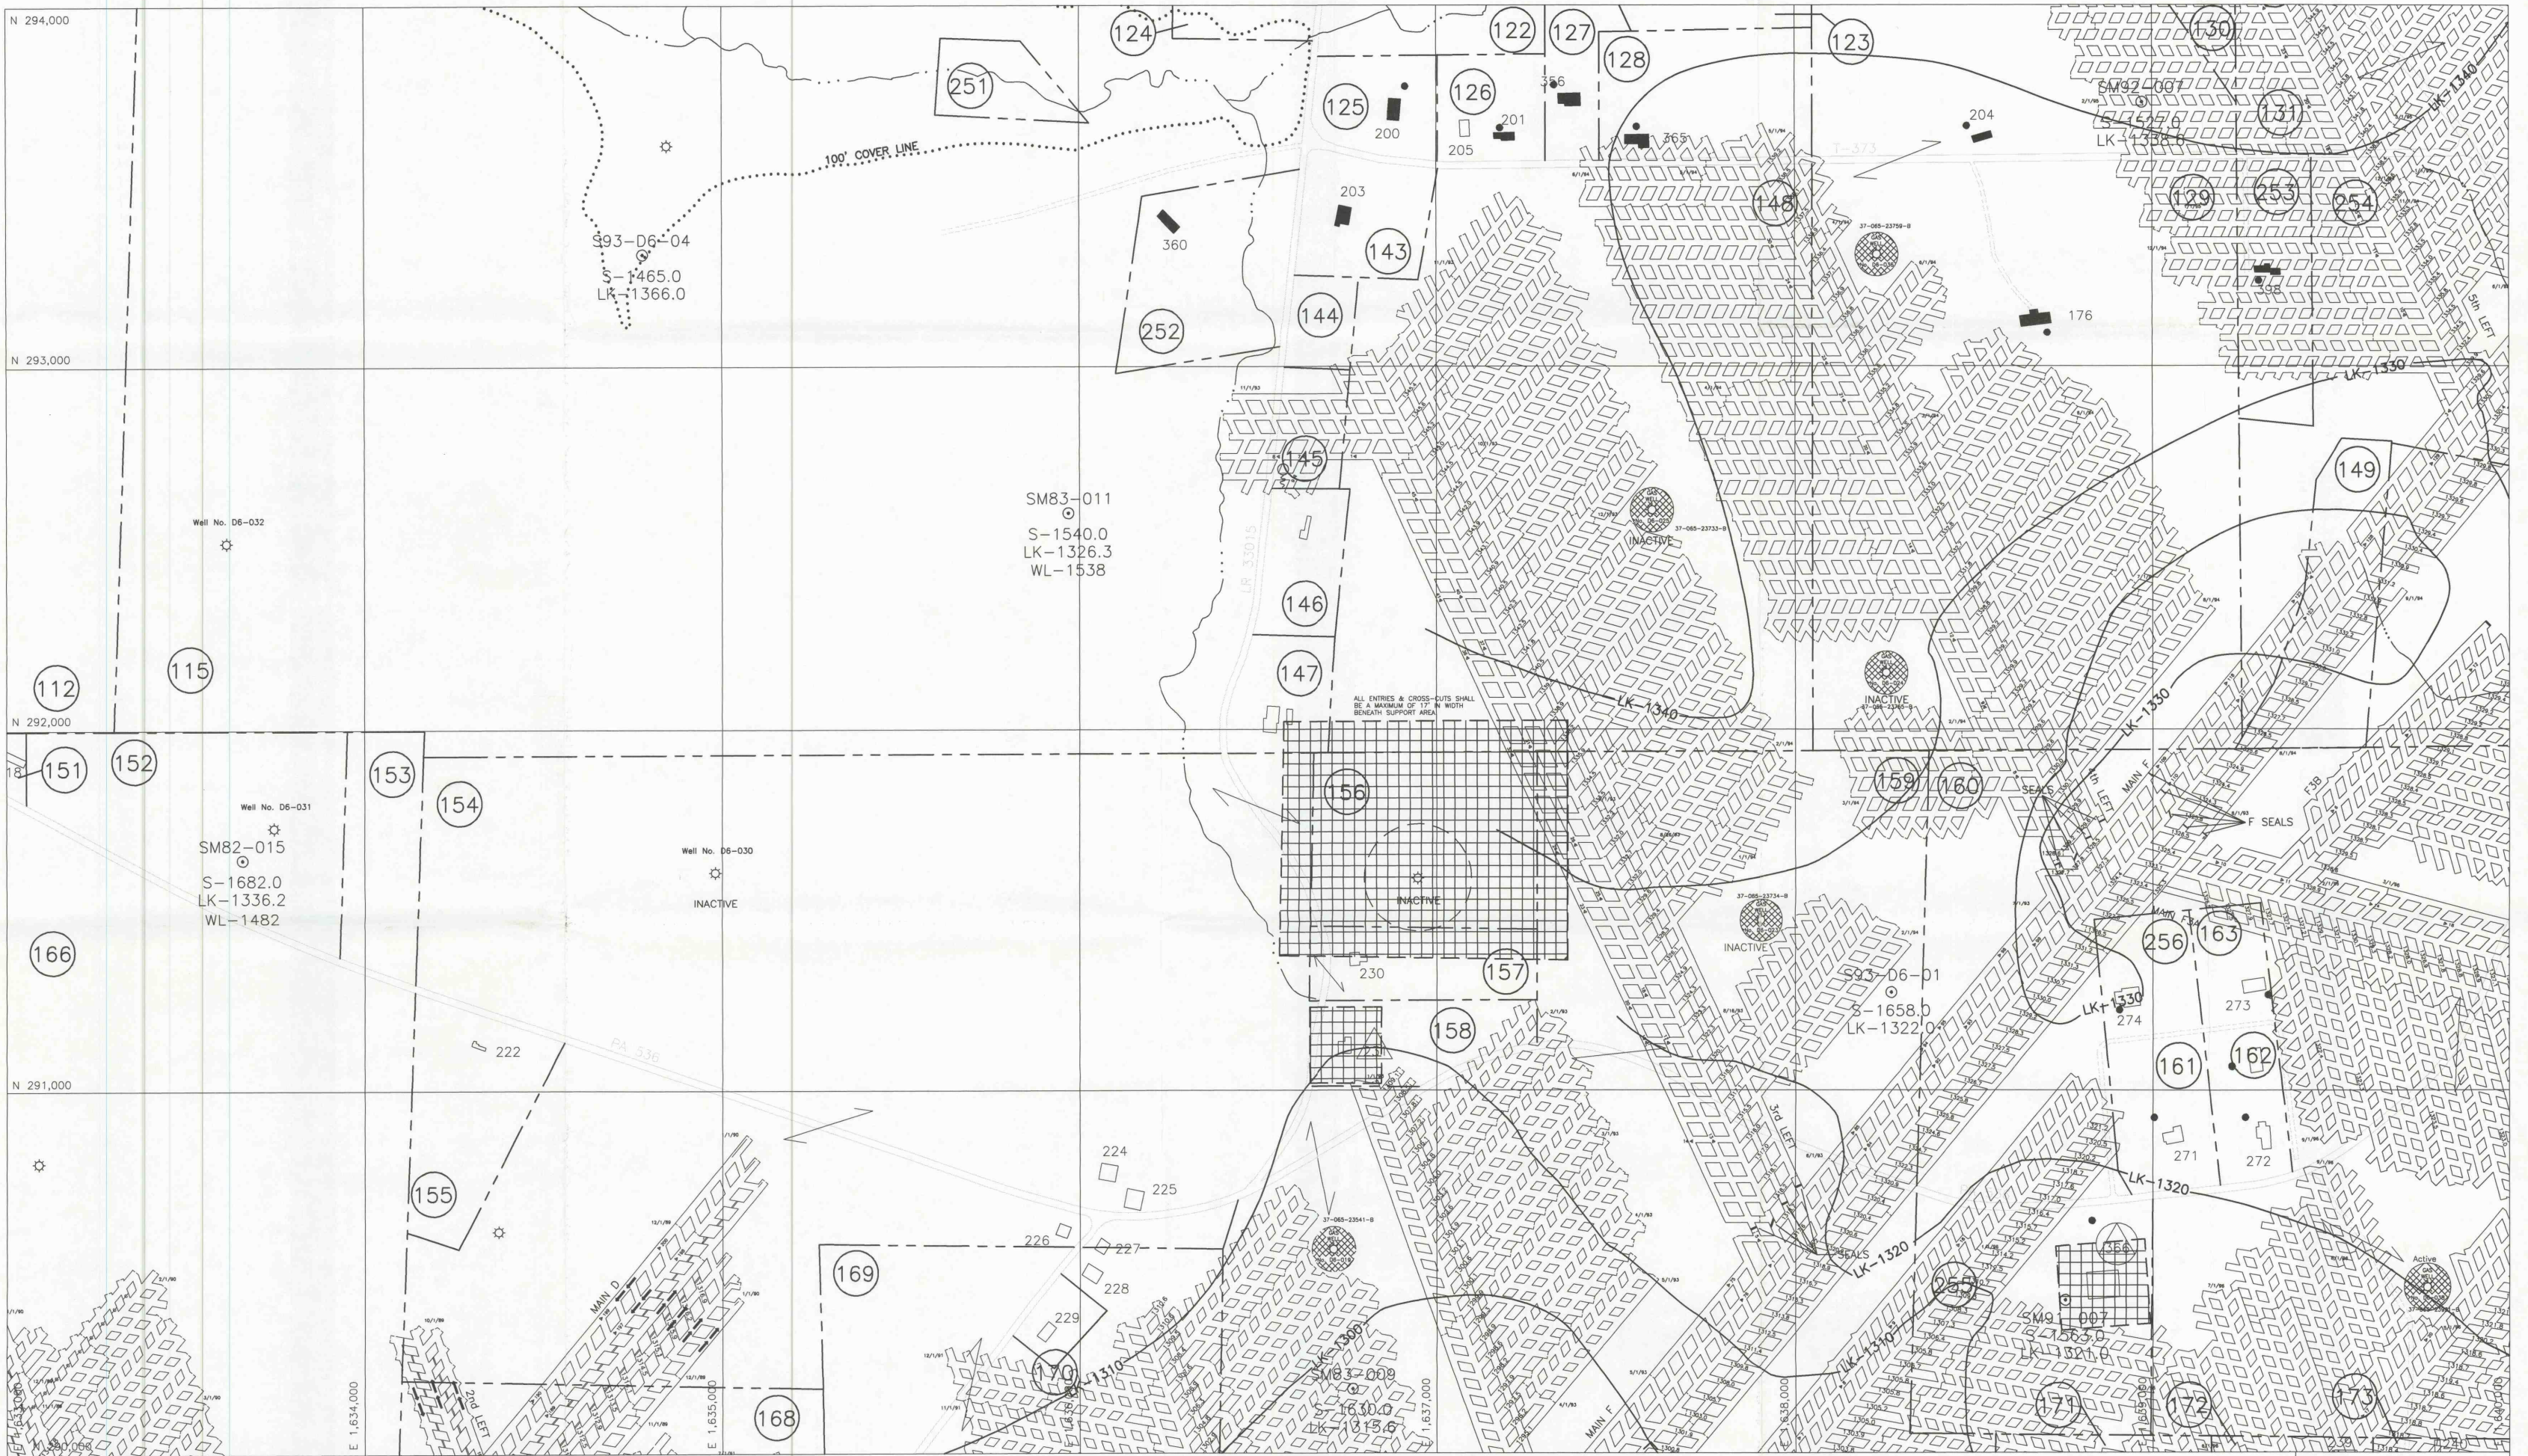

Doverspike Bros. Coal Co.
R.D. #4, Box 271, Punxsutawney, PA 15767
Porter & Perry Twp., Jefferson County

DORA #6 MINE

SCALE: 1" = 200'

SHEET 7 of 24

Final Mine Map

PERMIT AREA PROPERTY LINES PROPERTY OWNERS CONT. PROPERTY OWNERS PRE-66 DWELLINGS DWELLINGS, STRUCTURES PROT. ACT 54 STRUCTURES L.K. COAL CONTOURS L.K. COAL OUTCROP	GAS LINE GAS WELL TELE./ELEC. LINES WATER WELL SPRING DRILL HOLE IMPOUNDMENT CEMETERY MINE OPENINGS, NOT SEALED	MINE OPENINGS, SEALED STREAMS SURVEY STATION SUPPORT AREA(No Second Mining) L.F. DEEP MINE ZONE OF POTENTIAL INFLUENCE GAS WELL BARRIER (No Mining Within Barrier Unless Approved)	INTAKE AIR RETURN AIR BELT LINE STOPPING STOPPING W/ DOOR CHECK CURTAIN REGULATOR DOUBLE DOORS RUN-THROUGH CHECK OVERCAST
---	--	---	---

SURVEY IS CLOSED LOOP; ACCURACY IS 1:10000


INDIVIDUALS RESPONSIBLE FOR INFORMATION:

CHARLES ISHMAN, ENGINEER & CHUCK MARTZ, SUPERINTENDENT

MAP FULFILLS REQUIREMENTS OF 75.372 & 75.1200

NO ADJACENT MINE WORKINGS WITHIN 1000 FEET

NO MINE WORKINGS BELOW MINE PROPERTY

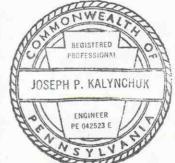

SIGNATURE *Joseph P. Kalynduk*

DATE 4-14-99

FINAL MINE MAP