

Doverspike Bros. Coal Co.
R.D. #4, Box 271, Punxsutawney, PA 15767
Perry Twp., Jefferson Co.; North Mahoning Twp., Indiana Co.

Dora No. 8 Mine


SCALE: 1" = 200' SHEET 1 of 8

MODULE 19.5

--- PERMIT AREA	--- GAS LINE	--- STREAMS
--- PROPERTY LINES	--- GAS WELL	--- SURVEY STATION
--- PROPERTY OWNERS	--- TELE./ELEC. LINES	--- ZONE OF POTENTIAL INFLUENCE
--- CONT. PROPERTY OWNERS	--- WATER WELL	--- CONTEMPLATED MINING 11/1/98 TO 5/1/99
--- DWELLINGS, STRUCTURES	--- SPRING	--- 6 MONTH PROJECTIONS
--- PROTECTED ACT 54 STRUCTURE	--- DRILL HOLE	--- GAS WELL BARRIER (No Mining Within Barrier Unless Approved)
--- LK-1480 L.K. COAL CONTOURS	--- IMPOUNDMENT	--- NO MINING AREA
--- LK/LK L.K. COAL OUTCROP	--- MINE OPENINGS, NOT SEALED	
	--- MINE OPENINGS, SEALED	

Final Mining by:

Doverspike Bros. Coal Co.

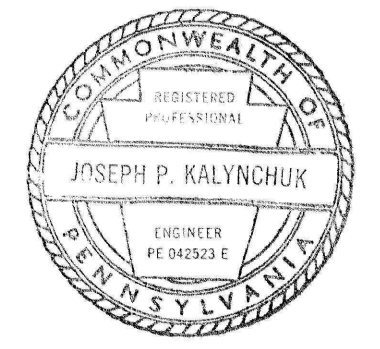

SIGNATURE: *Joseph P. Kalynchuk*
DATE: 4-15-99