


Youghiogheny River

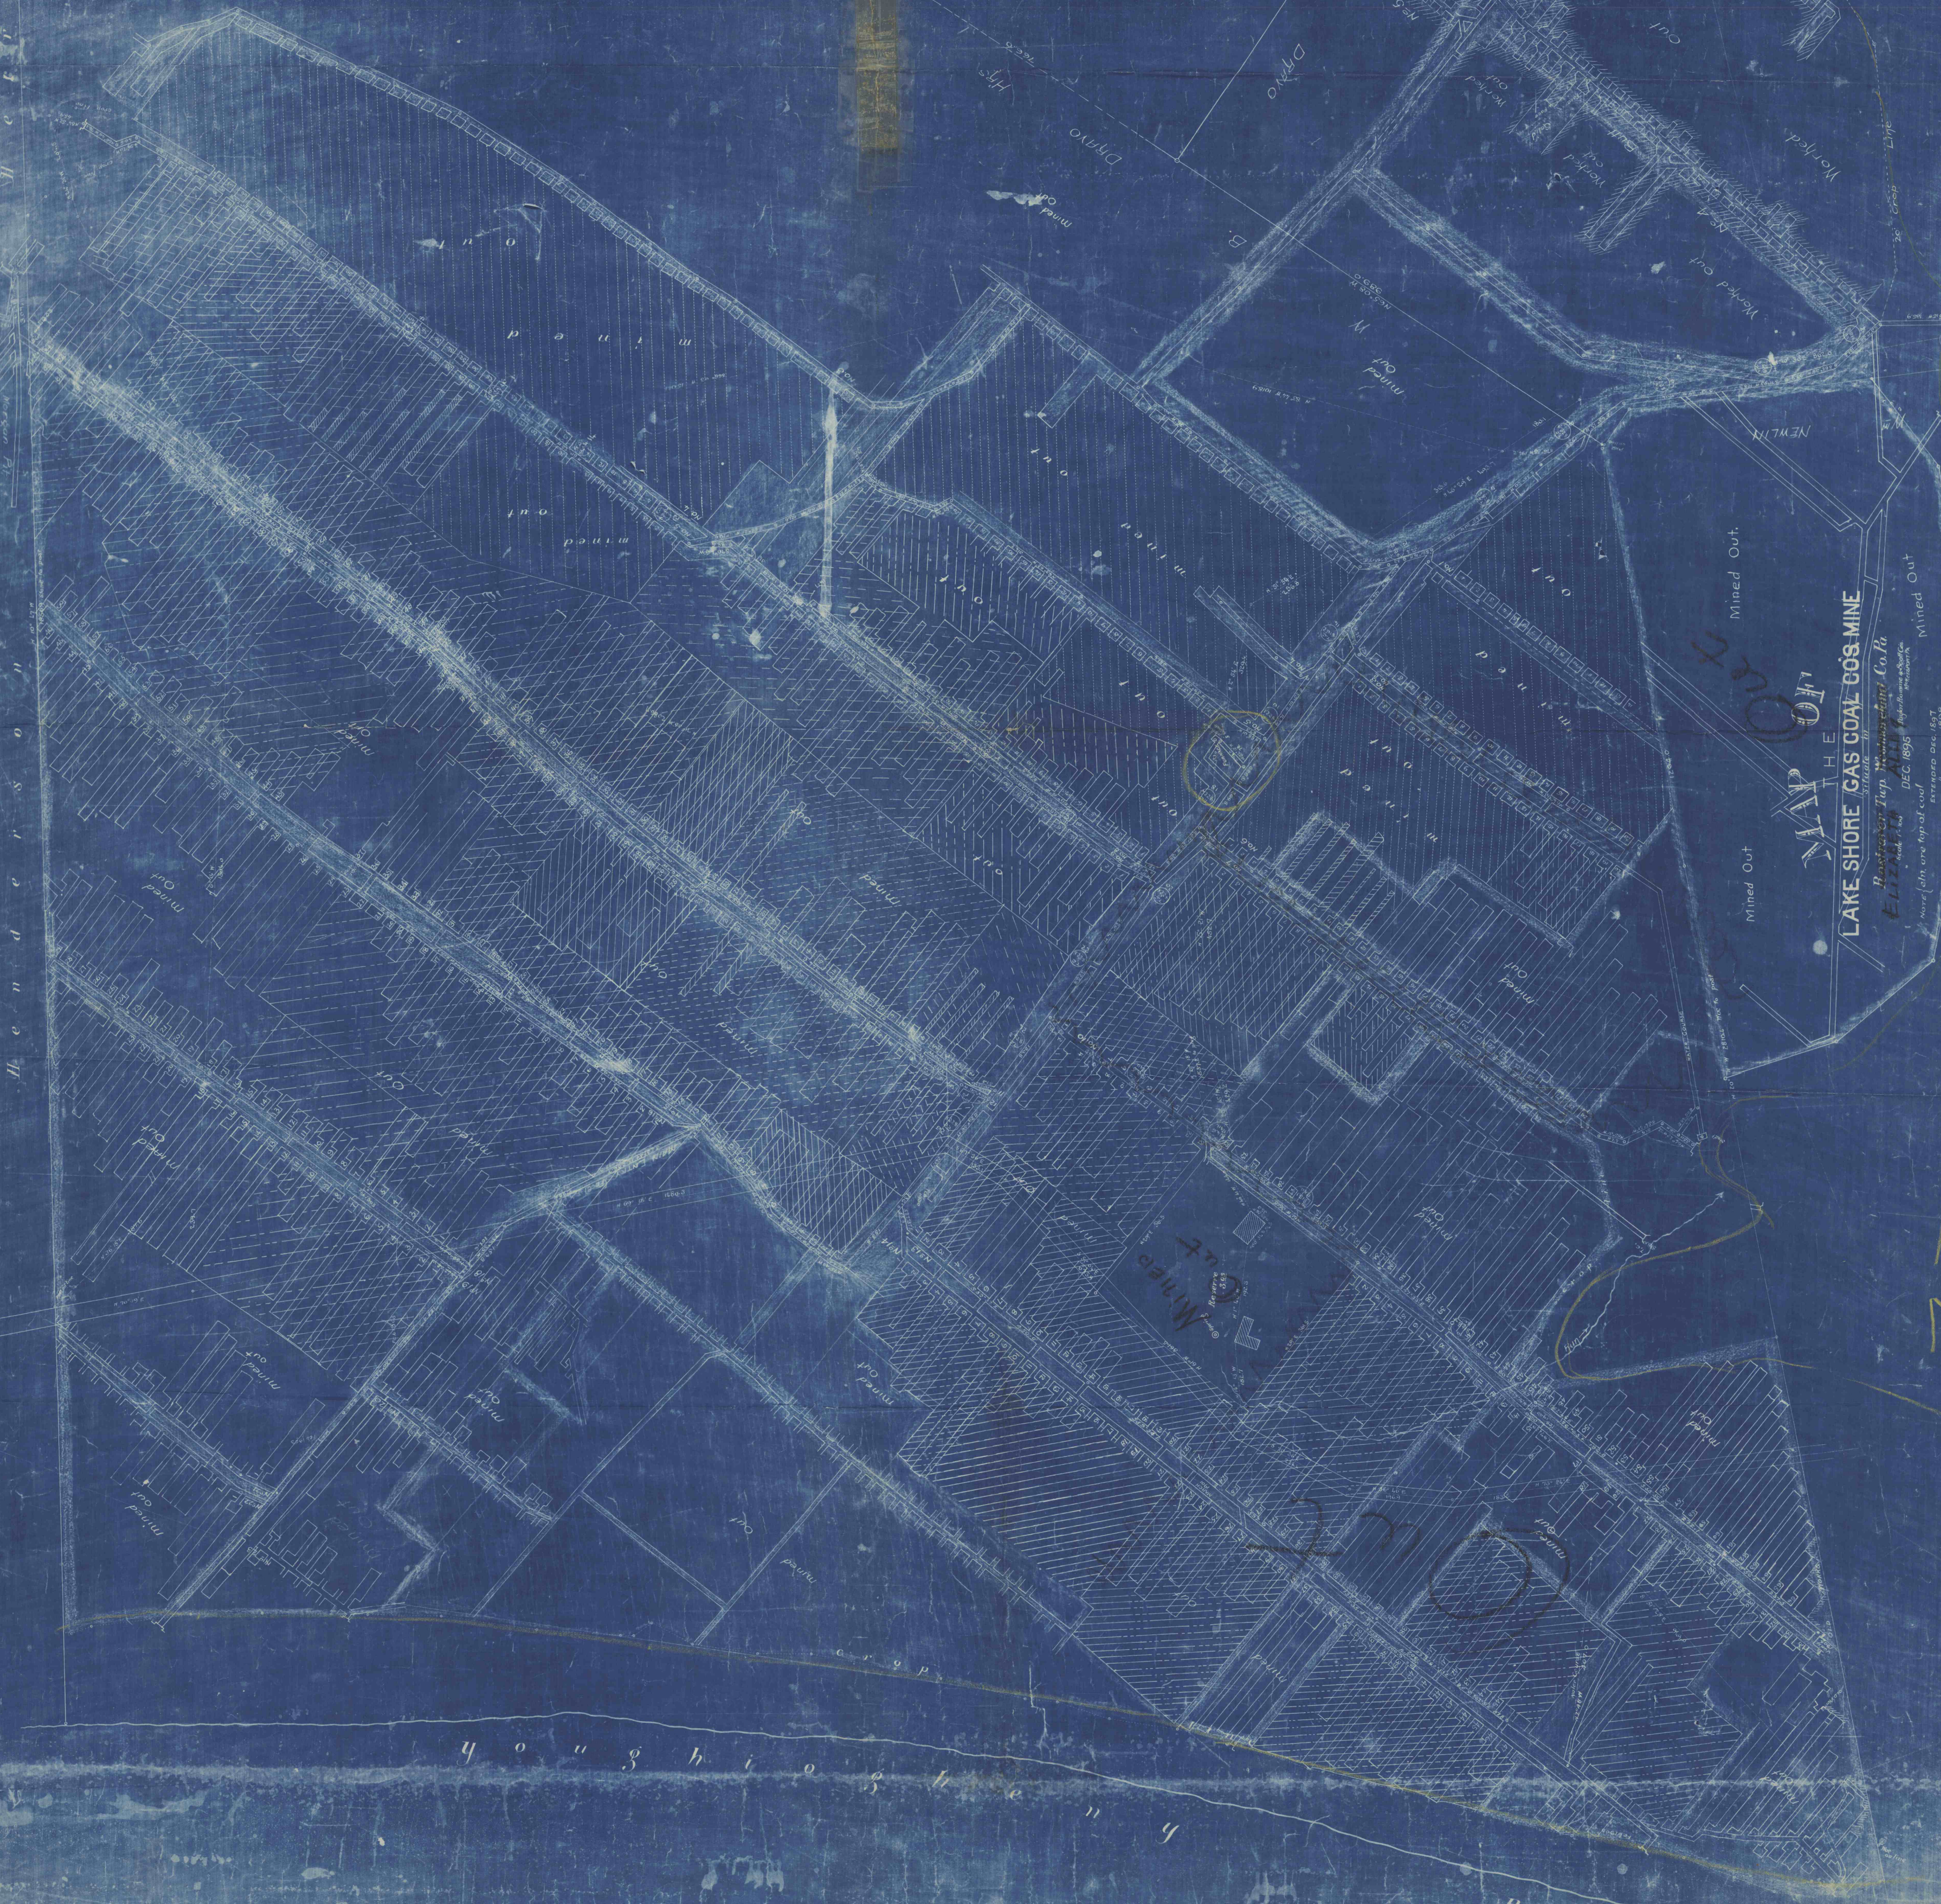

LAKE SHORE GAS COAL CO'S MINE

Map of the Lake Shore Gas Coal Co's Mine, showing the mine workings and the mine's location relative to the Youghiogheny River.

