
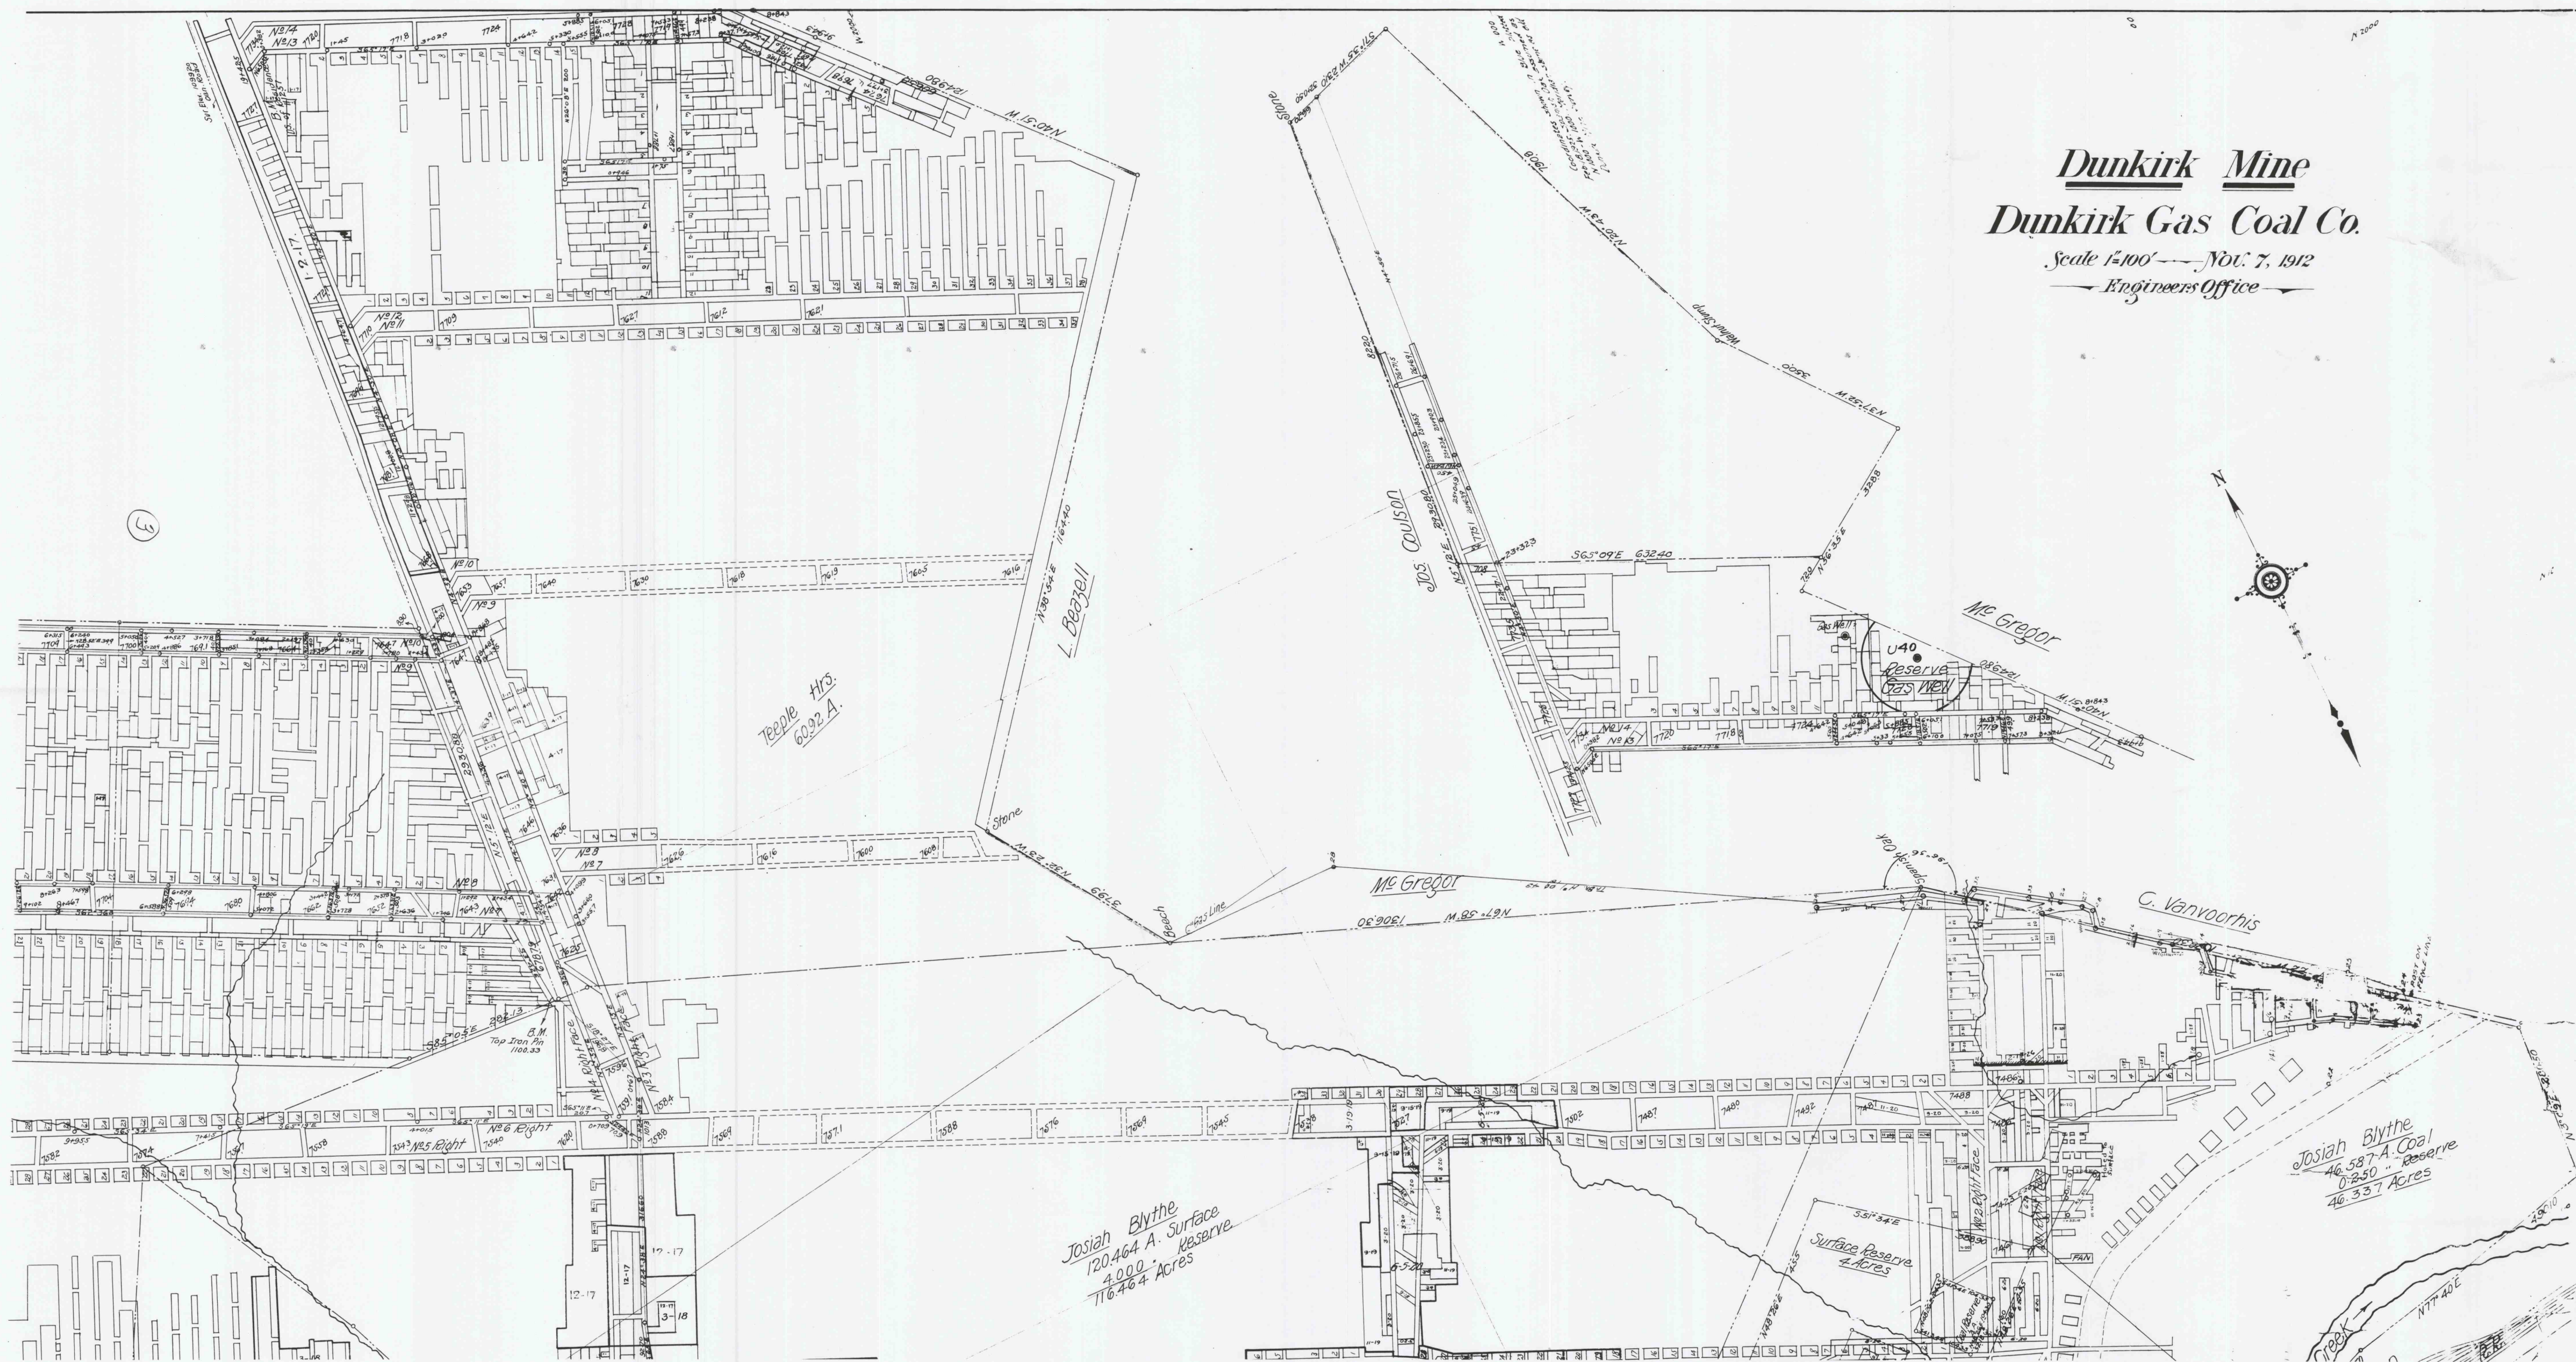


Dunkirk Mine
Dunkirk Gas Coal Co.
Scale 1"=100' Nov. 7, 1912
Engineers Office

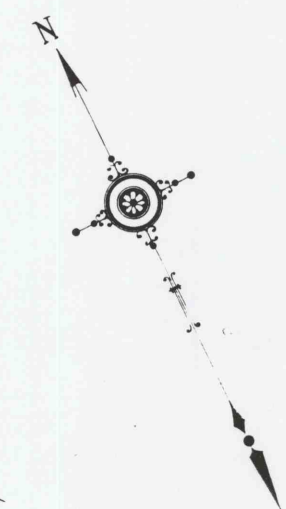

Tepple Hrs.
60.92 A.

Josiah Blythe
120.464 A. Surface
4.000 Reserve
116.464 Acres

Josiah Blythe
46.587 A. Coal
0.550 Reserve
46.337 Acres

Surface Reserve
4 Acres