


MAP SHOWING
 STRIP MINING OPERATION
 BY THE
 DUNLO COAL CO
 PAINT TWP SOMERSET CO PA
 SCALE 1"=100' NOV 1943

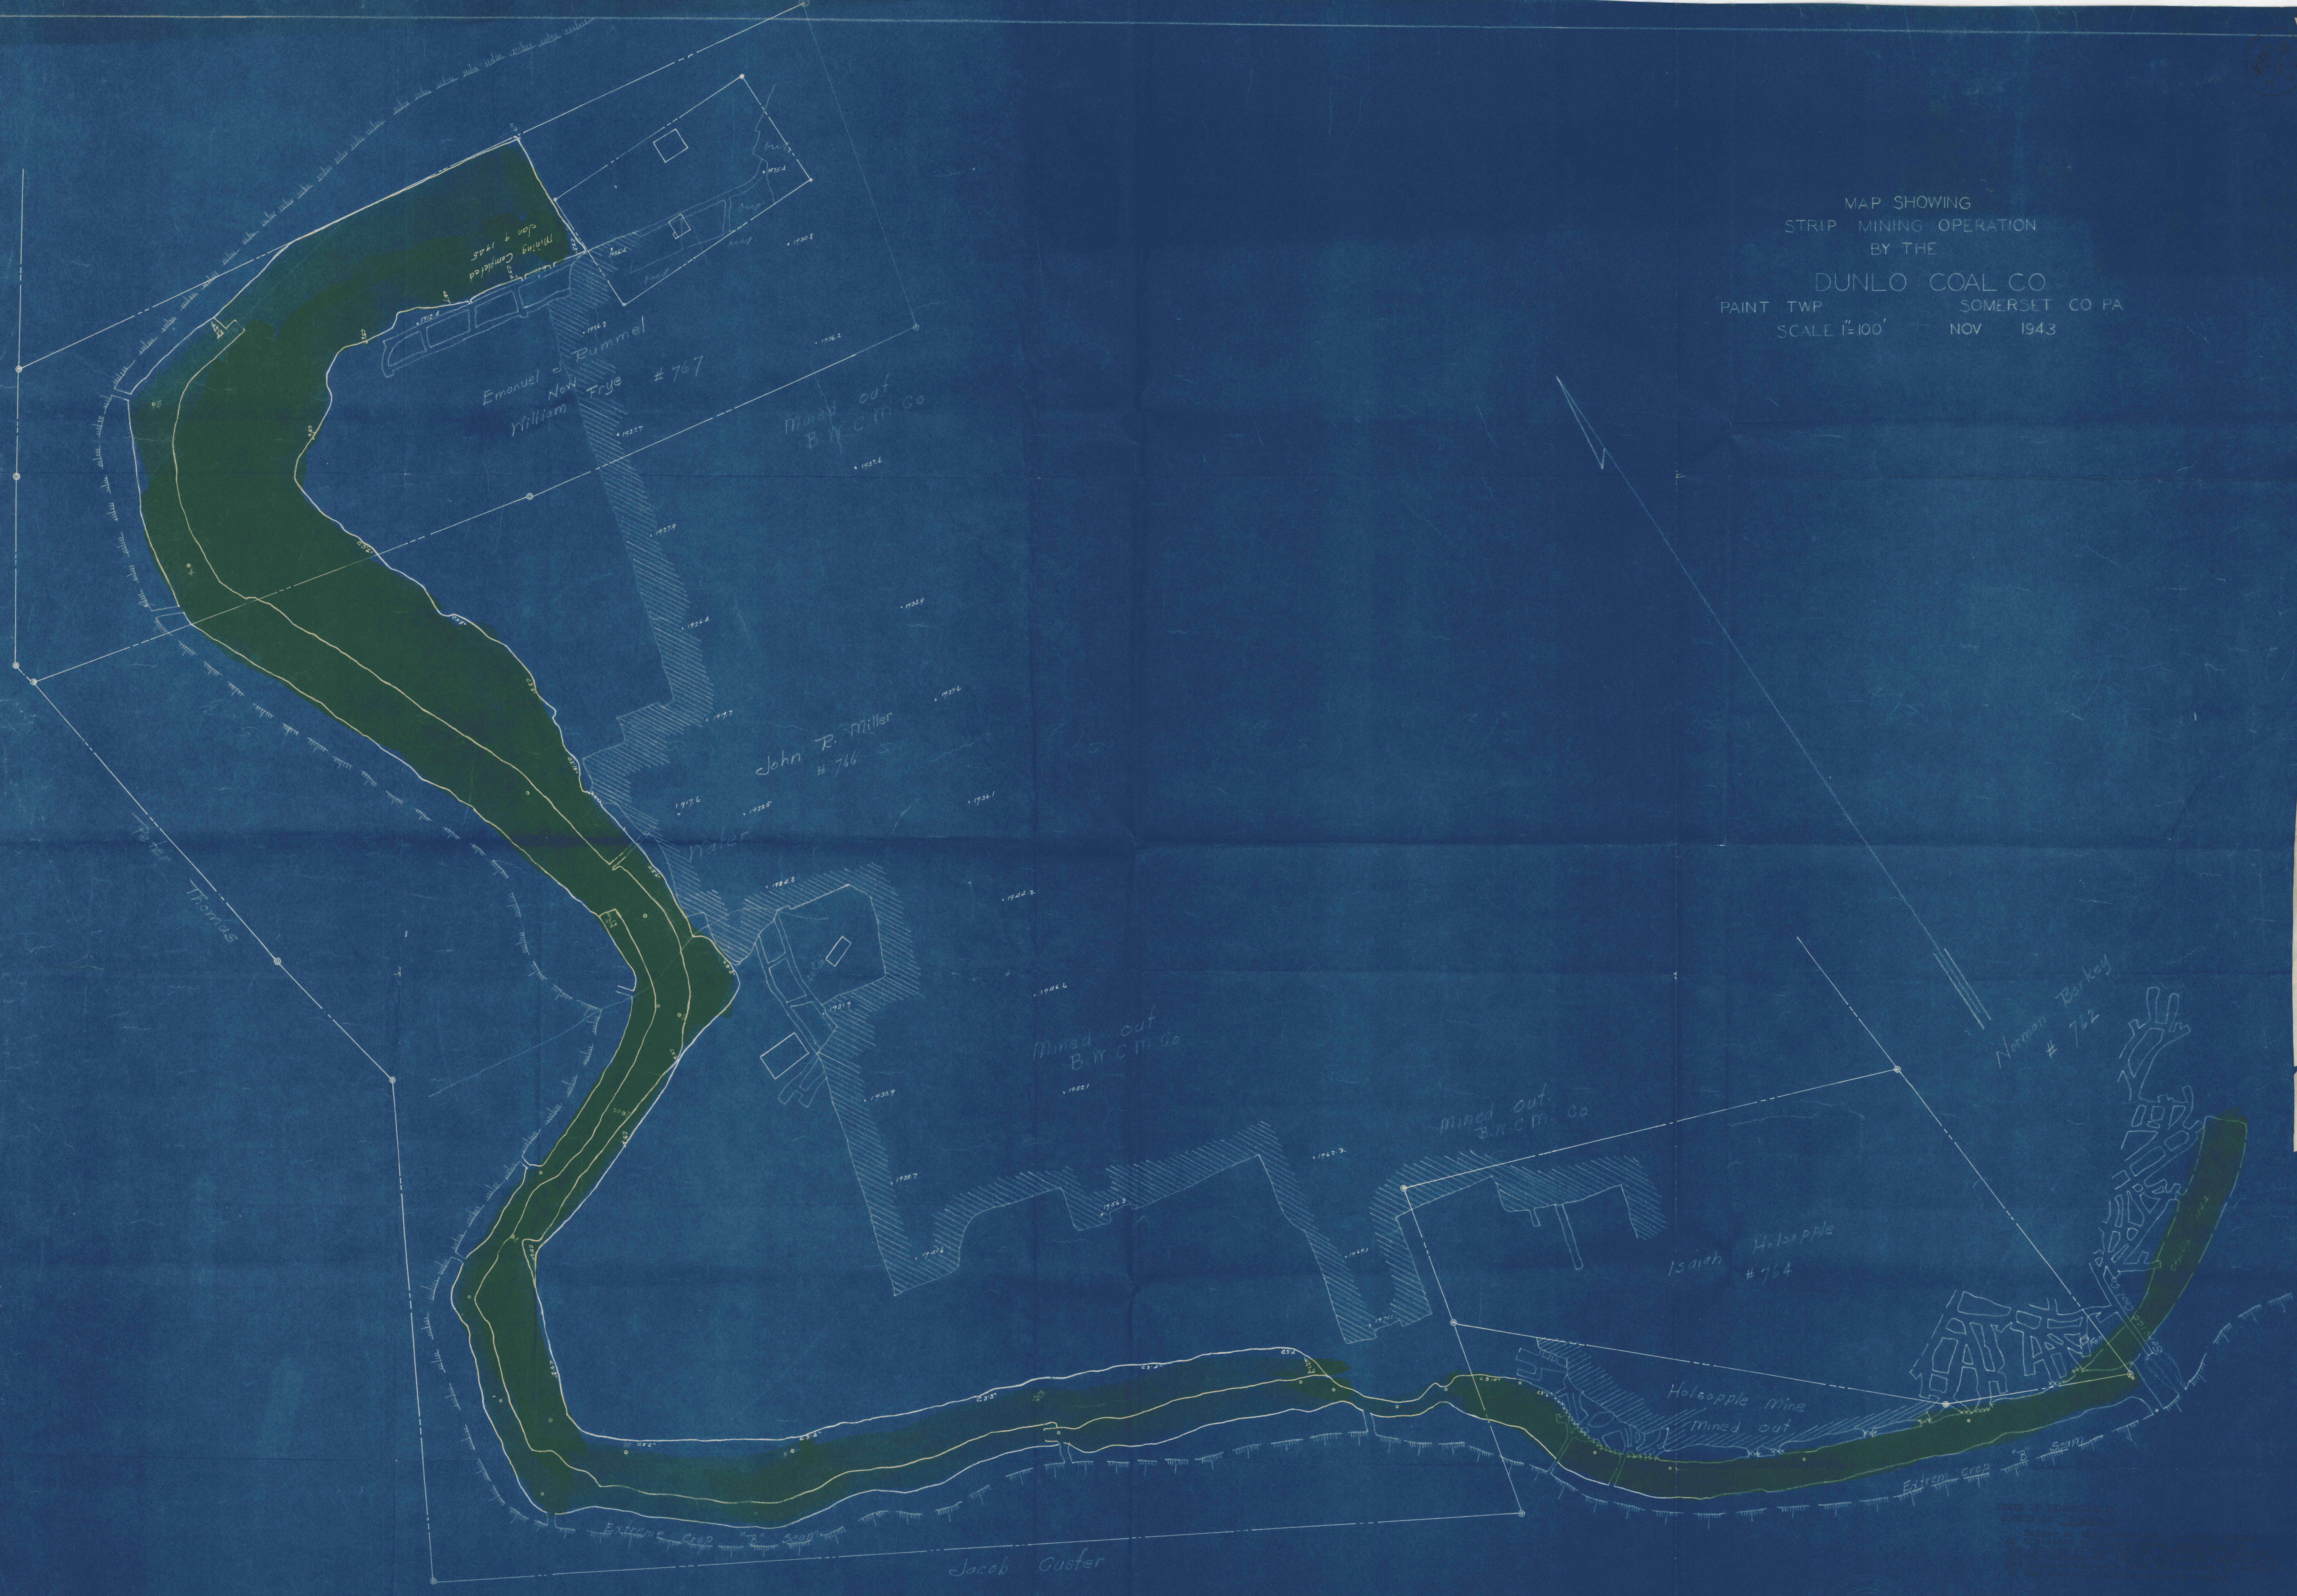


