

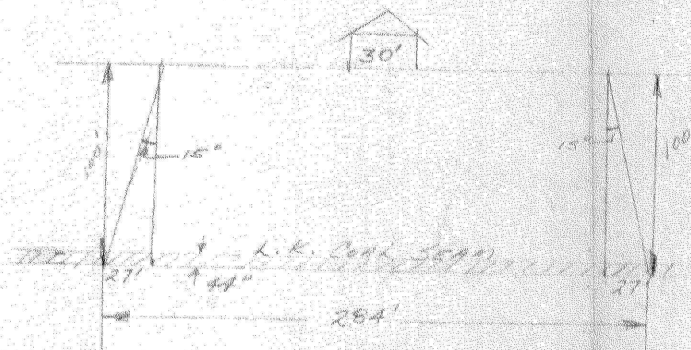


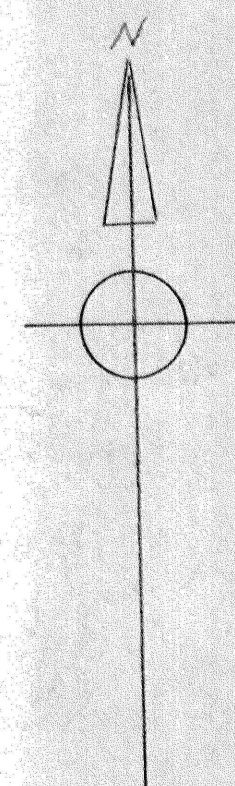

SUPPORT DETAIL VERNON WOLFE HOUSE

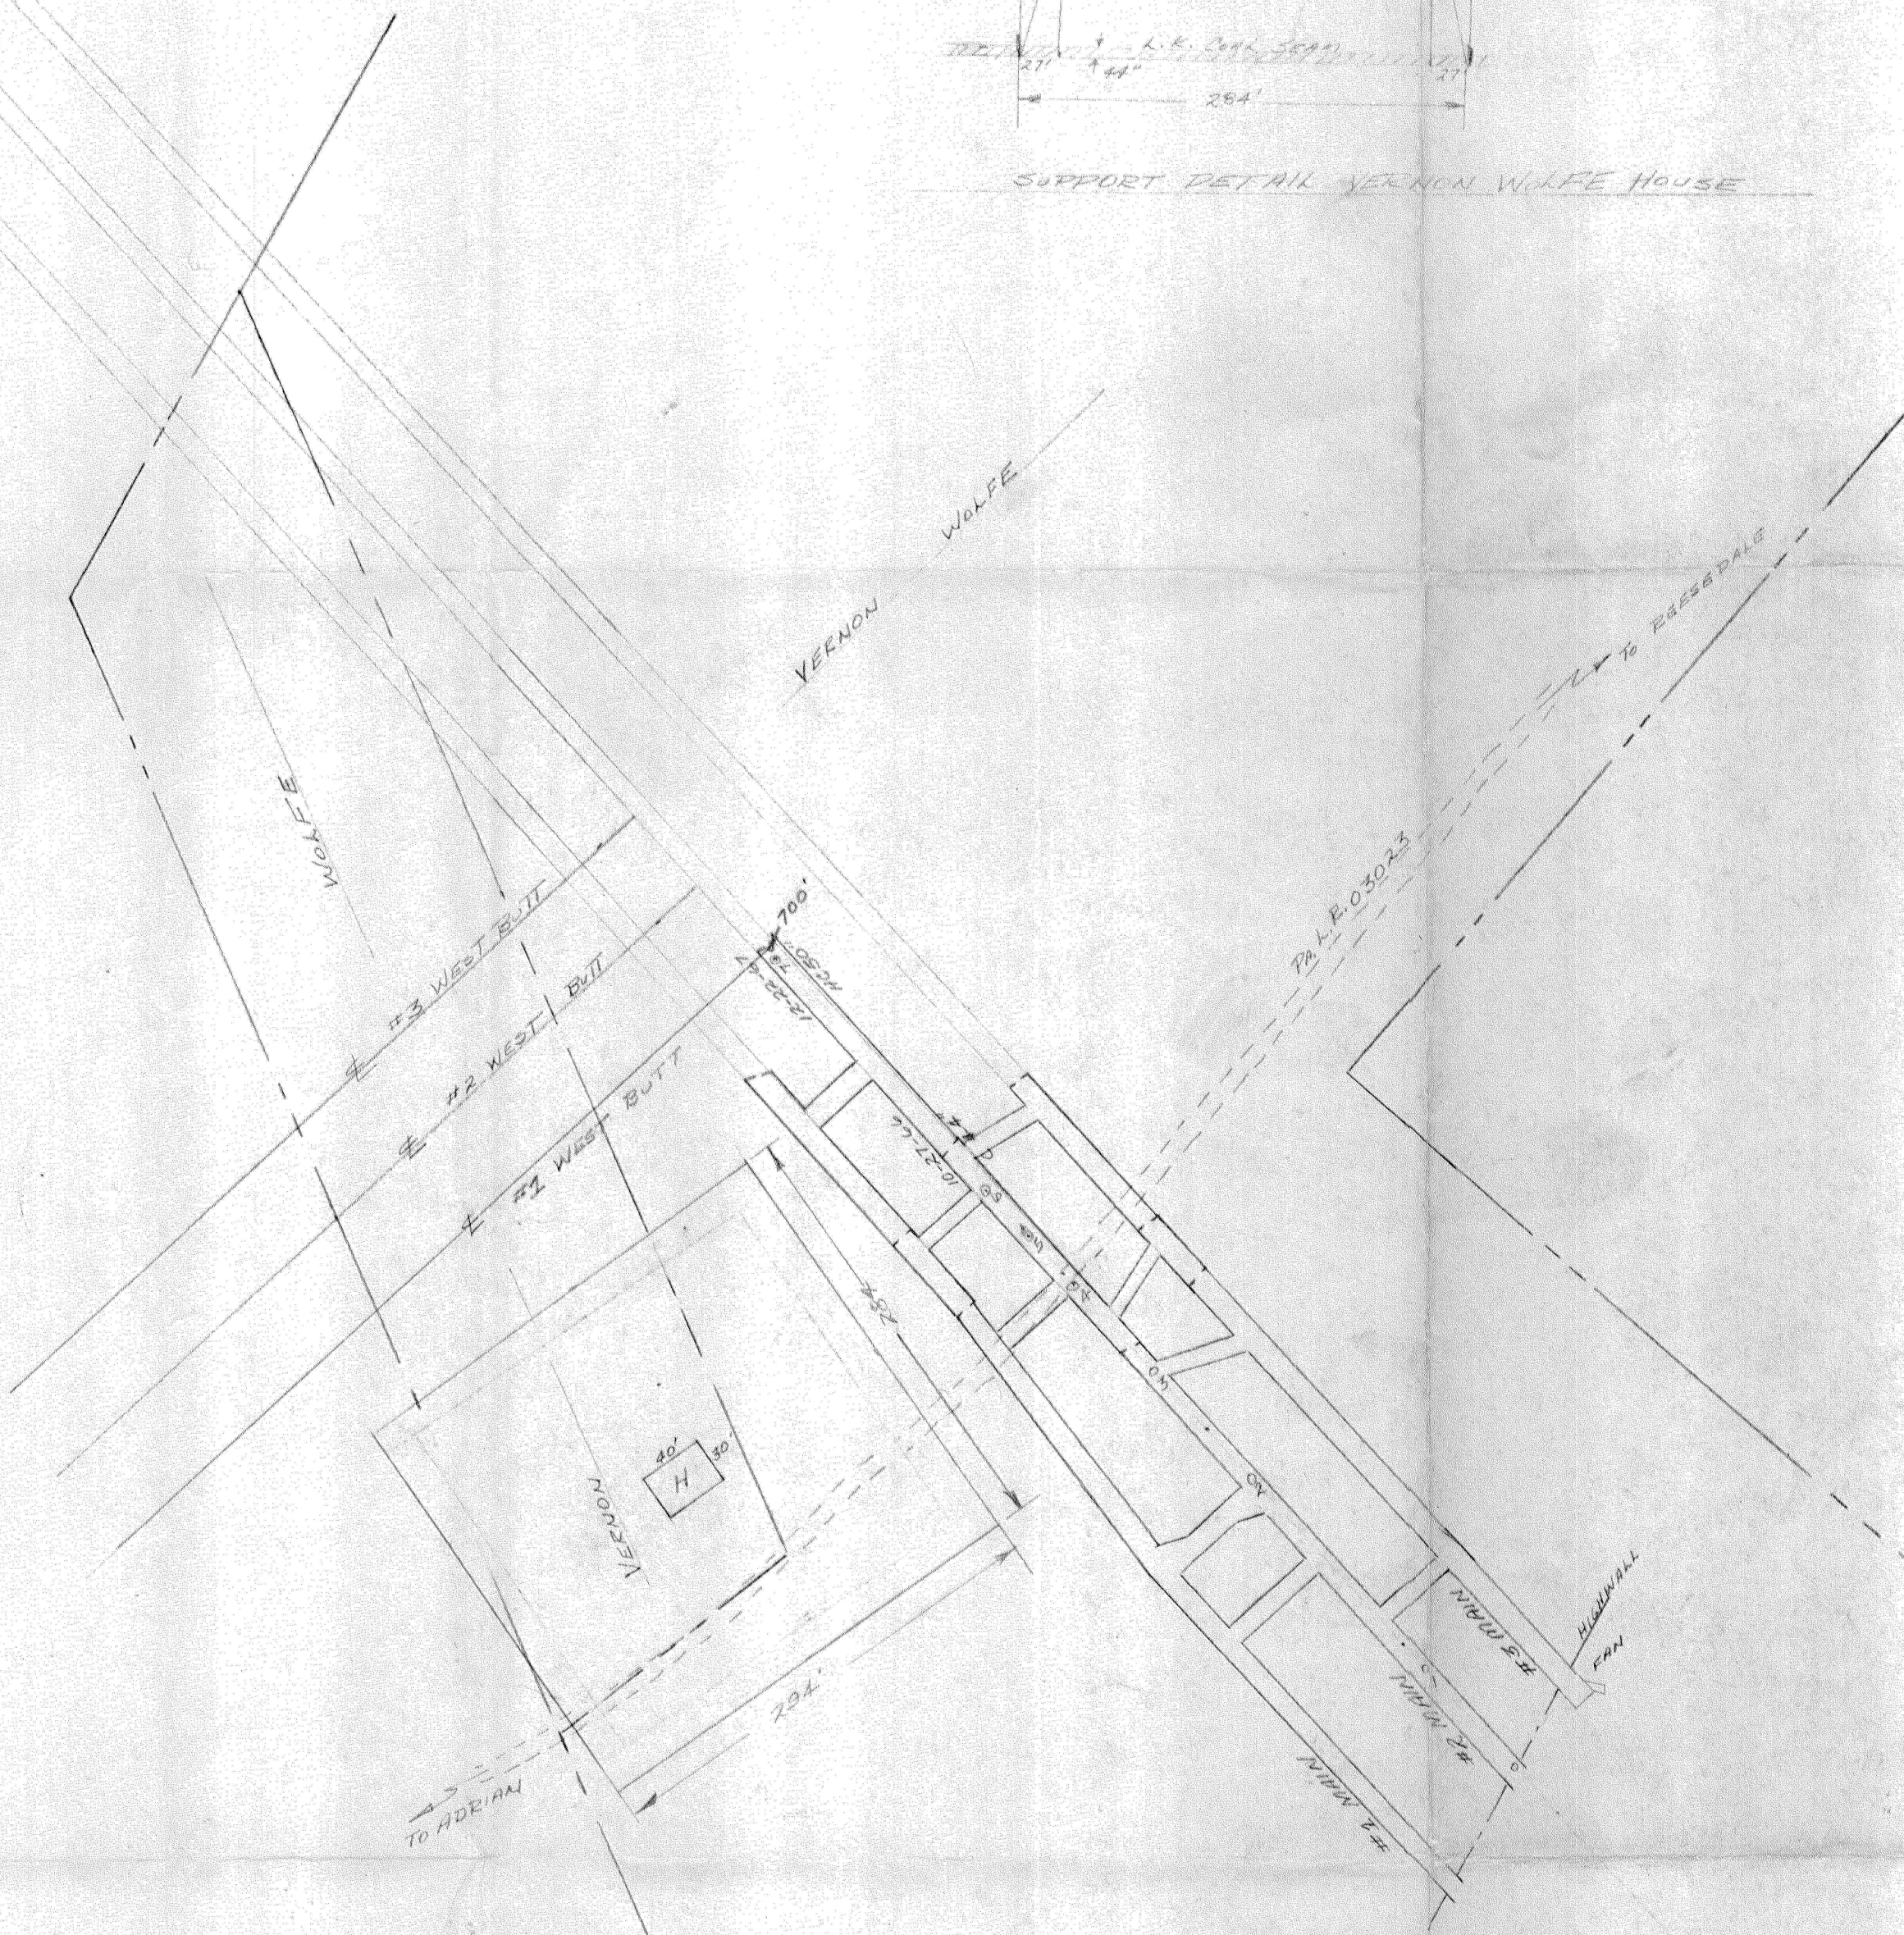

MINE MAP FOR DURIEZ COAL CO., INC.
 WASHINGTON TWP., ARMSTRONG CO., PENNA.
 SEPTEMBER 1966 SCALE: 1" = 100'

POWER SUPPLY CO.

J. M. [Signature]

#852
 7-12-9
 C.C.