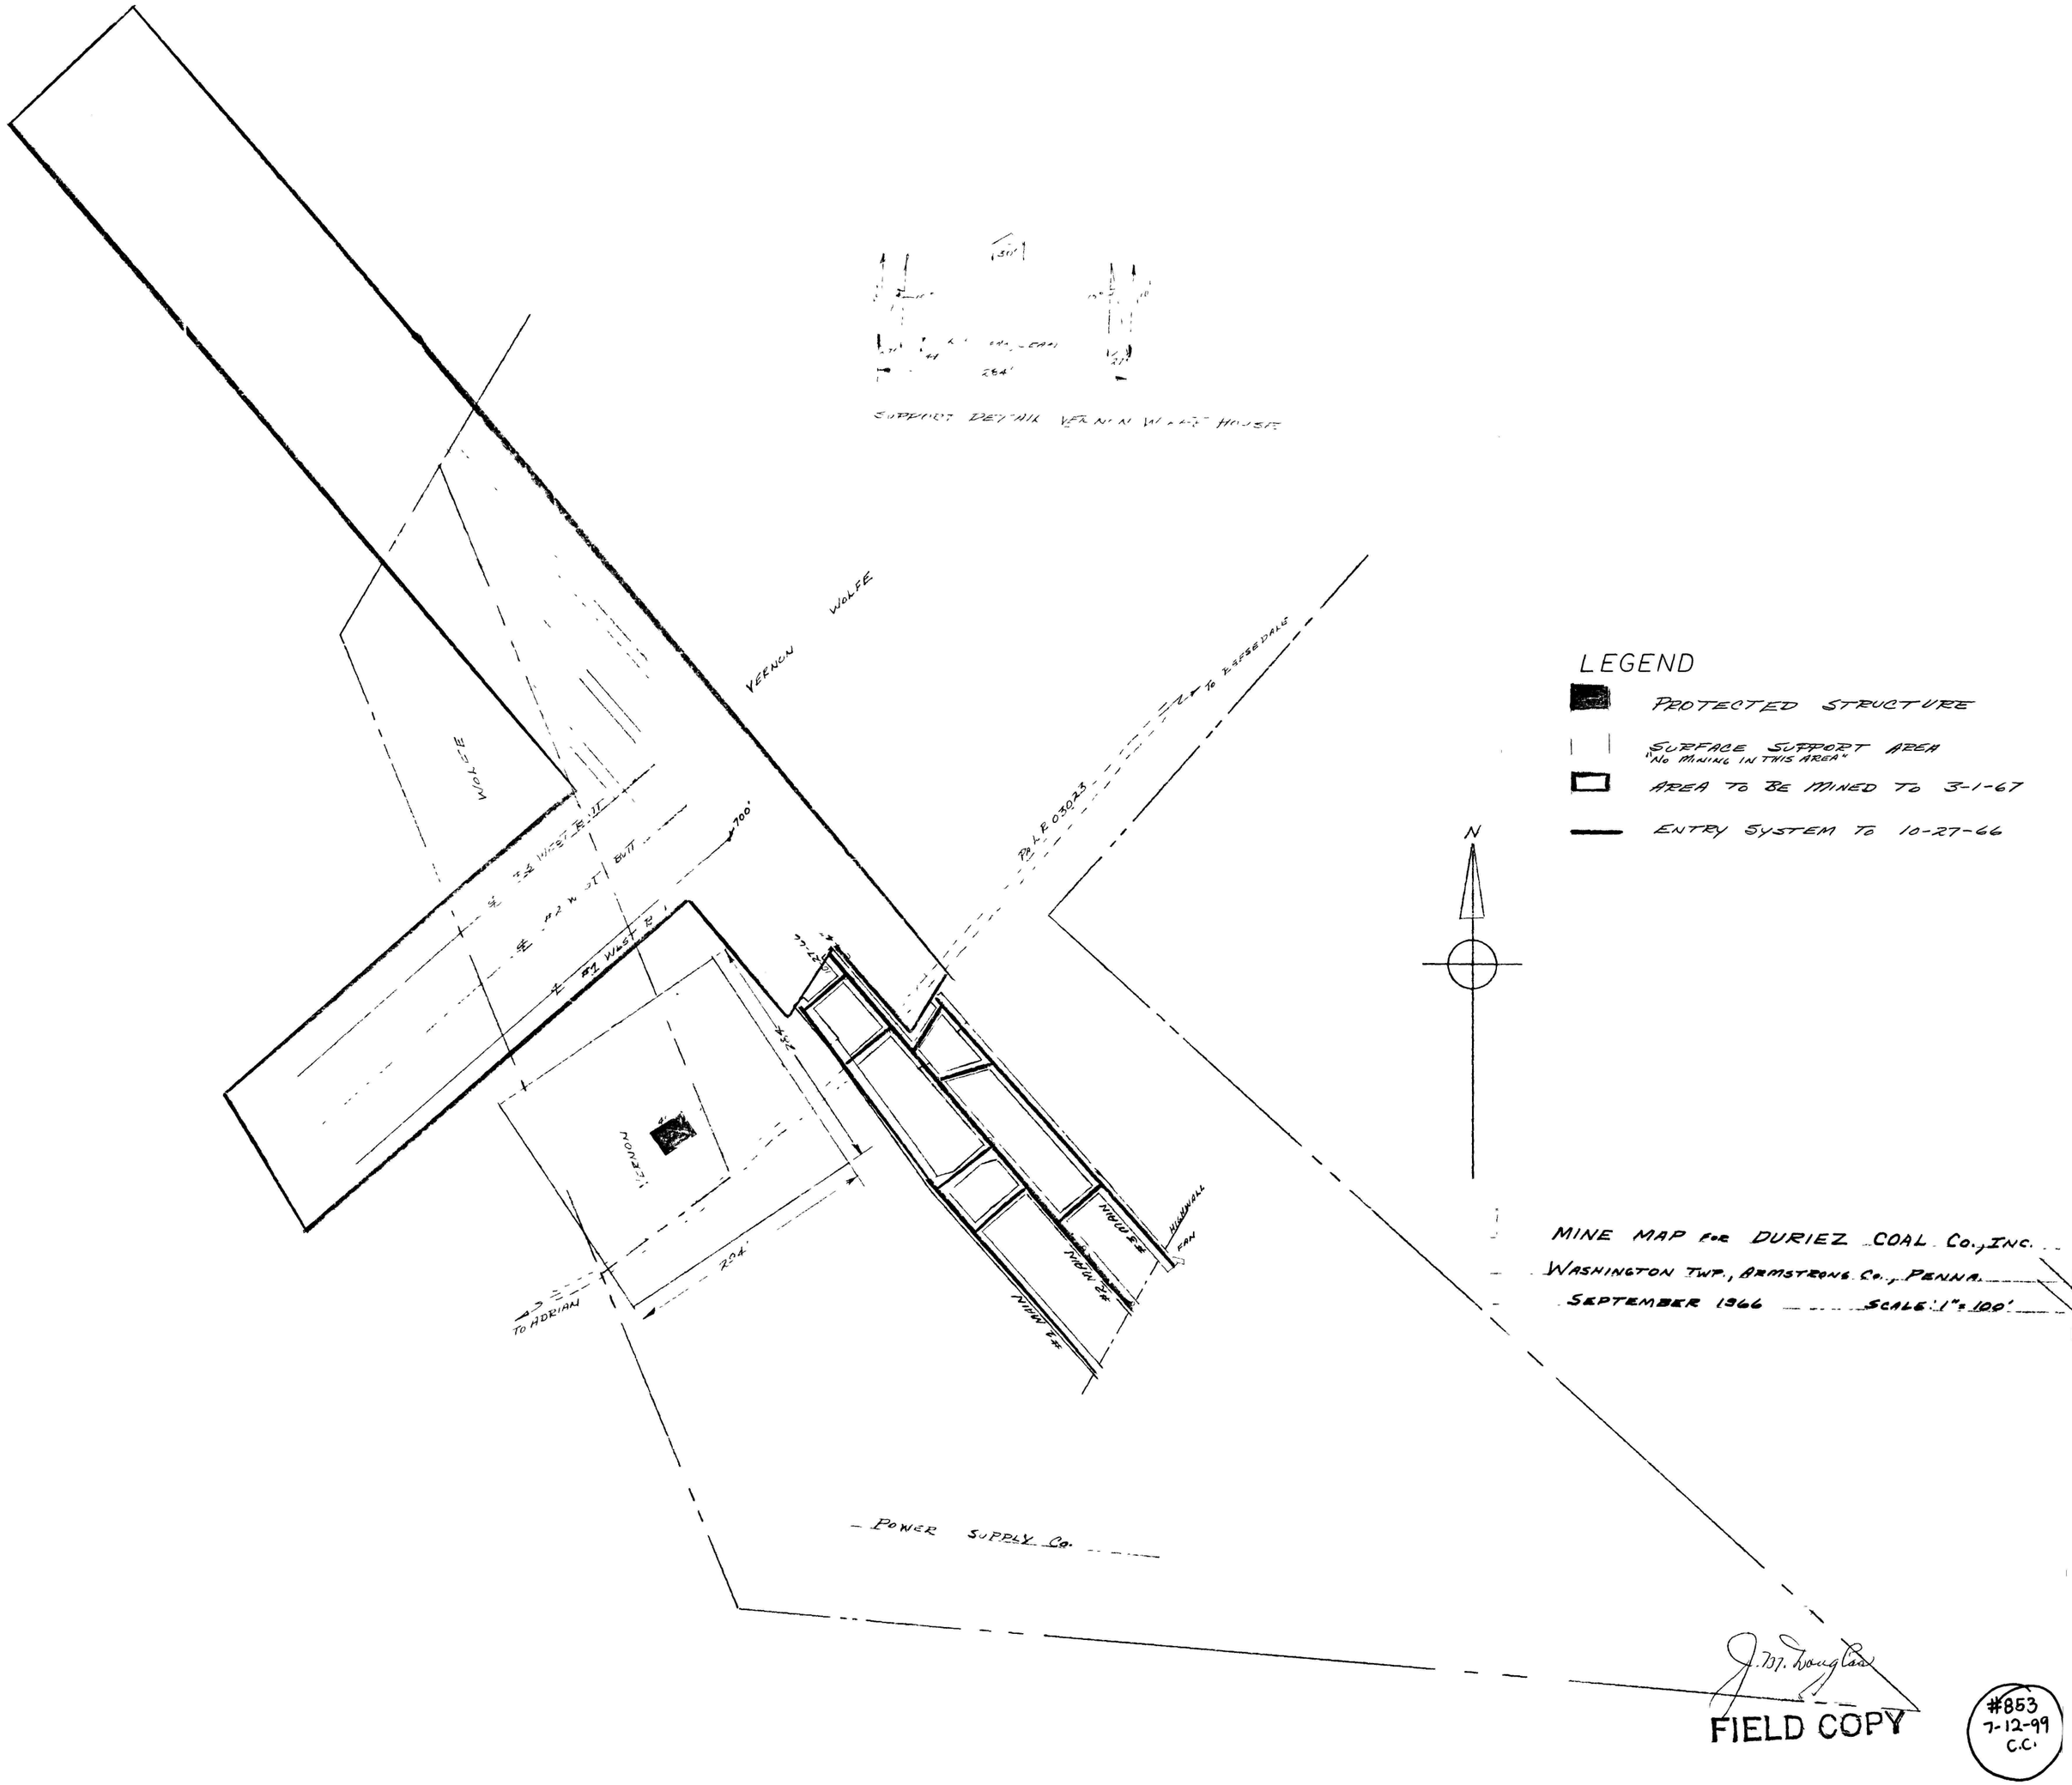
SUPPORT DETAIL VERNON WOLFE HOUSE
VERNON WOLFE
WOLFE
700'
TO ADRIAN
POWER SUPPLY Co.
TO BRESSEDALE
N
LEGEND
PROTECTED STRUCTURE
SURFACE SUPPORT AREA
"NO MINING IN THIS AREA"
AREA TO BE MINED TO 3-1-67
ENTRY SYSTEM TO 10-27-66
MINE MAP FOR DURIEZ COAL Co., INC.
WASHINGTON TWP., ARMSTRONG Co., PENNA.
SEPTEMBER 1966
SCALE: 1" = 100'
FIELD COPY

#853
7-12-99
C.C.