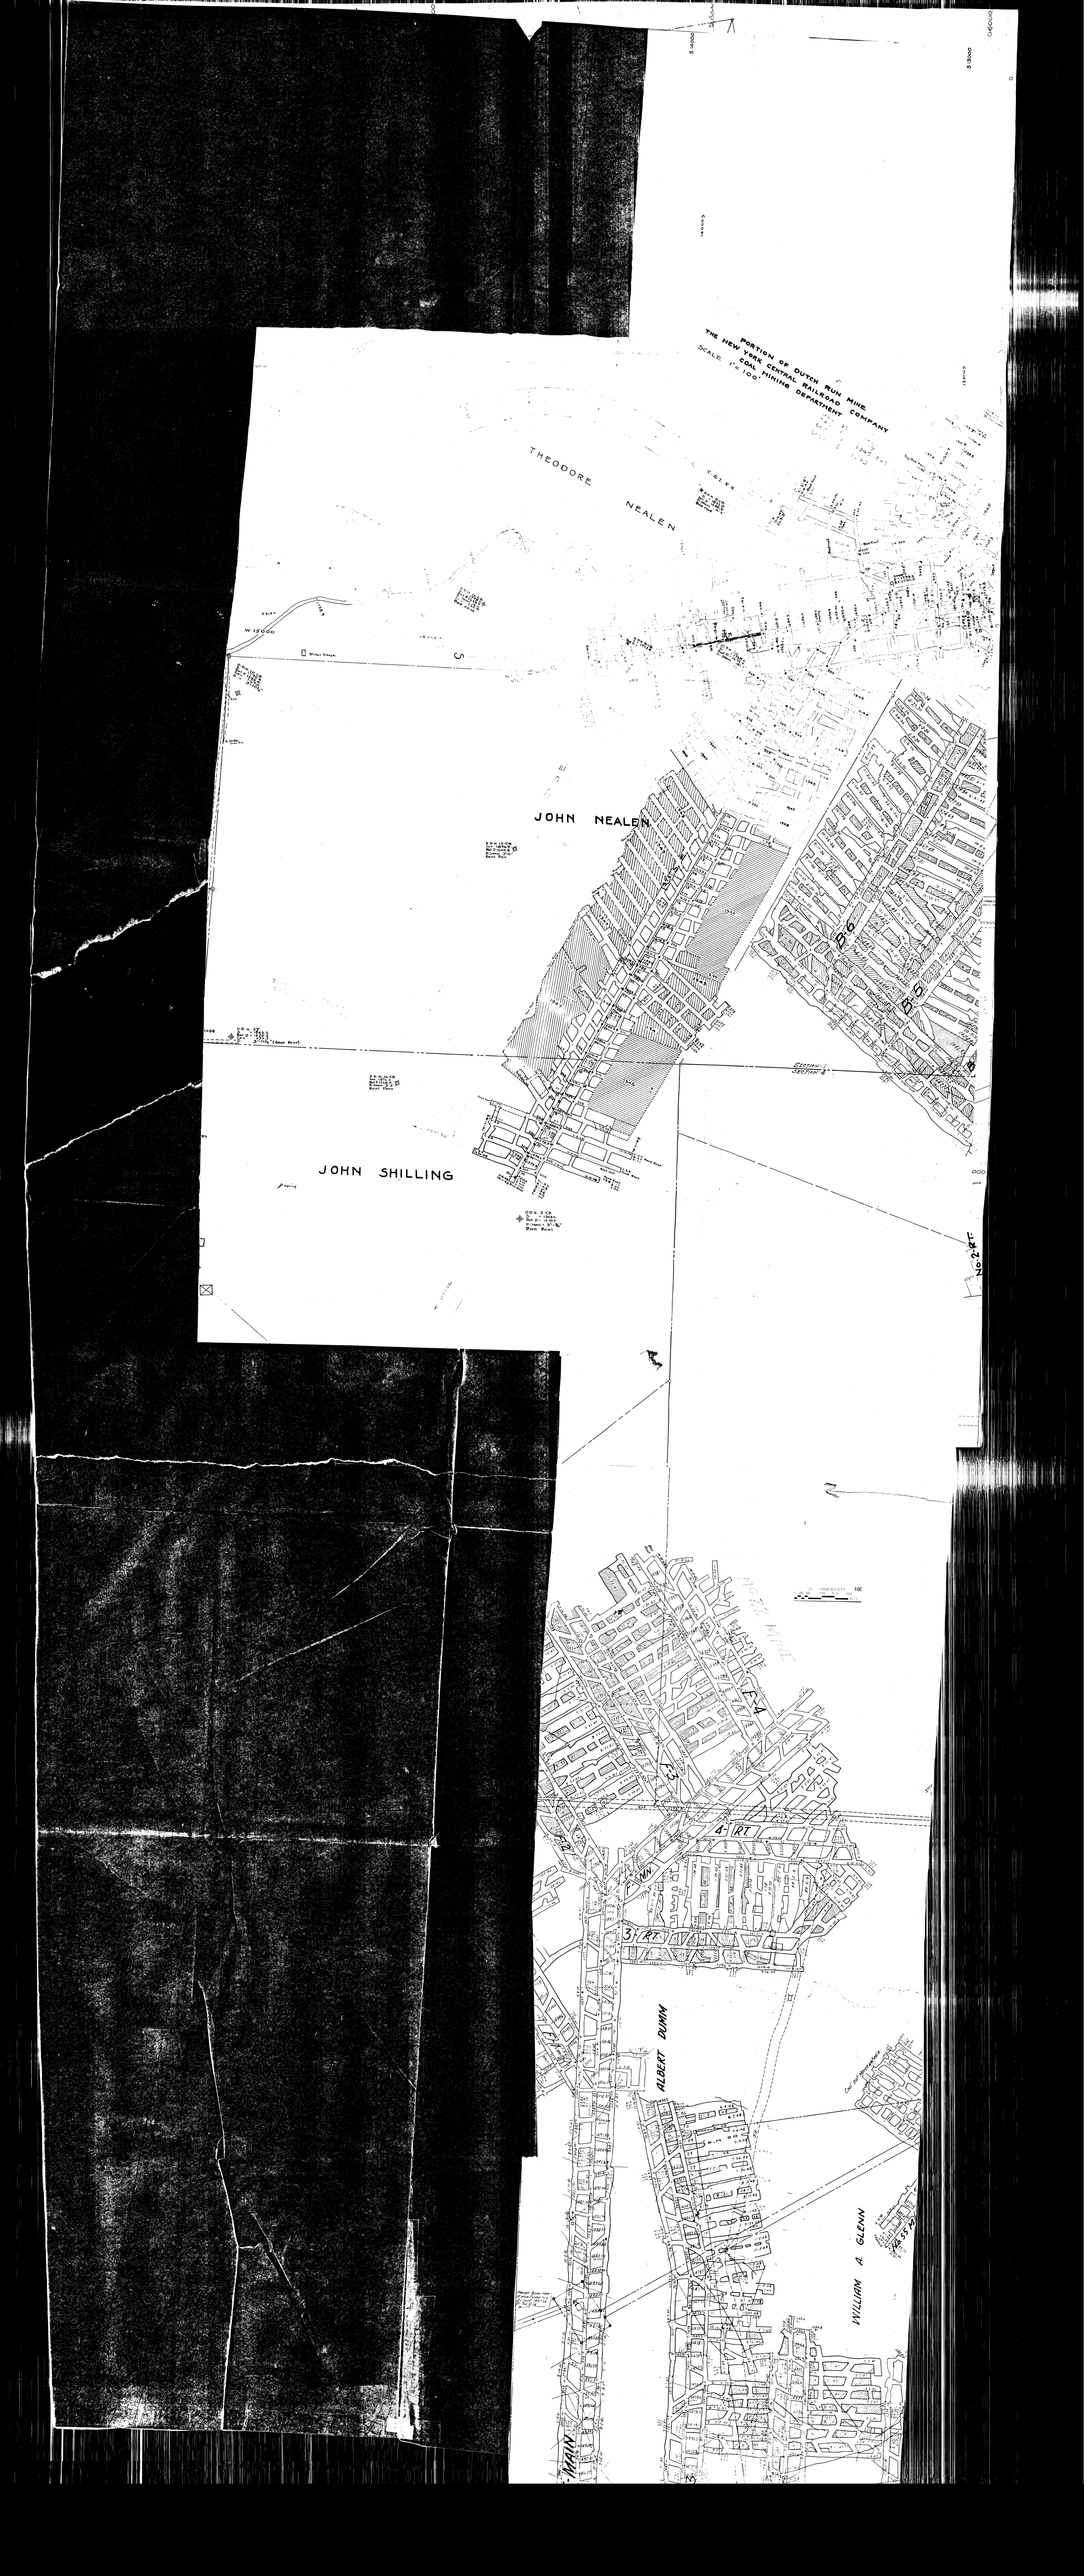

PORTION OF DUTCH RUN MINE
THE NEW YORK CENTRAL RAILROAD COMPANY
COAL MINING DEPARTMENT
SCALE 1"=100'
THEODORE NEALEN
JOHN NEALEN
JOHN SHILLING
ALBERT DUNN
WILLIAM A. GLENN
MAIN
4 RT.
3 RT.
LT 4
LT 3
LT 2
B 6
B 5
NO 2 RT