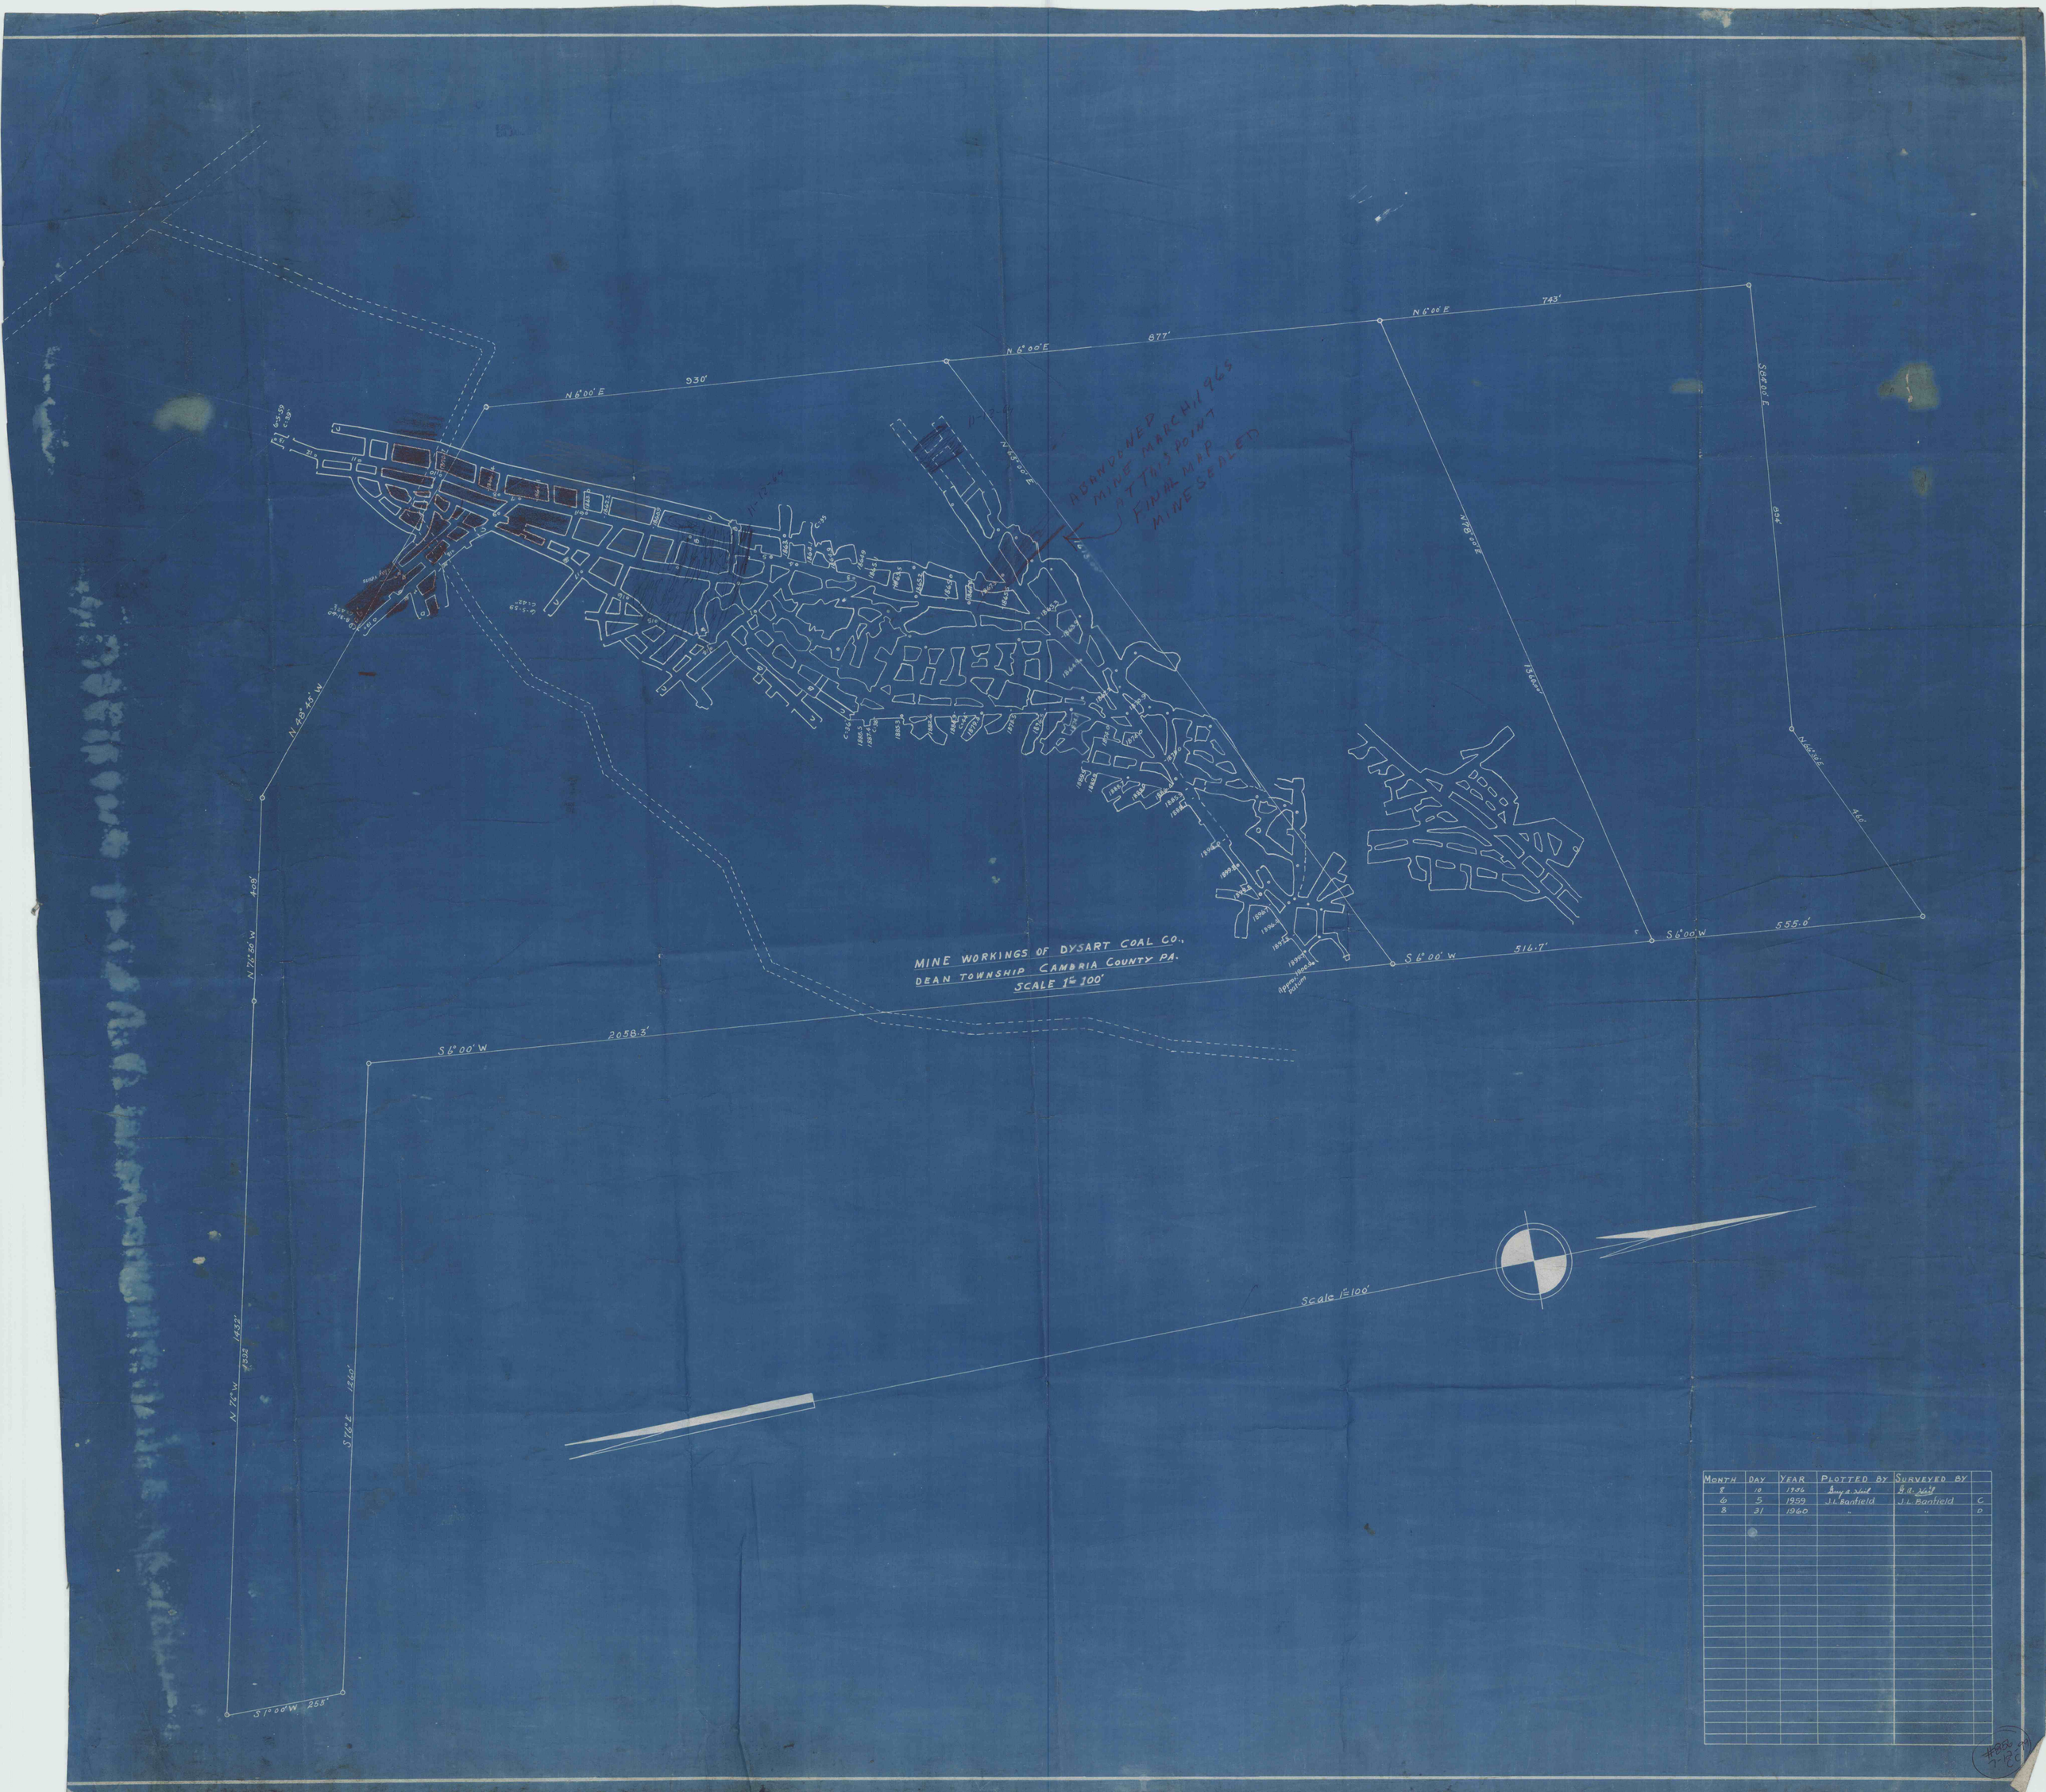

Month	Day	Year	Plotted By	Surveyed By	
8	10	1956	Amy a Weil	B.A. Weil	
6	5	1959	J.L. Banfield	J.L. Banfield	C
8	31	1960	"	"	D

H-88
7-18-79