


-LEGEND-

Upper Airframe outcrop
Mid - " "
Weathered out crop
Faulted/dip slope
Deltas in place - None
Deltas labeled as indicated
Cool drainage - as indicated
Overlying thicknesses - as
indicated - gyps
Spotted Deltas - 3 areas #

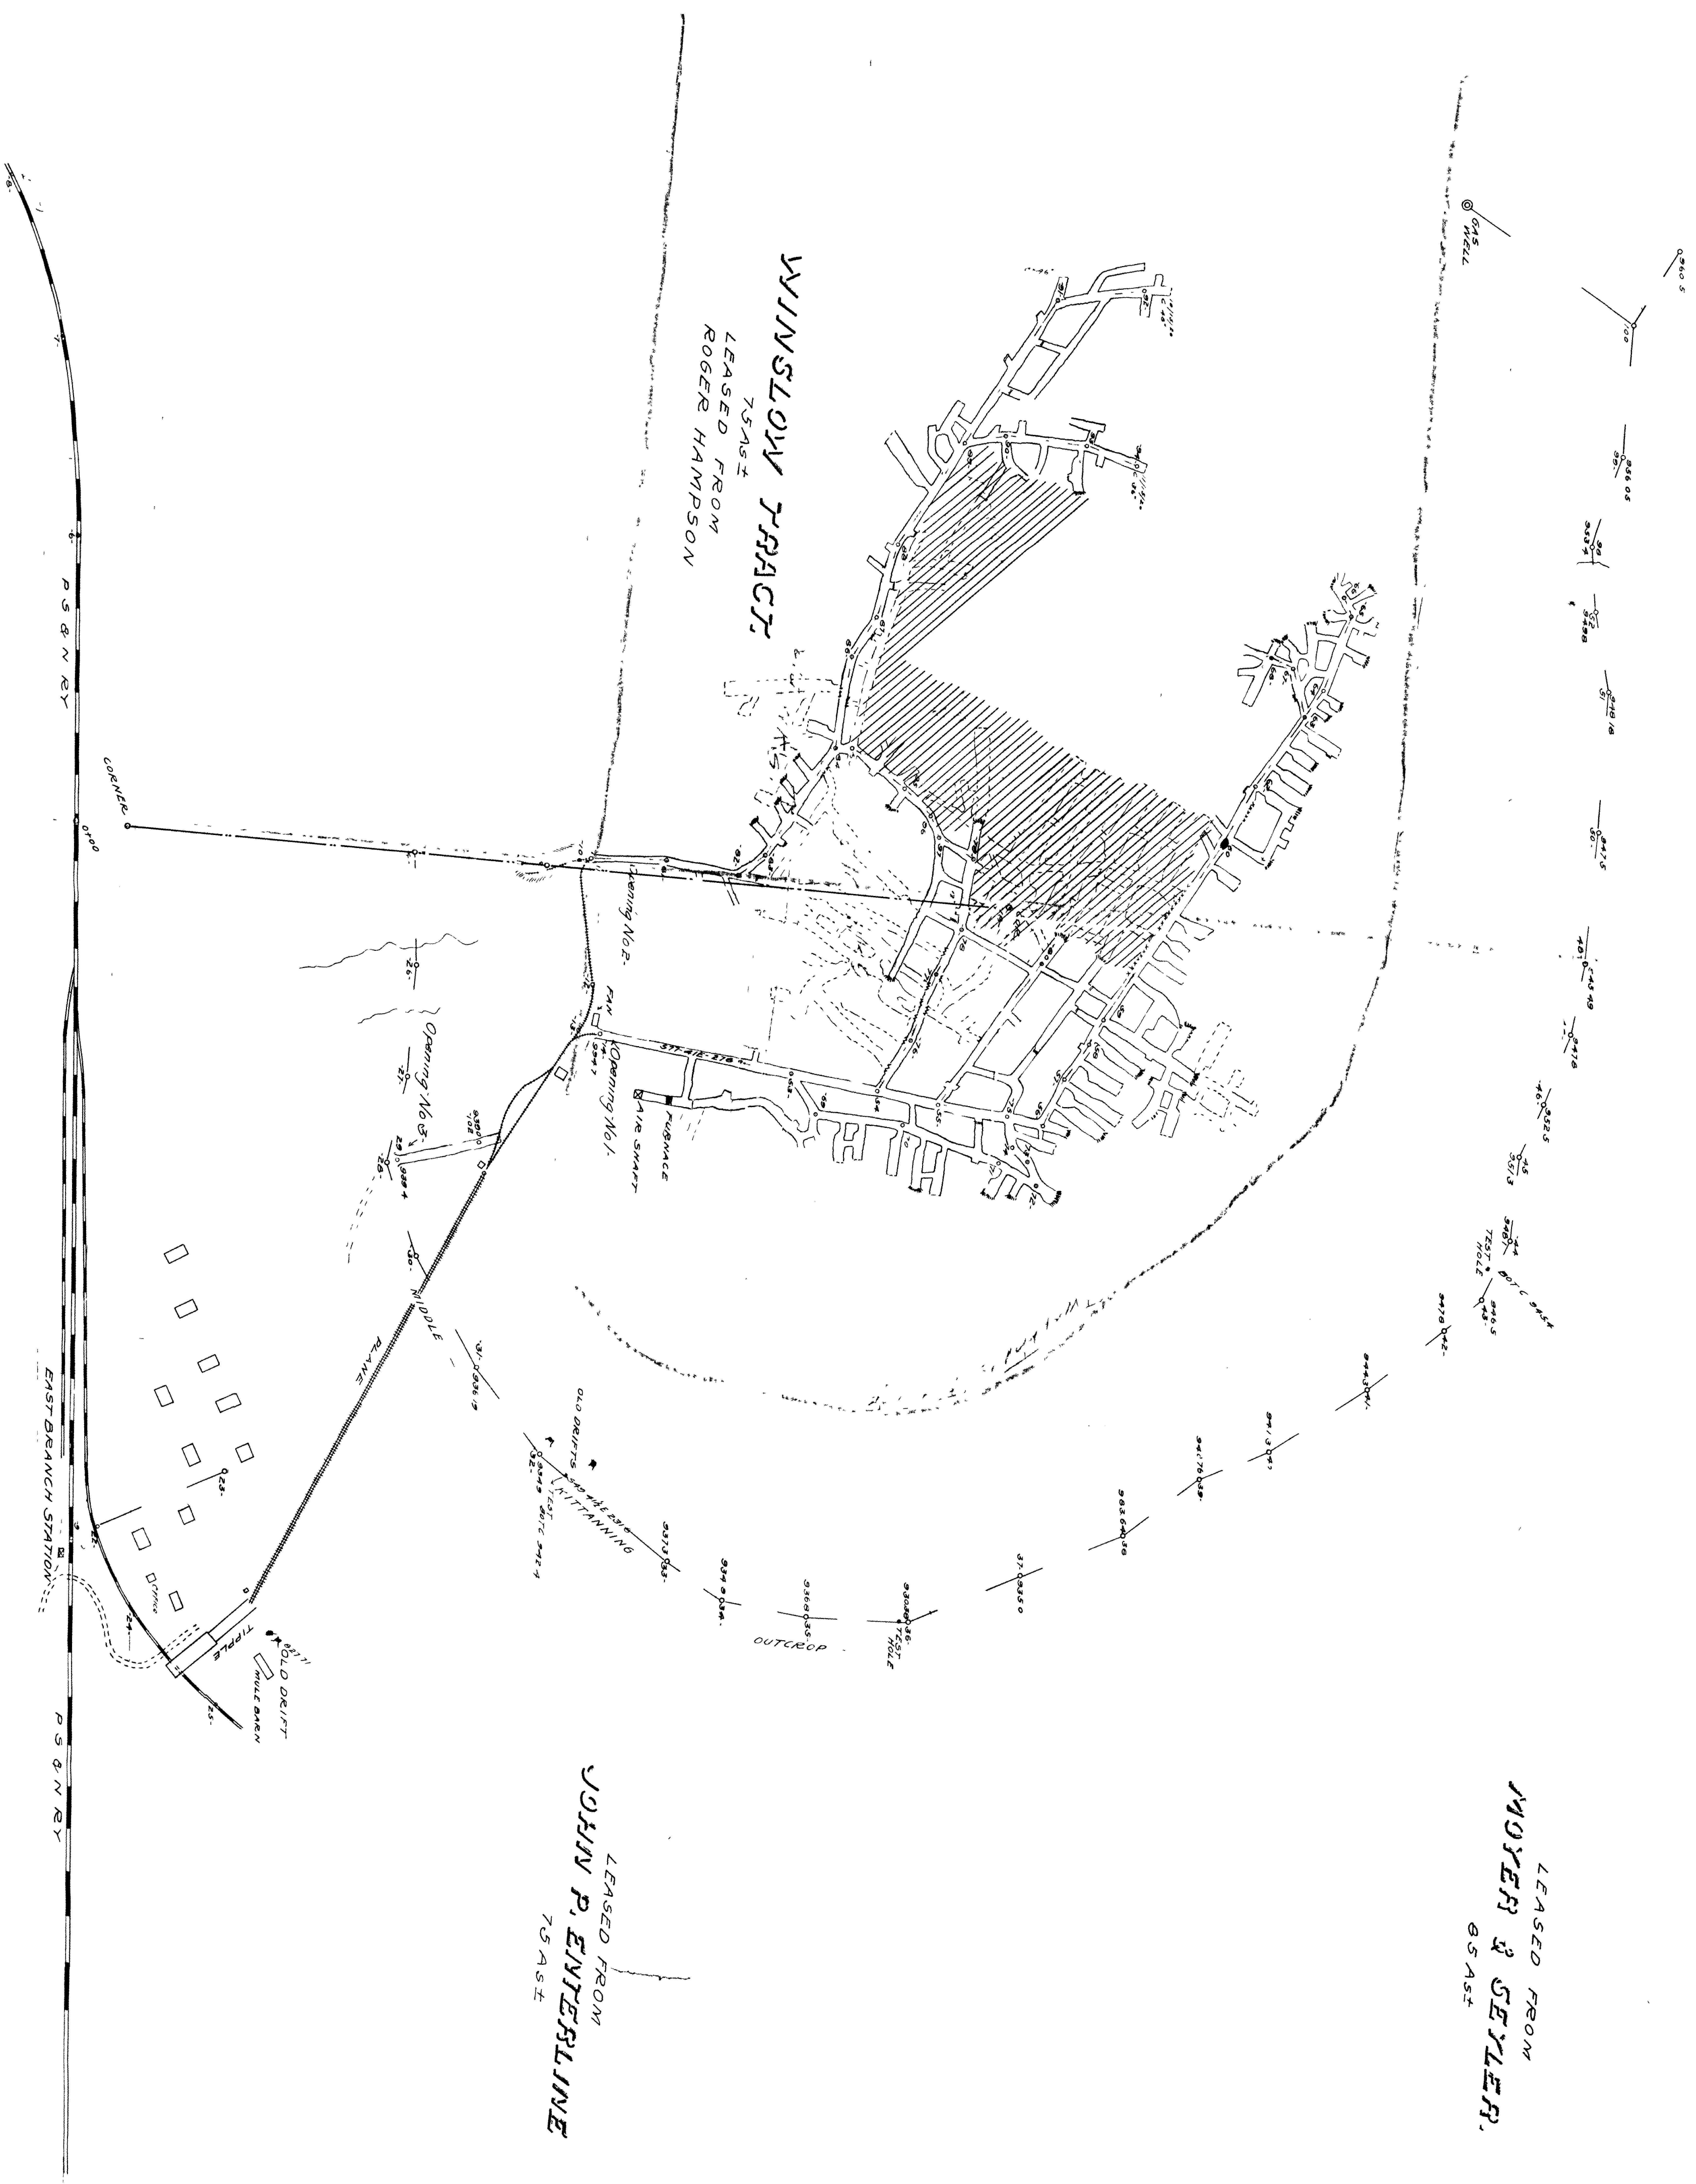

EAST BRANCH COAL CO.
COAL OPERATIONS IN-
OLIVER TWP. JEFFERSON CO. PA.
SCALE=1"=100'

Office of
Eng'r
Mess
Durbin, Pa

Surveyed
Oct. 10, 15, 16, 17

Survey:-
Oct 10-15-1920