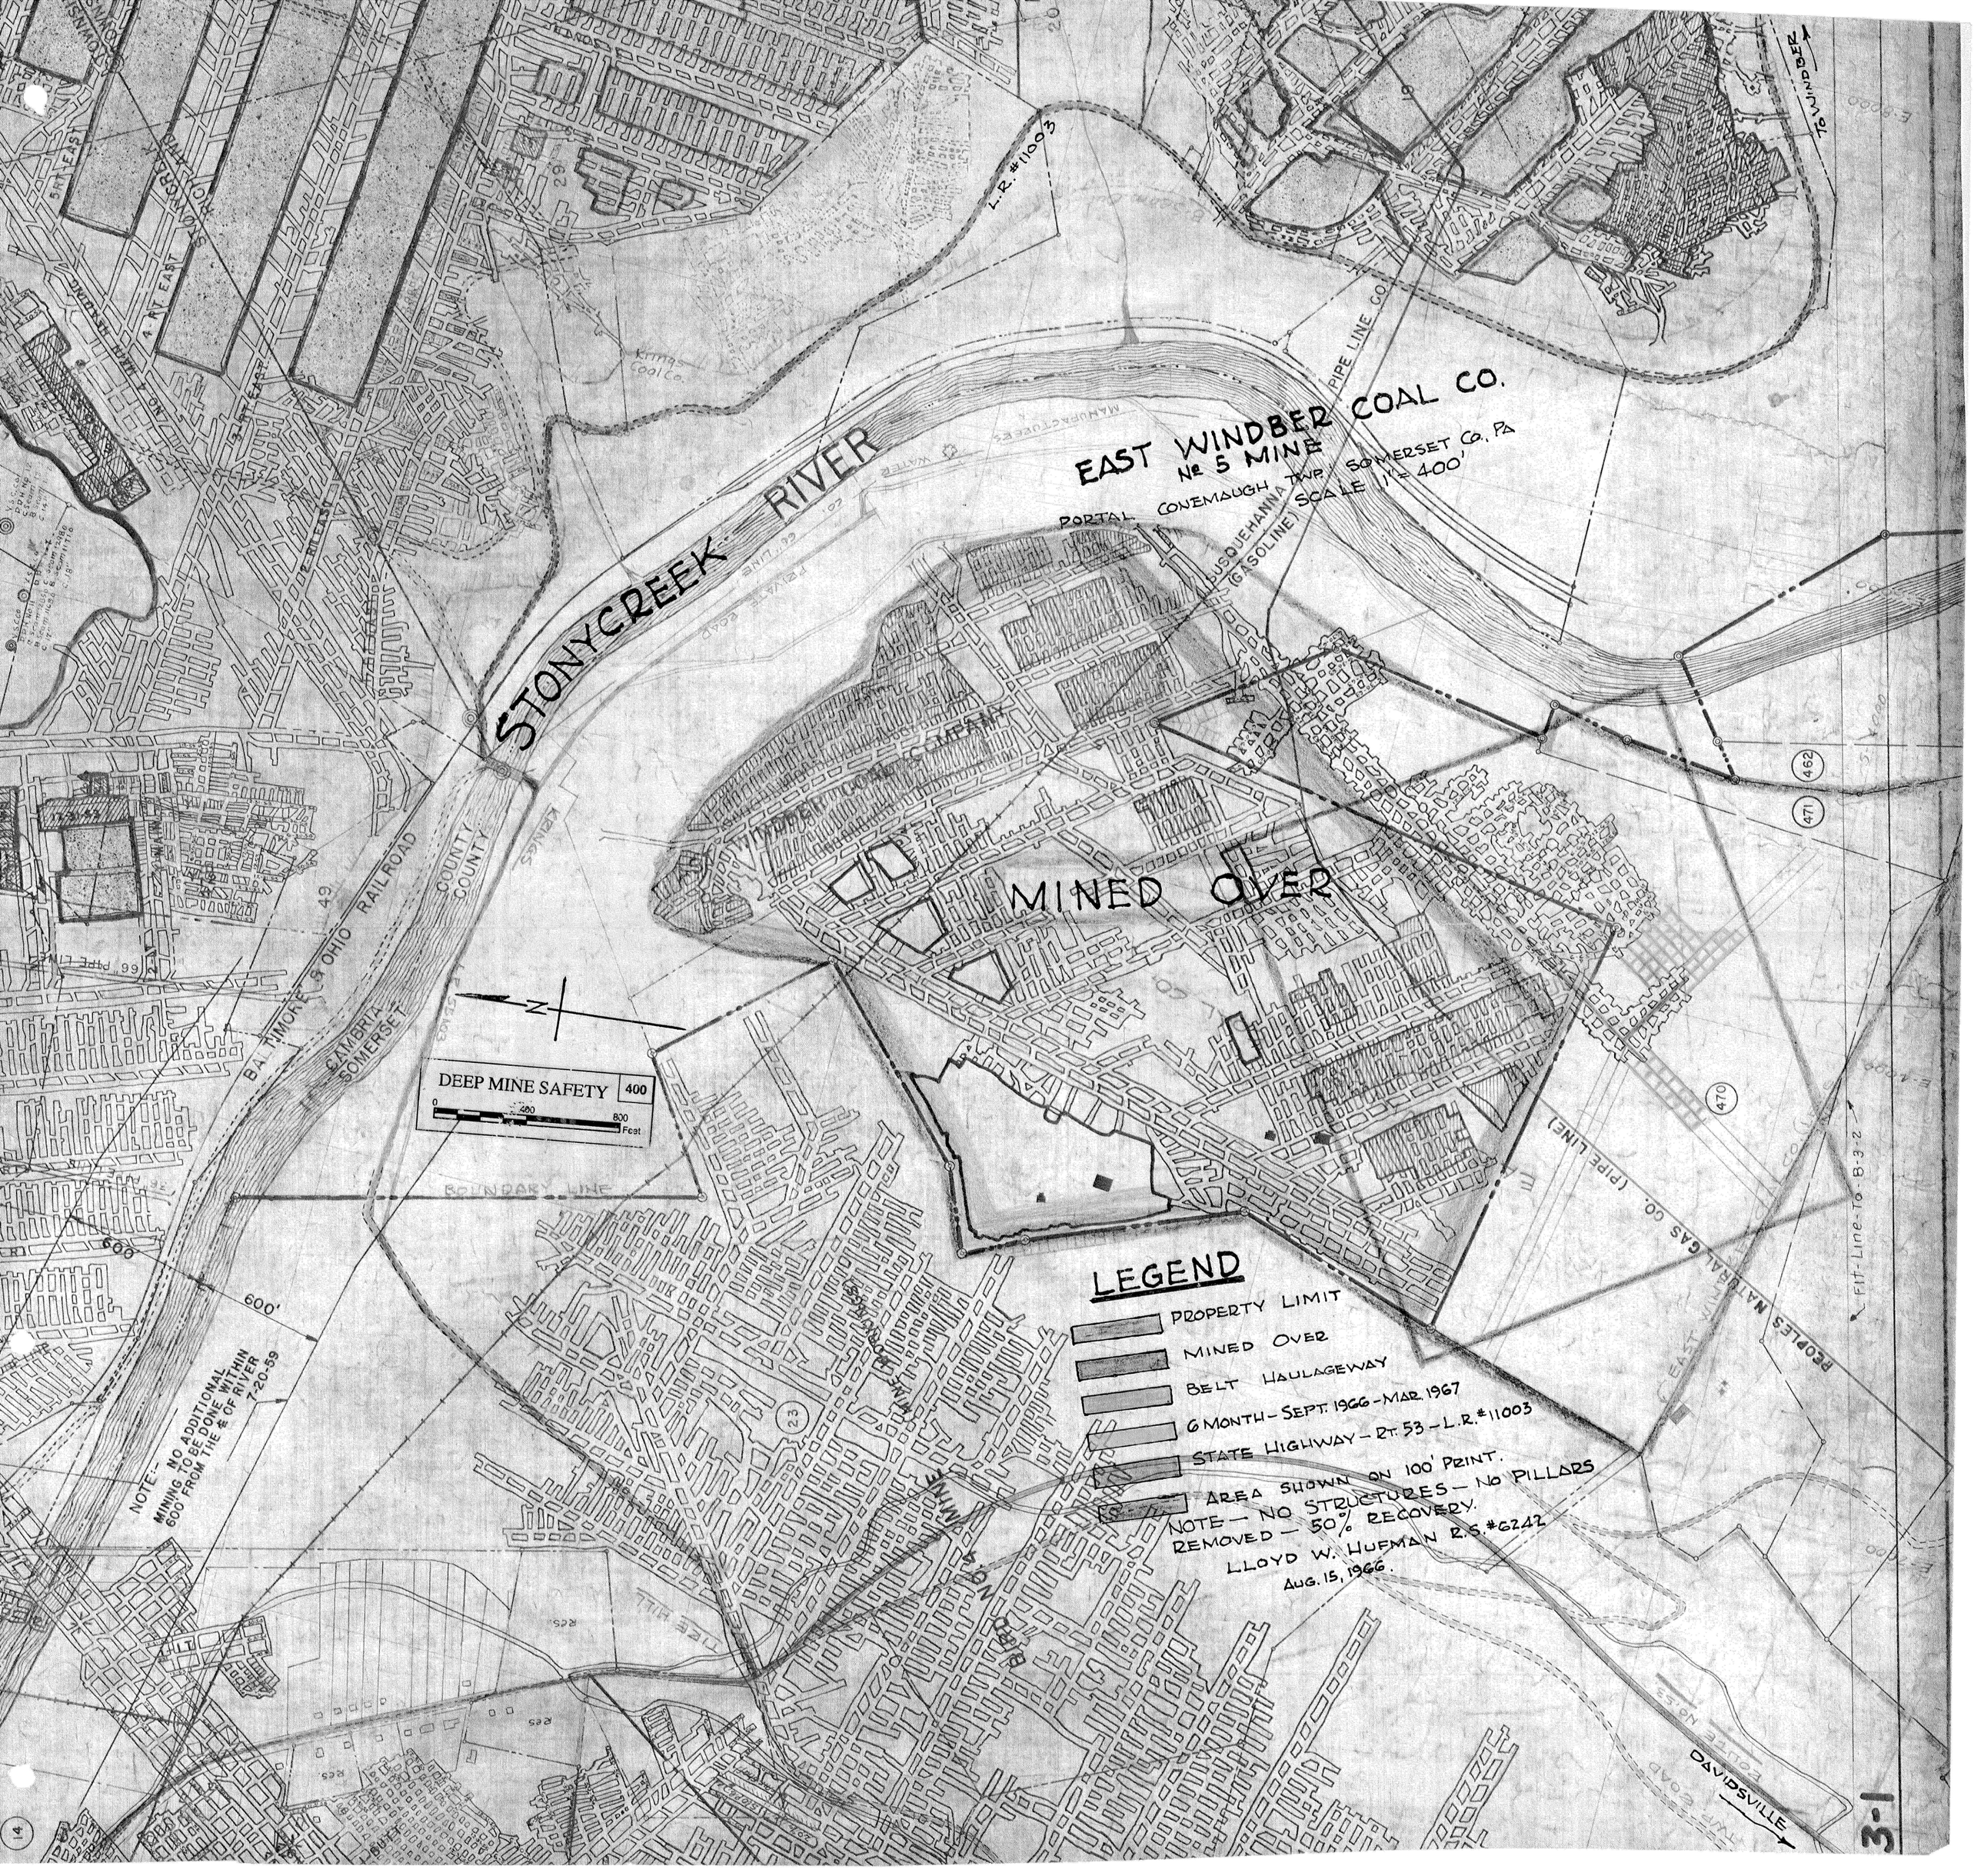

EAST WINDBER COAL CO.
Nº 5 MINE
PORTAL CONEMAUGH TWP. SOMERSET CO. PA
SCALE 1" = 400'
STONYCREEK RIVER
MINED OVER
DEEP MINE SAFETY 400
0 400 800 Feet
BOUNDARY LINE
BALTIMORE & OHIO RAILROAD
CAMBRIA COUNTY
SOMERSET COUNTY
PIPE LINE CO.
SUSQUEHANNA (GASOLINE)
PEOPLES NATURAL GAS CO. (PIPE LINE)
L.R. #11003
TO WINDBER
DAVIDSVILLE
Fit-Line-To-B-3-2
600'
NOTE:- NO ADDITIONAL MINING TO BE DONE WITHIN 600' FROM THE ℄ OF RIVER 7-20-59
LEGEND
PROPERTY LIMIT
MINED OVER
BELT HAULAGEWAY
6 MONTH - SEPT. 1966 - MAR. 1967
STATE HIGHWAY - RT. 53 - L.R. #11003
AREA SHOWN ON 100' PRINT.
NOTE - NO STRUCTURES - NO PILLARS REMOVED - 50% RECOVERY.
LLOYD W. HUFMAN R.S. #6242
AUG. 15, 1966.
3-1