


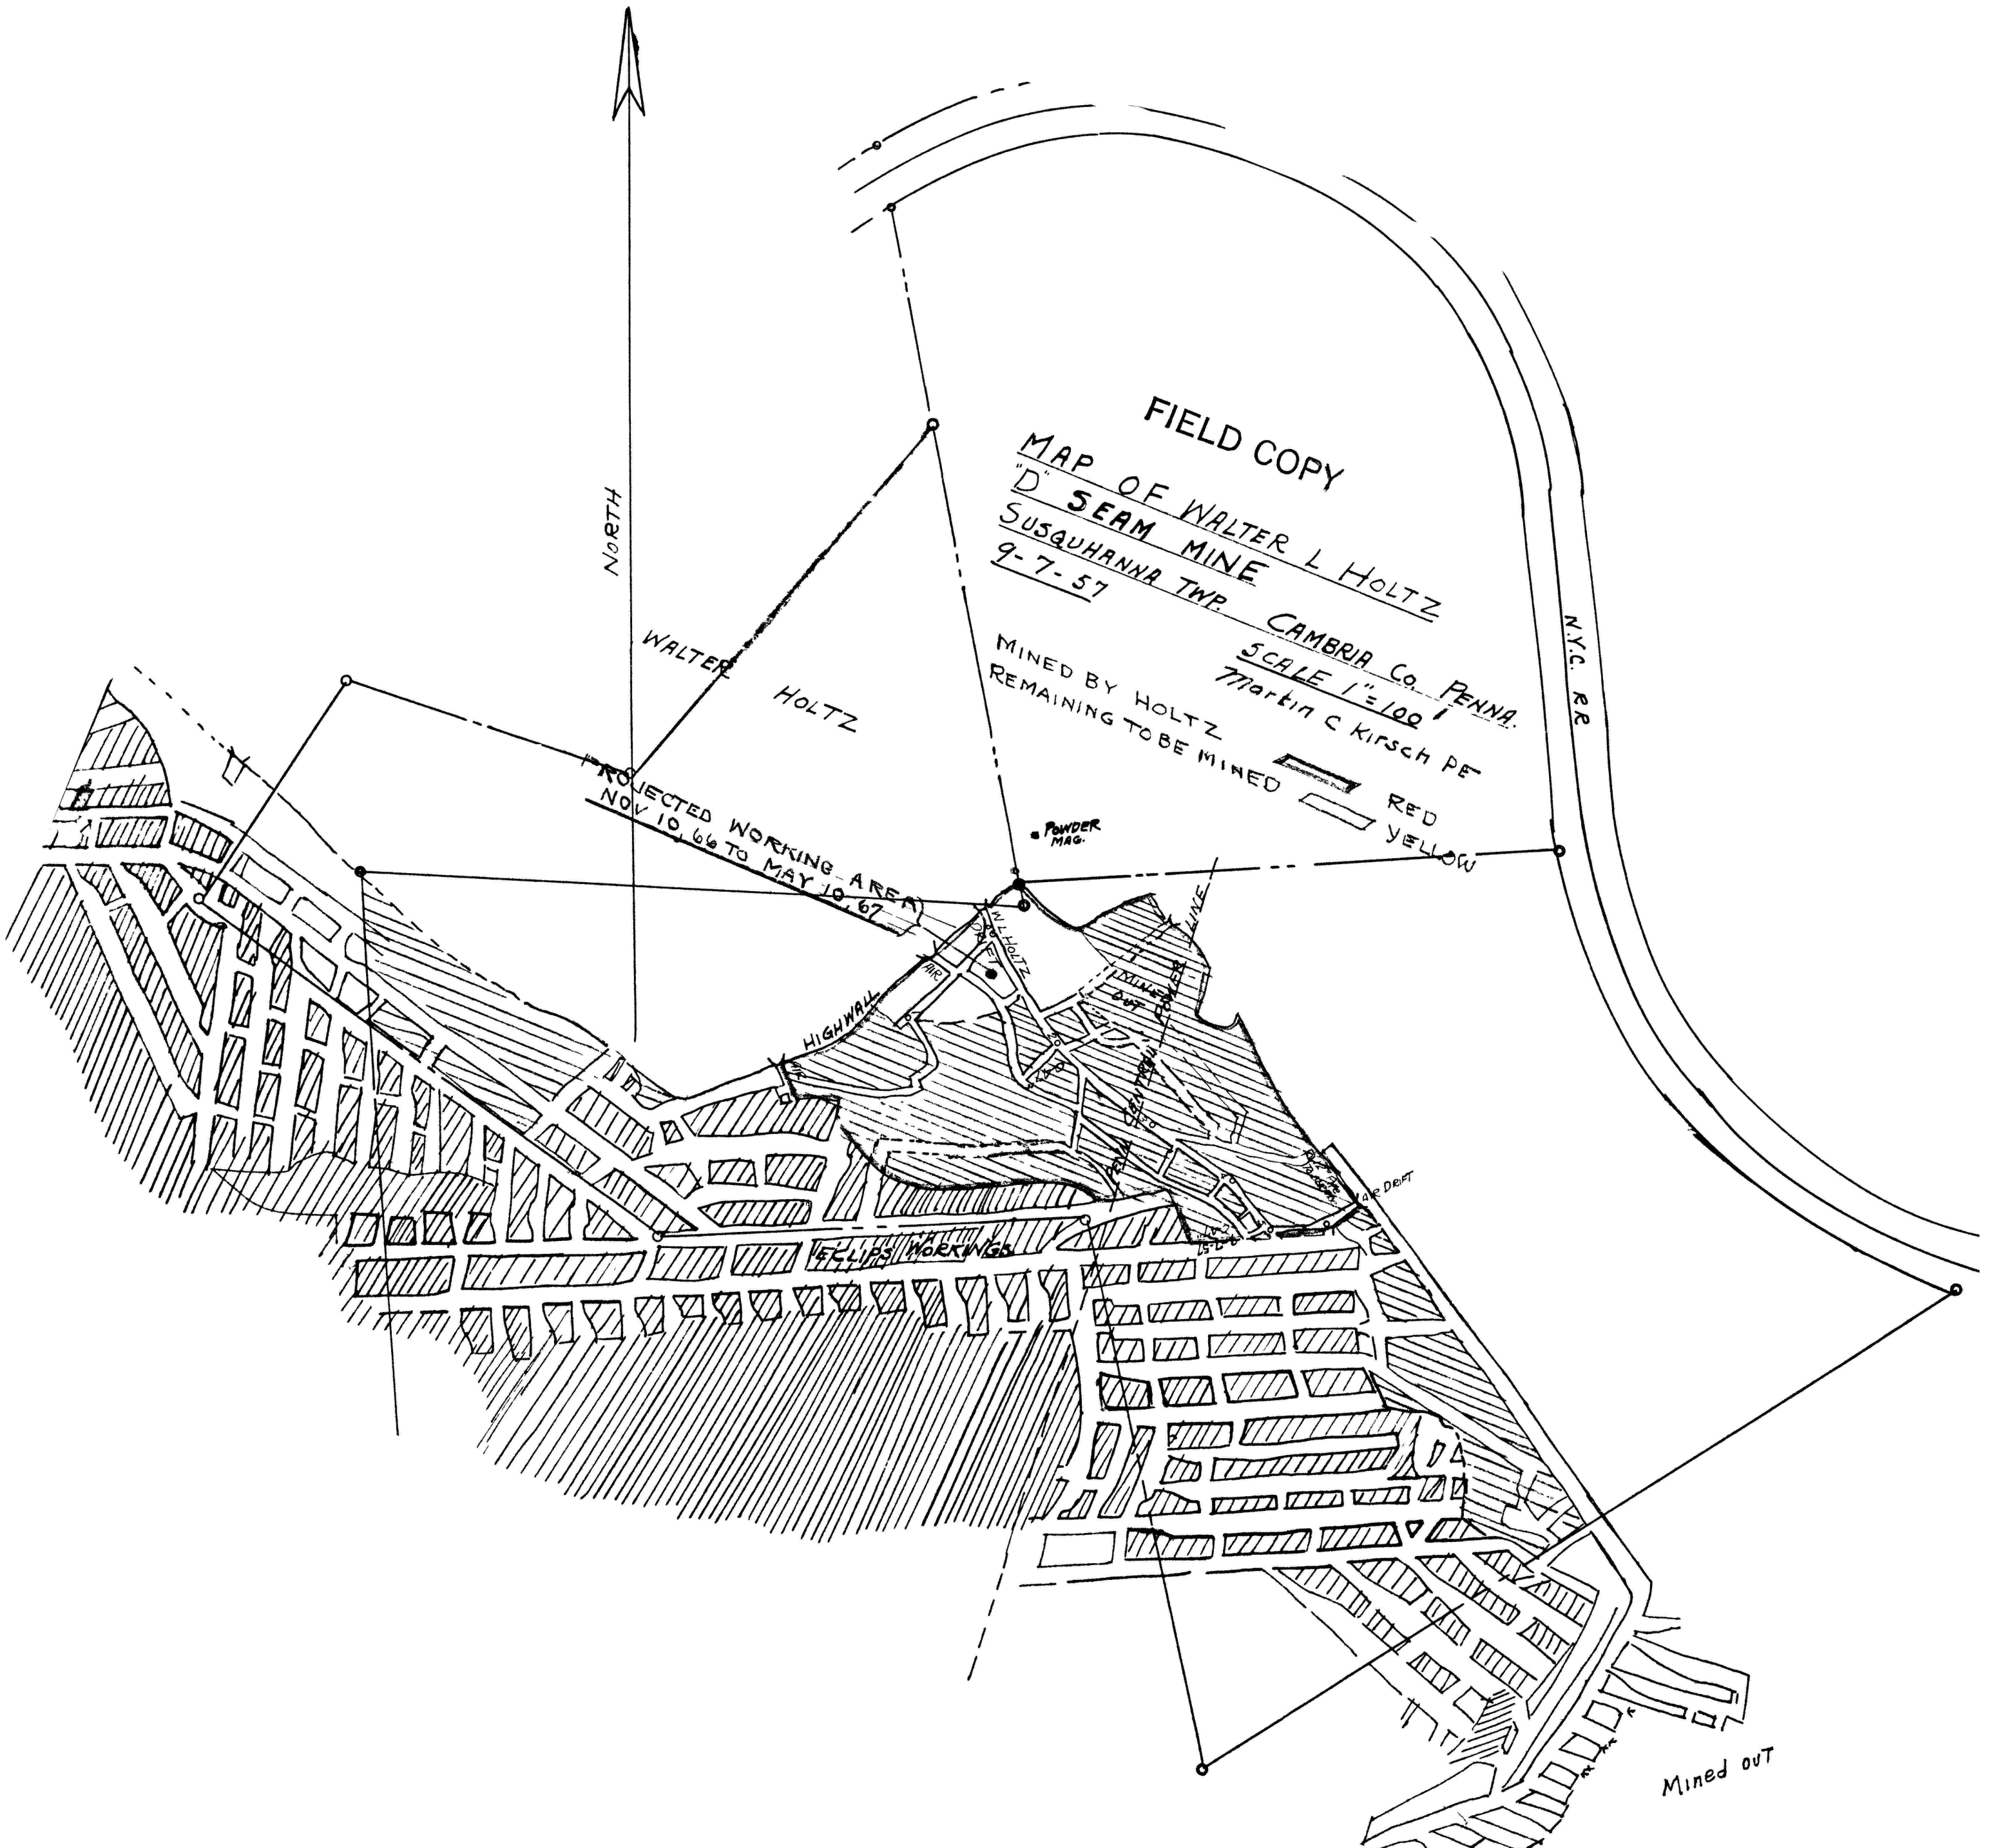

FIELD COPY

MAP OF WALTER L. HOLTZ
"D" SEAM MINE
SUSQUHANNA TWP. CAMBRIA Co. PENNA.
9-7-57

MINED BY HOLTZ
REMAINING TO BE MINED

SCALE 1"=100'
Martin C. Kirsch PE

RED
YELLOW

NORTH

WALTER
HOLTZ

PROJECTED WORKING AREA
NOV 10, 66 TO MAY 10, 67

POWDER
MAG.

HIGHWAY

DRIFT

Mined out

N.Y.C. R.R.