


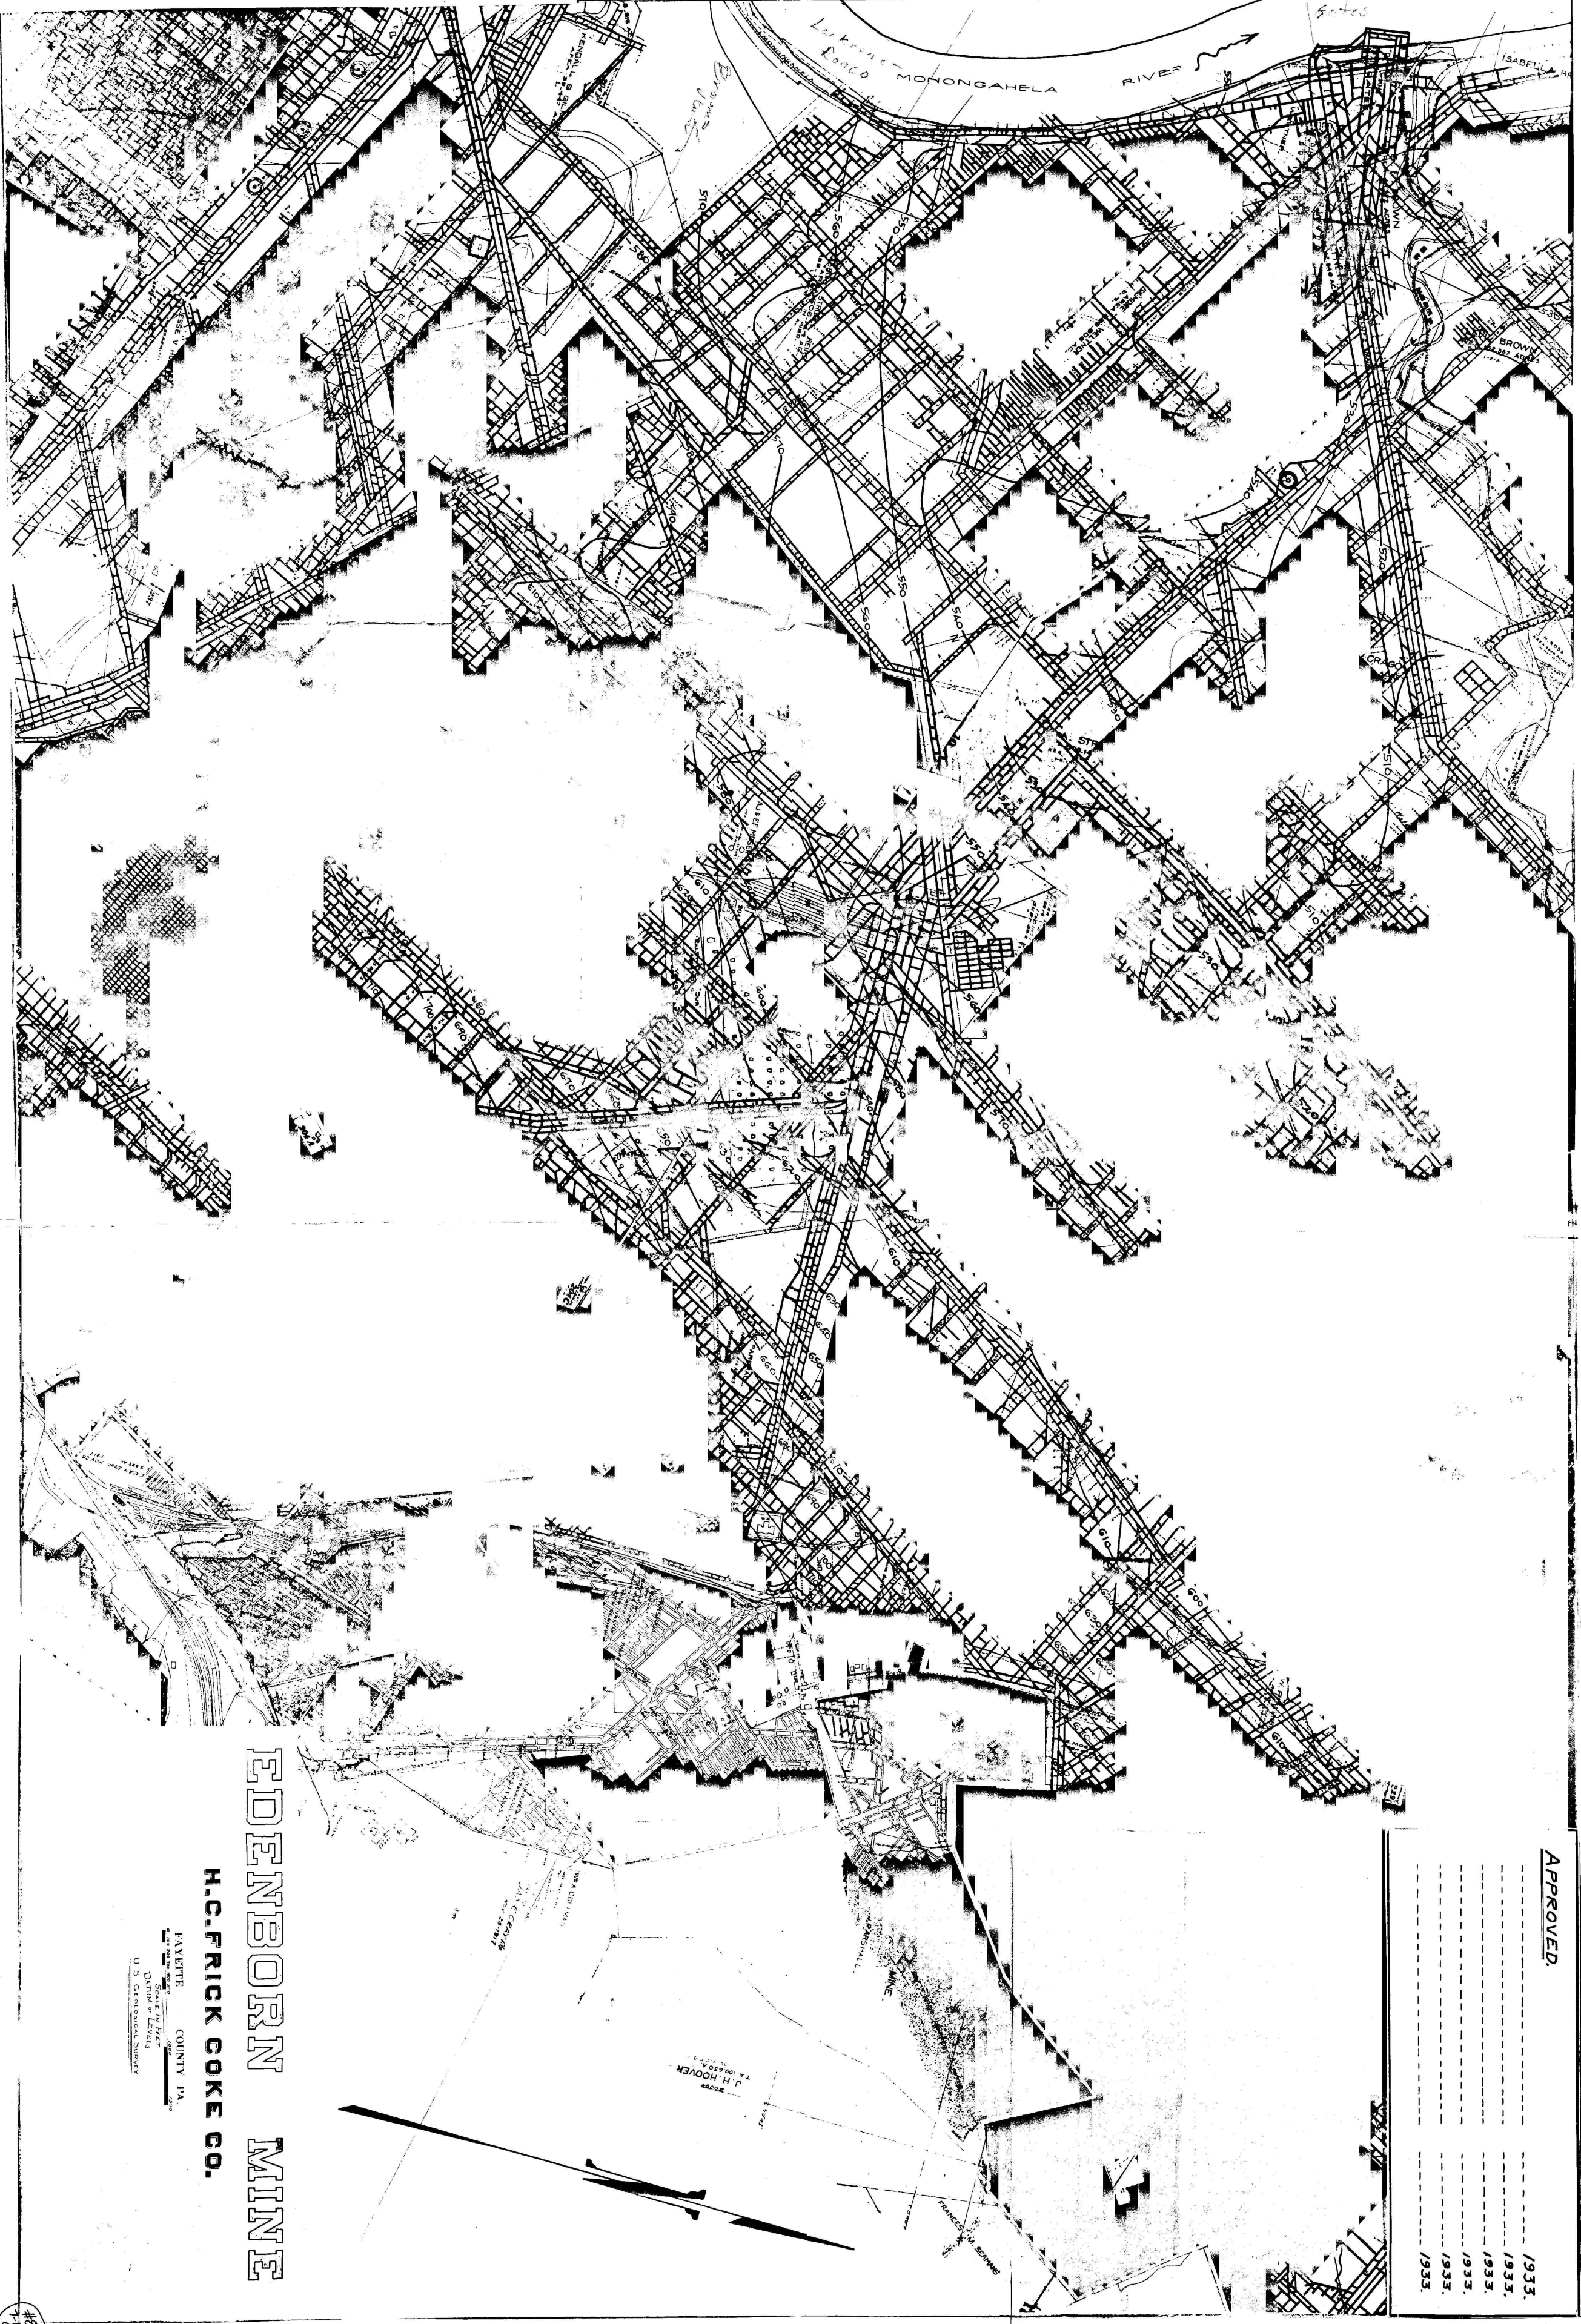

EDENSBORN MINE
H.C. FRICK COKE CO.

U. S. GEOLOGICAL SURVEY

APPROVED.	
1933.	1933.
1933.	1933.
1933.	1933.
