


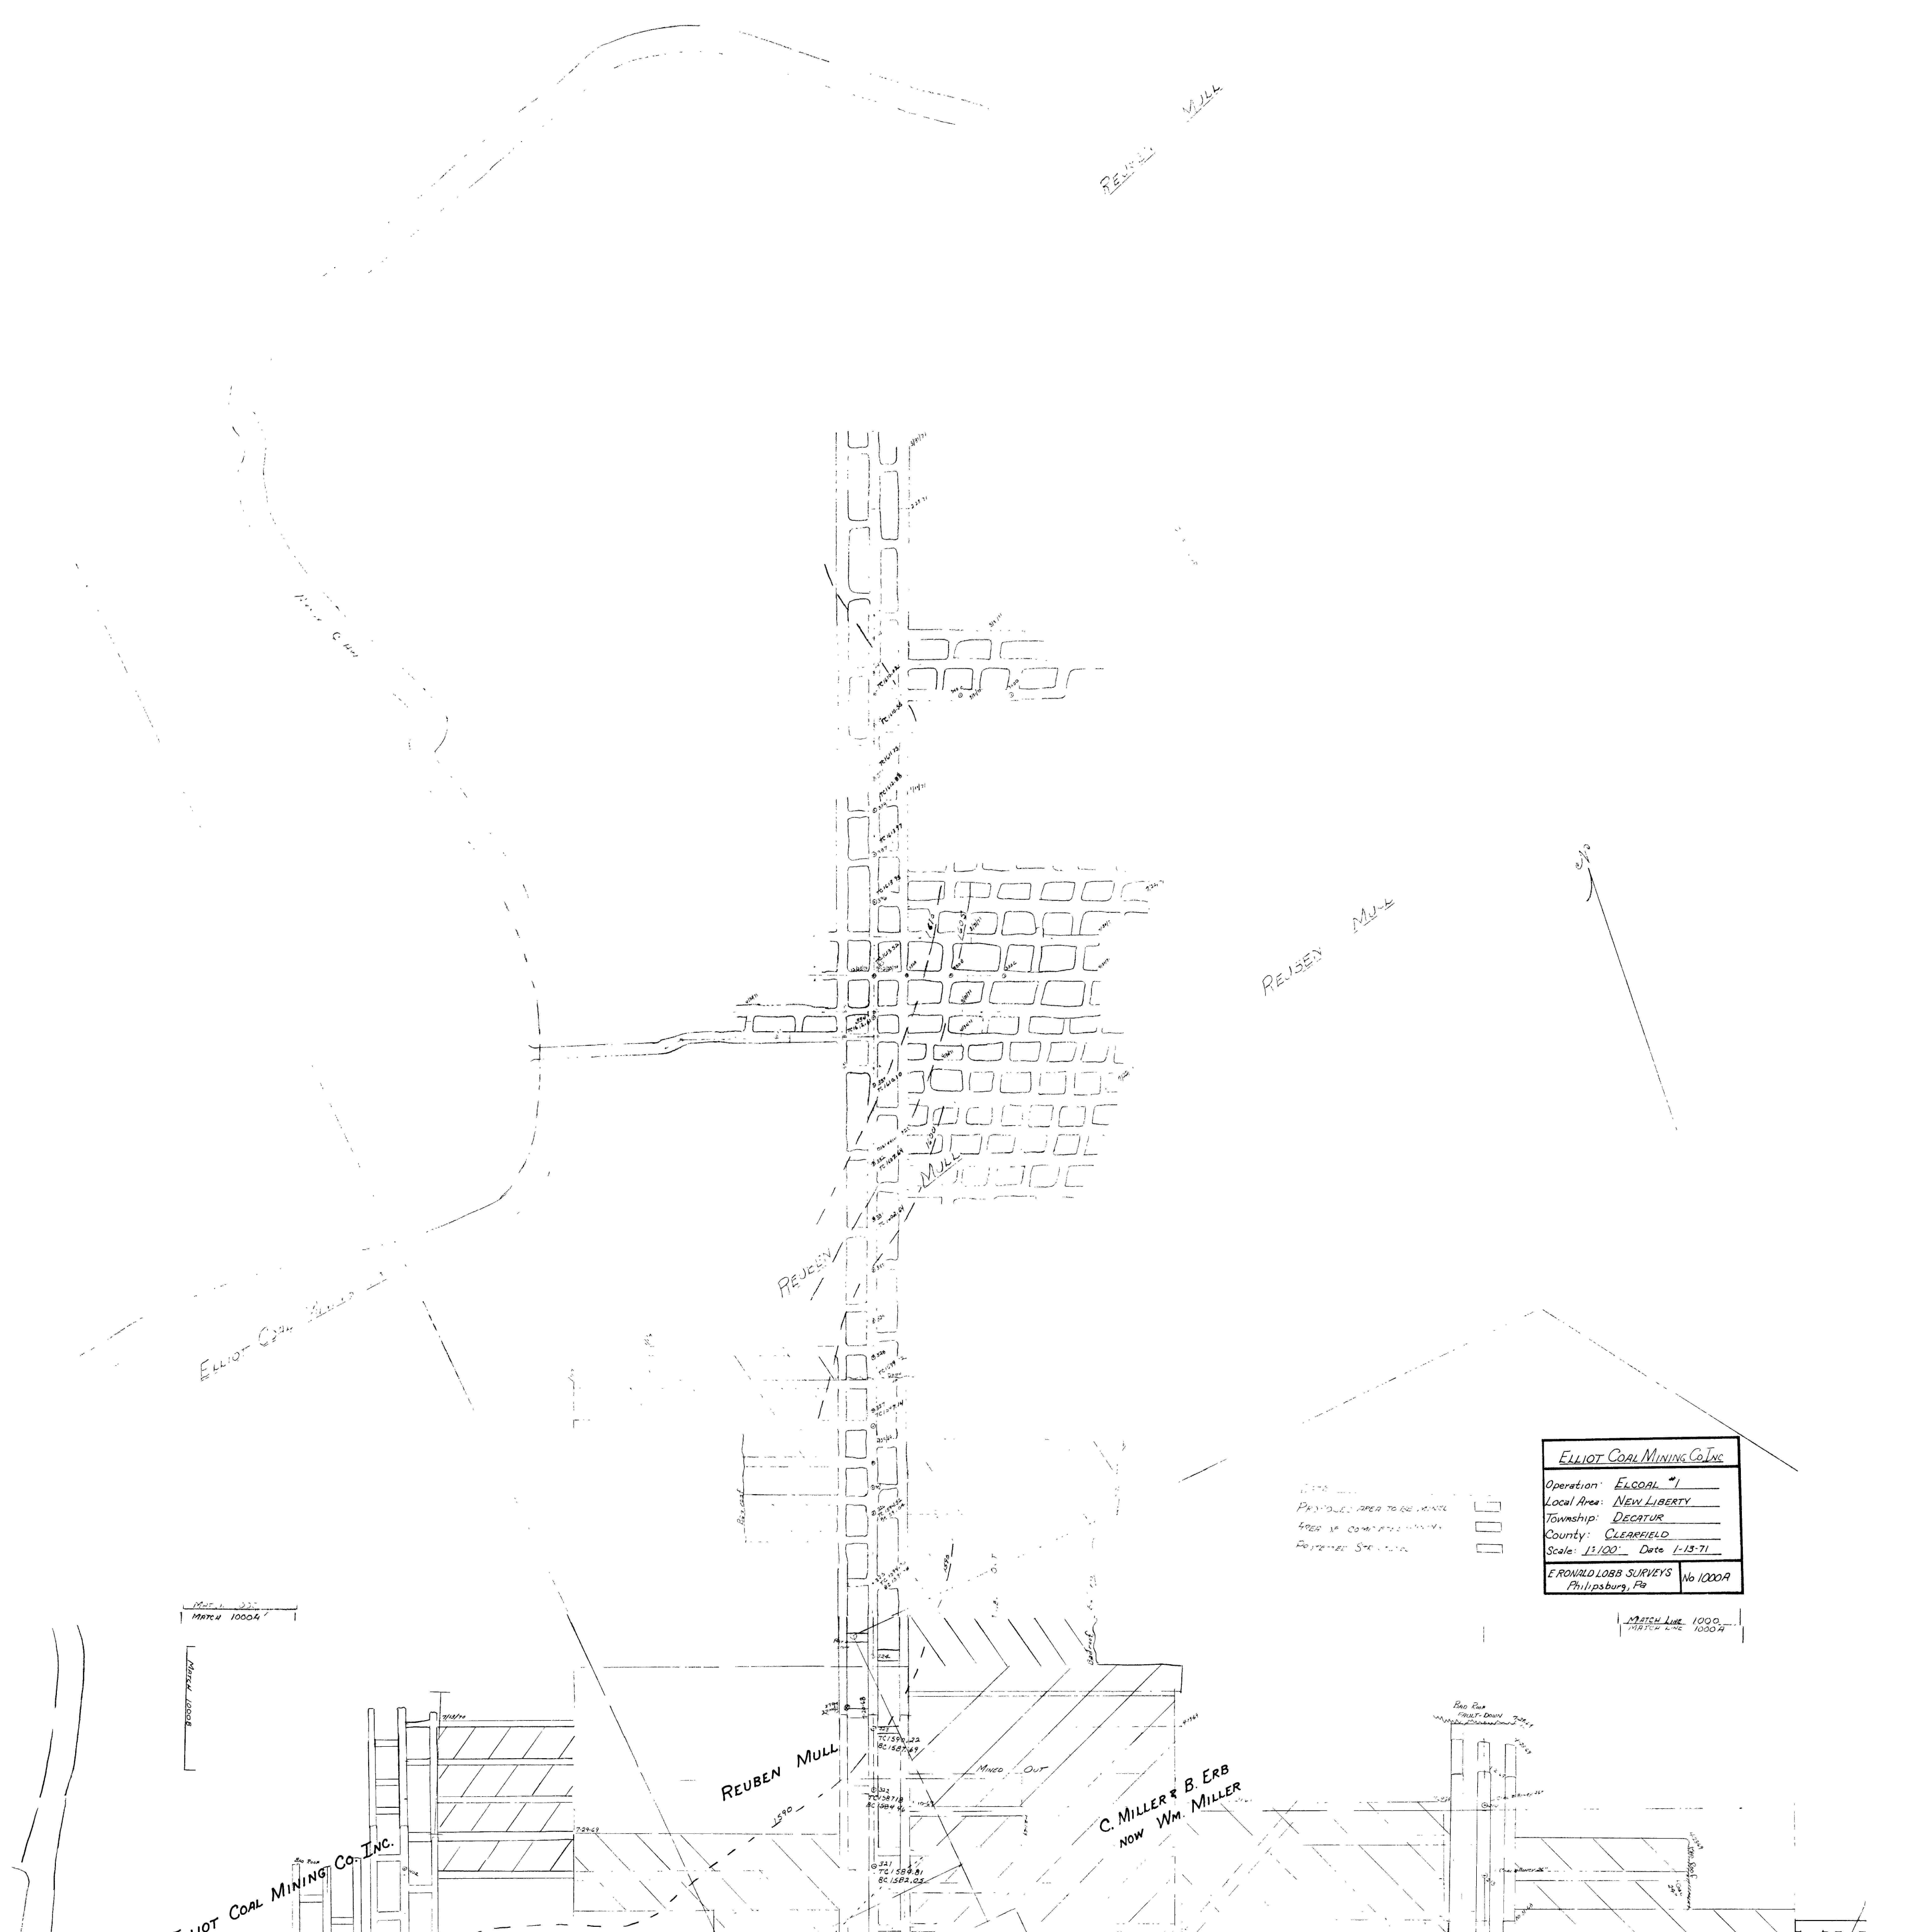

ELLIOT COAL MINING CO. INC.
Operation: ELCOAL #1
Local Area: NEW LIBERTY
Township: DECATUR
County: CLEARFIELD
Scale: 1/100' Date: 1-15-71
ERONALD LOBB SURVEYS No 1000A
Phillipsburg, Pa

1/100' Scale
PROPOSED AREA TO BE MINED
AREA IN COMPLETION
REUBEN MULL

MATCH 1000A

MATCH LINE 1000A

ELLIOT COAL MINING CO. INC.

REUBEN MULL

C. MILLER & B. ERB
NOW WM. MILLER

Bad Rock
Faulted Down

WM